

# SITE DEVELOPMENT PLAN

# U.S. No. 1 JOINT VENTURE


PARCEL "A", PLAT CMP No. 3592, WAREHOUSE

GUILFORD ELECTION DISTRICT No. 6

HOWARD COUNTY, MARYLAND

CENSUS TRACT 6069.02, TAX MAP 47, BLOCK 22/23

WATER CODE C04, SEWER CODE 7220000

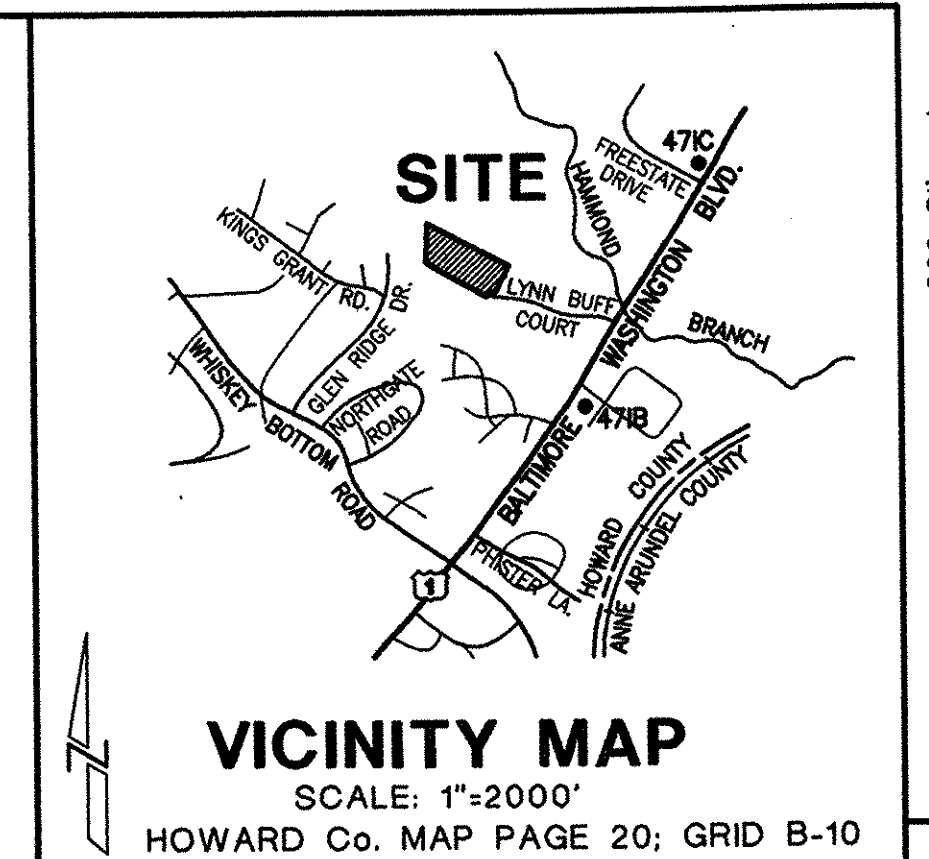

IPDS  
802 Silgo Avenue  
Silver Spring,  
Maryland, 20910  
(301) 585-5676  
The Interprofessional  
PLANNING & DESIGN STUDIO, LLC  
Engineers • Architects • Surveyors  
Planners & Landscape Architects

## SITE TABULATION

PRESENT ZONING	M-1
DEED REFERENCE	L. 454, F. 036
AREA OF PARCEL	7.527 Ac.
PROPOSED USE	WAREHOUSING & PARKING
PROPOSED BUILDING COVERAGE	115,463 SQ. FT.
PROJECTED No. OF EMPLOYEES	50

### TOTAL PARKING SPACES REQUIRED:

0.5 SPACES PER 1000 SF OF 115,463 SQUARE FEET GROSS FLOOR AREA	58
3.3 SPACES PER 1000 SF OF 40,909 SQUARE FEET MAX. ALLOWABLE MEZZANINE FLOOR AREA (FUTURE GENERAL OFFICE USE)	135
TOTAL REQUIRED	193

### TOTAL PARKING SPACES PROVIDED:

STANDARD (8'x18')	164
COMPACT (8'x16')	23
HANDICAPPED (8'x20')	6
TOTAL SPACES	193
LOADING SPACES	29
LANDSCAPE ISLANDS REQUIRED:	10
1/20 PARKING SPACES	
MINIMUM 200 SF EACH	2000 SF
MINIMUM WIDTH = 12'	

DISTURBED AREA 5.7 Ac. (76%)

PARCEL "A" PLAT FILE NUMBER IS F-75-67

NOTE: THIS PLAN WAS PREVIOUSLY SUBMITTED AS SDP-98-BB AND DENIED ON 5/6/98

### OWNER / DEVELOPER

Joseph Nazario  
Nazario Development and Company  
6500 Ammendale Road  
Beltsville, Maryland 20705  
(301) 937-4664

## SDP-98-135

### ADDRESS CHART

BUILDING	STREET ADDRESS
9590	LYNN BUFF COURT

SUBDIVISION NAME: U.S. No. 1 JOINT VENTURE				SECT./AREA: N/A		PARCEL: A			
DEED: PLAT 3592		BLOCK: 22/23	ZONING: M-1	TAX MAP No.: 47		ELECTION DISTRICT: 6th		CENSUS TRACT: 6069.02	
WATER CODE: C04				SEWER CODE: 7220000					

COVER SHEET

U.S. No. 1 JOINT VENTURE  
PARCEL "A", PLAT CMP No. 3592, WAREHOUSE  
GUILFORD ELECTION DISTRICT No. 6  
HOWARD COUNTY, MARYLAND  
CENSUS TRACT 6069.02, TAX MAP 47, BLOCK 22/23  
WATER CODE C04, SEWER CODE 7220000

NONE

06-22-98

01-18-98

DATE:

JOB NUMBER:

CS

SHEET 1 OF 13


SDP-98-135

## LIST OF DRAWINGS

CS	COVER SHEET (1 of 13)
SDP-1	SITE DEVELOPMENT PLAN (2 of 13)
SDP-2	SITE DETAILS (3 of 13)
SDP-3	SITE DETAILS (4 of 13)
SDP-4	FRONT BUILDING ELEVATION AND BUILDING PROFILES (5 of 13)
LA-1	LANDSCAPING PLAN (6 of 13)
DA-1	DRAINAGE AREA MAPS (7 of 13)
SWM-1	STORMWATER MANAGEMENT PLAN (8 of 13)
SWM-2	DETAILS & STORM DRAIN PROFILES (9 of 13)
SWM-3	STORMWATER MANAGEMENT DETAILS (10 of 13)
SC-1	EROSION & SEDIMENT CONTROL PLAN (11 of 13)
SC-2	EROSION AND SEDIMENT CONTROL DETAILS & NOTES (12 of 13)
S-1	SOILS AND ENVIRONMENTAL ANALYSIS (13 of 13)

## GENERAL NOTES


- ALL CONSTRUCTION SHALL BE IN ACCORDANCE WITH THE LATEST STANDARDS AND SPECIFICATIONS OF HOWARD COUNTY PLUS MSHA STANDARDS AND SPECIFICATIONS IF APPLICABLE.
- THE CONTRACTOR SHALL NOTIFY THE DEPARTMENT OF PUBLIC WORKS, BUREAU OF ENGINEERING, AND CONSTRUCTION INSPECTION DIVISION AT 410-313-1880 AT LEAST FIVE (5) WORKING DAYS PRIOR TO THE START OF WORK.
- THE CONTRACTOR SHALL NOTIFY "MISS UTILITY" AT 1-800-257-7777 AT LEAST 48 HOURS PRIOR TO ANY EXCAVATION WORK BEING DONE.
- TRAFFIC CONTROL DEVICES, MARKINGS, AND SIGNING SHALL BE IN ACCORDANCE WITH THE LATEST EDITION OF THE MANUAL OF UNIFORM TRAFFIC CONTROL DEVICES (MUTCD). ALL STREET AND REGULATORY SIGNS SHALL BE IN PLACE PRIOR TO THE PLACEMENT OF ANY ASPHALT.
- ALL PLAN DIMENSIONS ARE TO FACE OF CURB UNLESS OTHERWISE NOTED. THE EXISTING TOPOGRAPHY IS TAKEN FROM FIELD RUN SURVEY WITH TWO FOOT CONTOUR INTERVALS PREPARED BY JOYCE ENGINEERING CORPORATION, DATED OCTOBER, 1987.
- THE COORDINATES SHOWN HEREON ARE BASED UPON THE HOWARD COUNTY GEODETIC CONTROL WHICH IS BASED UPON THE MARYLAND STATE PLANE COORDINATE SYSTEM. HOWARD COUNTY MONUMENT NOS. 47B AND 47C WERE USED FOR THIS PROJECT.
- WATER IS PUBLIC, EX. WHC. CONTRACT No. 667-D-W&S.
- SEWER IS PUBLIC, EX. SHC. CONTRACT No. 667-D-W&S.
- STORMWATER MANAGEMENT CONTROL IS TO BE PROVIDED BY PRIVATE UNDERGROUND STORAGE PIPES WITH INFILTRATION TRENCHES AND WILL BE MAINTAINED BY THE OWNER OF PROPERTY.
- THERE IS NO FLOODPLAIN ON SITE.
- THERE ARE NO WETLANDS ON THIS SITE.
- NO TRAFFIC STUDY IS REQUIRED FOR THIS PROJECT.
- ALL INLETS SHALL BE CONSTRUCTED IN ACCORDANCE WITH HOWARD COUNTY STANDARDS.
- ALL PIPE ELEVATIONS SHOWN ARE INVERT ELEVATIONS.
- THE CONTRACTOR SHALL PROVIDE A JOINT IN ALL SEWER MAINS WITHIN 2'-0" OF EXTERIOR MANHOLE WALLS.
- PROFILE STATIONS SHALL BE ADJUSTED AS NECESSARY TO CONFORM TO PLAN DIMENSIONS.
- NO PIPE SHALL BE Laid UNTIL LINES OF EXCAVATION HAVE BEEN BROUGHT TO SUBGRADE.
- ALL STORM DRAIN PIPE BEDDING SHALL BE AS SHOWN IN DETAIL G2.01 (TRENCH IN ROCK OR TRENCH IN EARTH AS DETERMINED BY FIELD CONDITIONS) IN VOL. IV. OF HOWARD COUNTY DESIGN MANUAL UNLESS OTHERWISE DIRECTED BY THE ENGINEER OR AS SHOWN ON THE DRAWINGS.
- THE DEVELOPER IS RESPONSIBLE FOR THE ACQUISITION OF ALL EASEMENTS, RIGHTS-OF-WAY THAT MAY BE REQUIRED FOR THE SEDIMENT AND EROSION CONTROL PRACTICES, STORM WATER MANAGEMENT PRACTICES AND THE DISCHARGE OF STORM WATER ONTO OR ACROSS ADJACENT OR DOWNSTREAM PROPERTIES INCLUDED IN THIS PLAN. HE IS ALSO RESPONSIBLE FOR THE ACQUISITION OF ALL EASEMENTS, RIGHTS-OF-WAY AND/OR WORK ON ADJACENT PROPERTIES INCLUDED IN THIS PLAN.
- THE OWNER SHALL PROVIDE A SEPARATE AND INDEPENDENT SEWER CONNECTION FOR EACH TENANT OR OCCUPANT OF ANY BUILDING, SHOWN ON THIS SITE DEVELOPMENT PLAN, WHO WILL DISCHARGE NON-DOMESTIC WASTE TO THE PUBLIC SEWERAGE SYSTEM. IF THIS WASTE IS REGULATED UNDER SECTION 16.122A OF THE HOWARD COUNTY CODE, EACH SEPARATE AND INDEPENDENT SEWER CONNECTION SHALL INCLUDE A STANDARD MANHOLE AND OTHER WATER PRETREATMENT DEVICES AS REQUIRED AND APPROVED BY HOWARD COUNTY. WASTE LINES ON THE INTERIOR OF THE BUILDING SHALL BE DESIGNED, CONSTRUCTED OR MODIFIED SUCH THAT NON-DOMESTIC WASTE WILL BE DISCHARGED TO THE SEPARATE AND INDEPENDENT SEWER CONNECTION. NO PLAN SHALL DISCHARGE REGULATED NON-DOMESTIC WASTE TO PUBLIC SEWERAGE SYSTEM PRIOR TO INSTALLATION OF THE SEPARATE AND INDEPENDENT SEWER CONNECTION AND RELATED INTERIOR WASTE LINES. THE ABOVE REQUIREMENTS SHALL APPLY TO ALL INITIAL AND FUTURE OCCUPANTS OR TENANTS.
- ALL IMPROVEMENTS AS SHOWN ON THESE PLANS WITHIN THE R/W OF LYNN BUFF COURT WILL BE THE RESPONSIBILITY OF THE DEVELOPER.
- ALL EXTERIOR LIGHTING SHALL CONFORM TO SECTION 134 - OUTDOOR LIGHTING, ZONING REGULATIONS.
- NO UNDERGROUND/GROUNDWATER TESTING CONDUCTED FOR THE PRESENCE OF CONTAMINANTS AT THIS TIME.
- WATER METERS SHALL BE LOCATED OUTSIDE THE BUILDING IN THE AREA BETWEEN THE SIDEWALK AND THE PARKING LOT CURB.

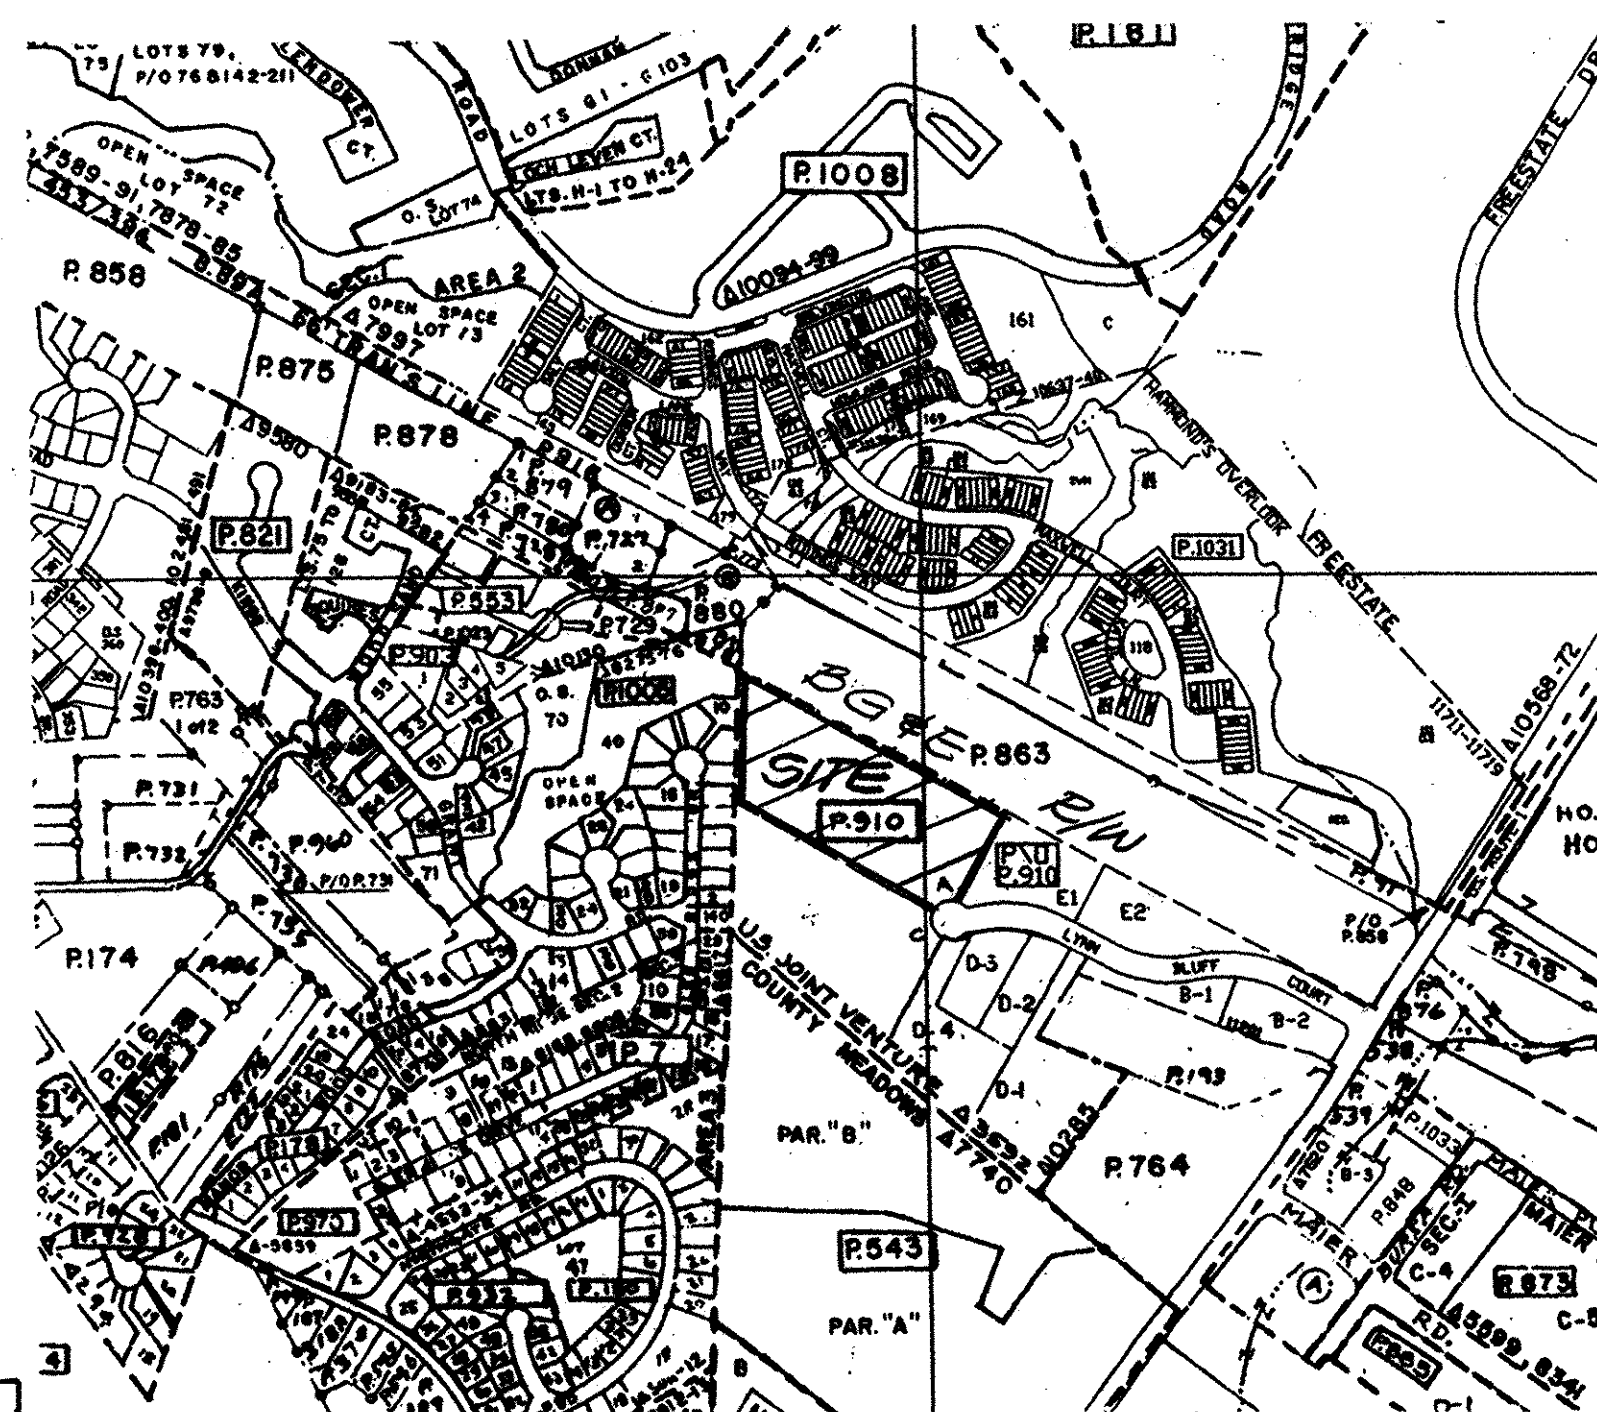

## TAX MAP

SCALE: 1"=600'


HOWARD COUNTY GEODETIC CONTROL:	47IB	HOWARD COUNTY GEODETIC CONTROL:	47IC
NGS FID NUMBER:	N/A	NGS FID NUMBER:	N/A
Coordinate level:	47IB	Coordinate level:	47IC
Horizontal datum:	NAD83	Horizontal datum:	NAD83
Vertical datum:	NAVD83	Vertical datum:	NAVD83
Horizontal accuracy:	± 0.02 m	Horizontal accuracy:	± 0.02 m
Vertical accuracy:	± 0.02 m	Vertical accuracy:	± 0.02 m
Horizontal precision:	± 0.01 m	Horizontal precision:	± 0.01 m
Vertical precision:	± 0.01 m	Vertical precision:	± 0.01 m
Horizontal resolution:	± 0.01 m	Horizontal resolution:	± 0.01 m
Vertical resolution:	± 0.01 m	Vertical resolution:	± 0.01 m
Horizontal scale:	1:10,000	Horizontal scale:	1:10,000
Vertical scale:	1:10,000	Vertical scale:	1:10,000
Horizontal distortion:	± 0.01 m	Horizontal distortion:	± 0.01 m
Vertical distortion:	± 0.01 m	Vertical distortion:	± 0.01 m
Horizontal error:	± 0.01 m	Horizontal error:	± 0.01 m
Vertical error:	± 0.01 m	Vertical error:	± 0.01 m
Horizontal standard deviation:	± 0.01 m	Horizontal standard deviation:	± 0.01 m
Vertical standard deviation:	± 0.01 m	Vertical standard deviation:	± 0.01 m
Horizontal confidence interval:	± 0.01 m	Horizontal confidence interval:	± 0.01 m
Vertical confidence interval:	± 0.01 m	Vertical confidence interval:	± 0.01 m
Horizontal reliability:	± 0.01 m	Horizontal reliability:	± 0.01 m
Vertical reliability:	± 0.01 m	Vertical reliability:	± 0.01 m
Horizontal accuracy:	± 0.02 m	Horizontal accuracy:	± 0.02 m
Vertical accuracy:	± 0.02 m	Vertical accuracy:	± 0.02 m
Horizontal precision:	± 0.01 m	Horizontal precision:	± 0.01 m
Vertical precision:	± 0.01 m	Vertical precision:	± 0.01 m
Horizontal resolution:	± 0.01 m	Horizontal resolution:	± 0.01 m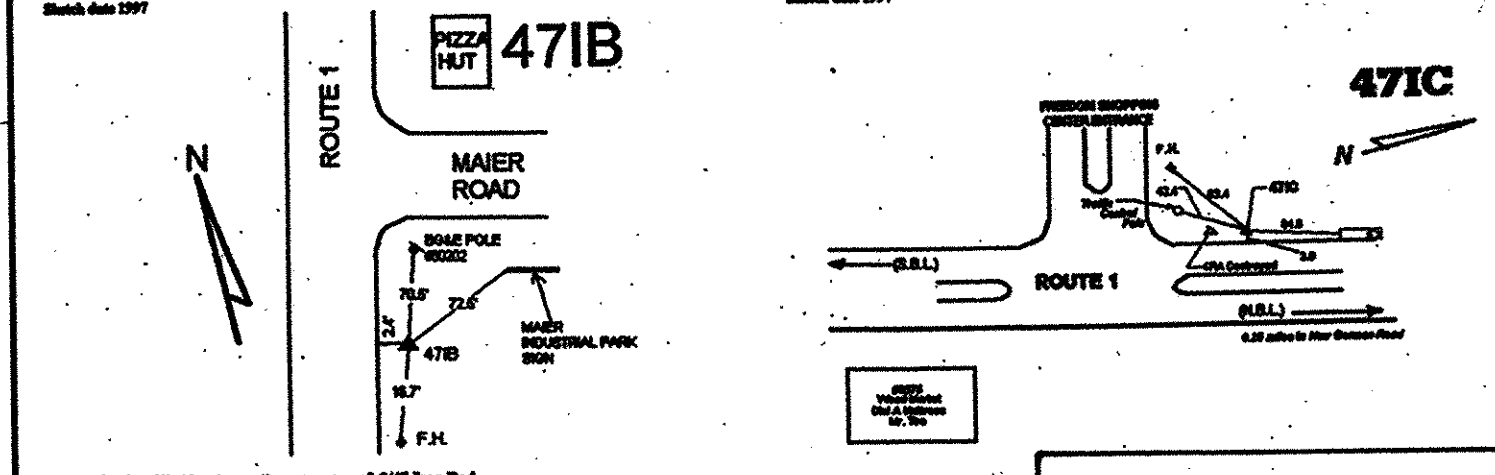
APPROVED: HOWARD COUNTY DEPARTMENT OF PLANNING AND ZONING	10/6/98
DIRECTOR	DATE
Chief, Division of Land Development	10/5/98
DATE	
Chief, Development Engineering Division	10/1/98
DATE	

NOTE: SEE VICINITY MAP FOR LOCATIONS OF GEODETIC CONTROL POINTS



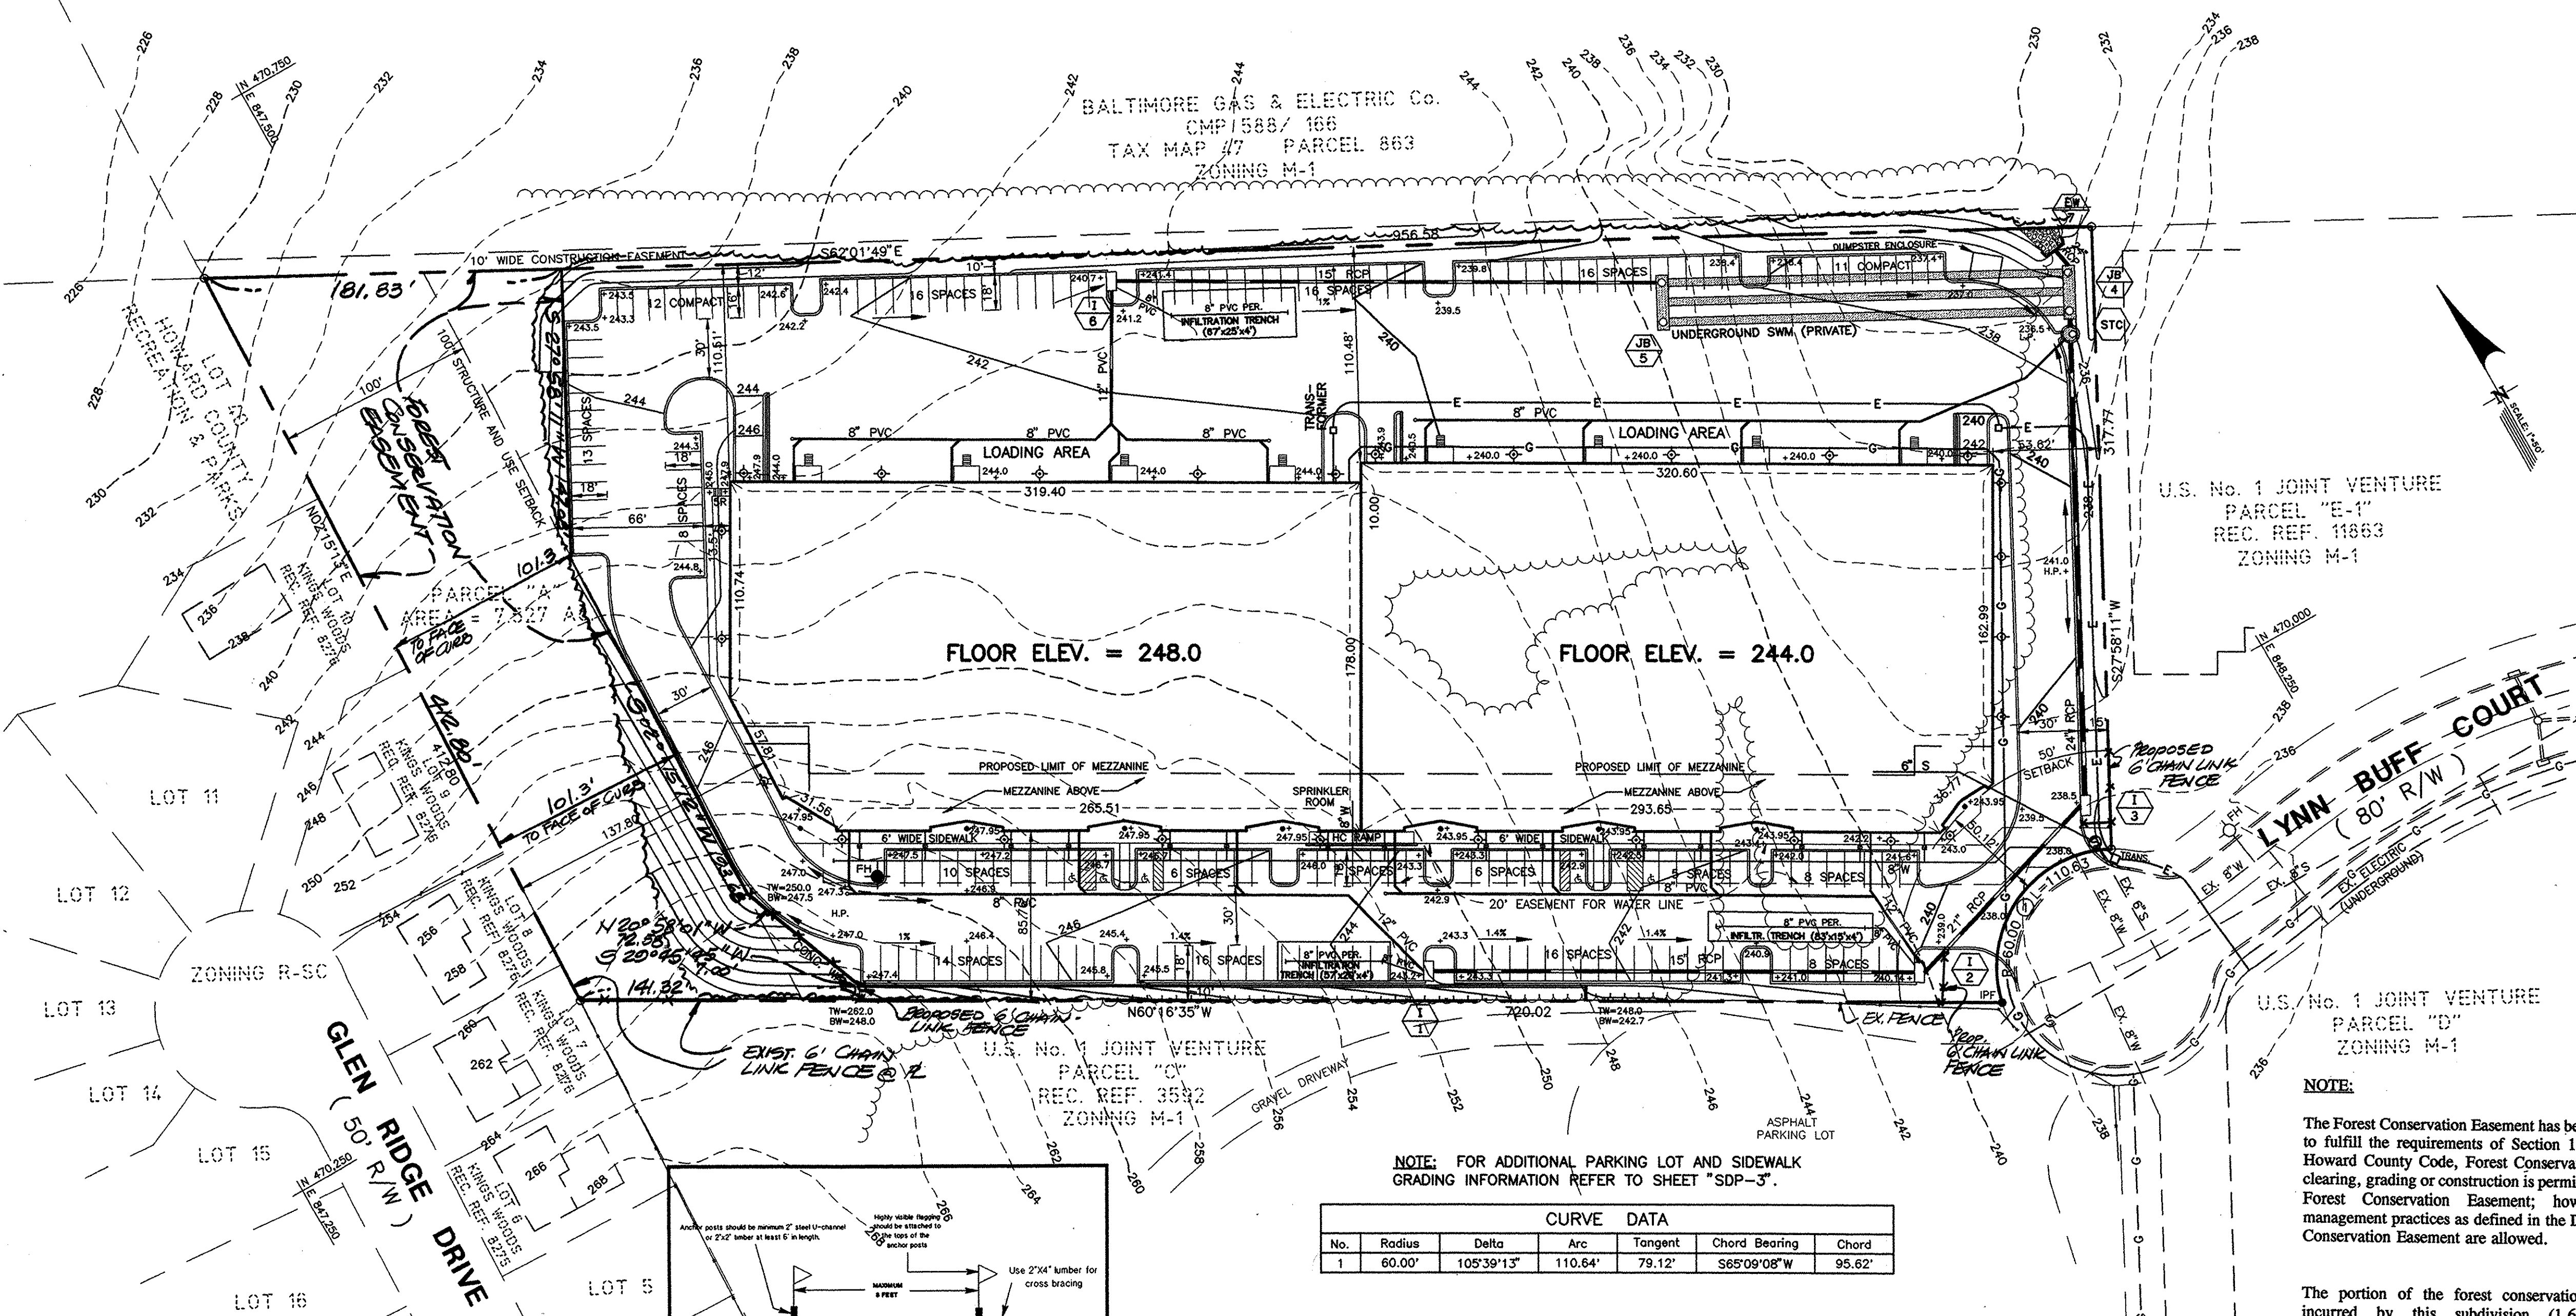

ADJACENT PROPERTY OWNERS	
PROPERTY	OWNER
KINGS WOODS SECTION 1, AREA 1 LOT 6	GARY KUYENDALL 9536 GLEN RIDGE DR. LAUREL, MARYLAND 20723
KINGS WOODS SECTION 1, AREA 1 LOT 7	MELANIE MCKNIGHT 9540 GLEN RIDGE DR. LAUREL, MARYLAND 20723
KINGS WOODS SECTION 1, AREA 1 LOT 8	THEIRY BREANT 9544 GLEN RIDGE DR. LAUREL, MARYLAND 20723
KINGS WOODS SECTION 1, AREA 1 LOT 9	HEN V. ONG 9548 GLEN RIDGE DR. LAUREL, MARYLAND 20723
KINGS WOODS SECTION 1, AREA 1 LOT 10	ROBERT MARTINEZ 9552 GLEN RIDGE DR. LAUREL, MARYLAND 20723
KINGS WOODS SECTION 1, AREA 1 LOT 40	HOWARD COUNTY DEPARTMENT OF RECREATION AND PARKS
CMP 588/166 TAX MAP 47	BALTIMORE GAS & ELECTRIC Co. P.O. BOX 1475 BALTIMORE, MARYLAND 21203-1475
U.S. No. 1 JOINT VENTURE PARCEL "E"	LYNN BUFF LIMITED PARTNERS 9550 LYNN BUFF CT. LAUREL, MARYLAND 20723-6324
U.S. No. 1 JOINT VENTURE PARCEL "C"	STEFINTRACO A. SWISS CORPORATION c/o GREGORY PNEIL 8401 CONNECTICUT AVE. CHEVY CHASE, MARYLAND 20815

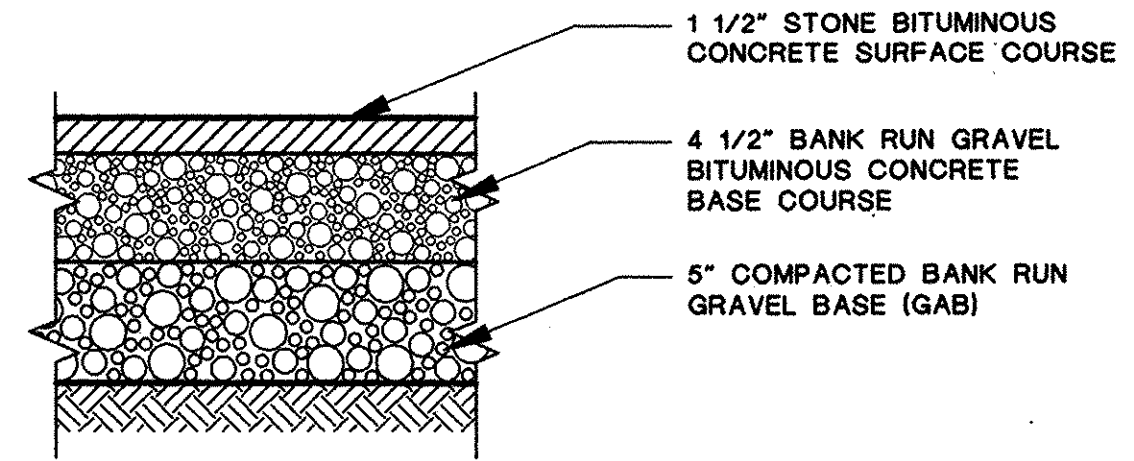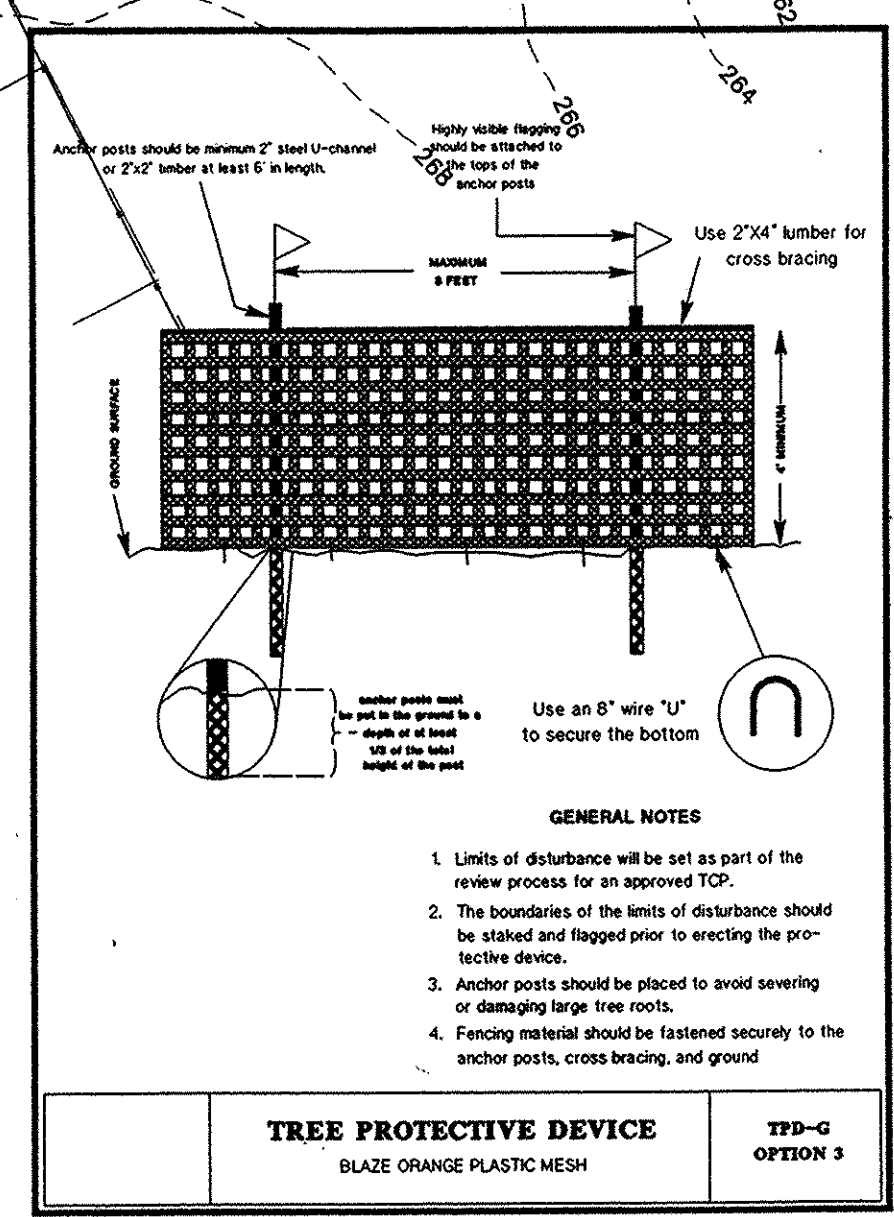


CURVE DATA					
No.	Radius	Delta	Arc	Tangent	Chord
1	60.00'	105°39'13"	110.64'	79.12'	S65°08'08"W 95.62'

GENERAL PAVING NOTES

- All roadway construction shall be in accordance with the General Specifications for Highway and Street Construction, the Howard County Code and the Howard County Road Ordinance.
- Information concerning underground utilities was obtained from available records, but the contractor must determine the exact location and elevation of the mains by digging test pits by hand at utility crossings well in advance of trenching. If clearances to water and sewer lines are less than shown on this plan or twelve (12) inches, contact the Engineer before proceeding with construction.
- All elevations shown on these plans are referred to Maryland State and Howard County vertical datum.
- All roadway fillet radii shall be 25 feet, unless otherwise noted.
- All unpaved areas within the property or right-of-way shall be sodded.
- All curb and gutter shall be in accordance with Howard County Standard No. R-3.01.
- All sidewalks shall be in accordance with Howard County Standard No. R-3.05, unless otherwise noted.
- Provide Standard No. R-4.01 sidewalk ramps Type A at locations shown on the plans.
- The pavement subgrade is to be approved by the Howard County Inspector prior to installation of Base Course.
- Underdrain system shall be installed when warranted by field conditions or as required by the Howard County Inspector.

LEGEND

DESCRIPTION	EXISTING	PROPOSED
PROPERTY LINE	---	---
TREELINE	---	---
CONTOUR LINE	---	---
SPOT ELEVATION		+250
STORMDRAIN PIPE	---	---
LIMIT OF DISTURBANCE		L.O.D.
SILT FENCE		S.F.
HANDICAPPED SPACE		⊕
FIRE HYDRANT	⊕	⊕
CURB & GUTTER	---	---
WHEELCHAIR RAMP		*
TOP OF WALL		T.W.
BOTTOM OF WALL		B.W.
WATER METER VAULT (3/4" METER & 1" WHC)		⊕
SITE LIGHTING FIXTURE MOUNTED ON BLDG.		⊕

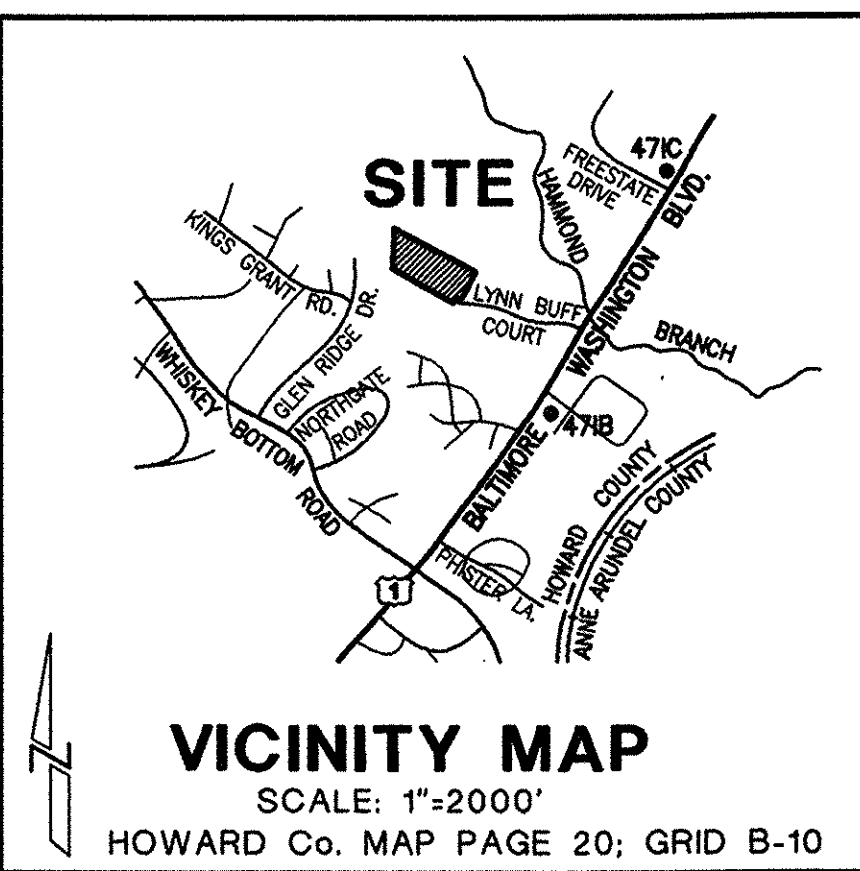

BY THE DEVELOPER:

I/WE CERTIFY THAT ALL DEVELOPMENT AND/OR CONSTRUCTION WILL BE DONE IN ACCORDANCE TO THESE PLANS AND THAT ANY RESPONSIBLE PERSONNEL INVOLVED IN THE CONSTRUCTION PROJECT WILL HAVE A CERTIFICATE OF ATTENDANCE AT A DEPARTMENT OF THE ENVIRONMENT APPROVED TRAINING PROGRAM FOR THE CONTROL OF SEDIMENT AND EROSION BEFORE BEGINNING THE PROJECT. I/WE WILL PROVIDE THE HOWARD SOIL CONSERVATION DISTRICT WITH AN "AS-BUILT" PLAN OF THE PROJECT WITHIN 90 DAYS OF COMPLETION. I/WE ALSO AUTHORIZE PERIODIC ON-SITE INSPECTIONS BY THE HOWARD SOIL CONSERVATION DISTRICT.

JOSEPH NAZARIO, OWNER  
NAZARIO DEVELOPMENT AND COMPANY

5-1-98 DATE

BY THE ENGINEER:

I/WE CERTIFY THAT THIS PLAN FOR FLOOD PROTECTION, SOIL EROSION AND SEDIMENT CONTROL REPRESENTS A PRACTICAL AND WORKABLE PLAN BASED ON MY PERSONAL KNOWLEDGE OF THE SITE CONDITIONS. THIS PLAN WAS PREPARED IN ACCORDANCE WITH THE REQUIREMENTS OF THE HOWARD SOIL CONSERVATION DISTRICT. I/WE ALSO AUTHORIZE PERIODIC ON-SITE INSPECTIONS BY THE HOWARD SOIL CONSERVATION DISTRICT WITHIN 90 DAYS OF COMPLETION.

FRED L. SKELTON - MD. REGISTRATION No. 9070  
IPDS, LLC

6/5/98 DATE

THESE PLANS SOIL EROSION AND SEDIMENT CONTROL MEET THE REQUIREMENTS OF THE HOWARD SOIL CONSERVATION DISTRICT.

Clayton Simmons 9/3/98  
NATURAL RESOURCES CONSERVATION SERVICE

THESE PLANS HAVE BEEN REVIEWED FOR THE HOWARD SOIL CONSERVATION DISTRICT AND MEET THE TECHNICAL REQUIREMENTS FOR SOIL EROSION AND SEDIMENT CONTROL.

John R. Blanton 9/3/98  
HOWARD SOIL CONSERVATION DISTRICT

APPROVED: HOWARD COUNTY DEPARTMENT OF PLANNING AND ZONING

10/6/98 DATE

10/5/95 DATE

10/1/98 DATE

OWNER \ DEVELOPER

Joseph Nazario  
Nazario Development and Company  
6500 Ammendale Road  
Beltsville, Maryland 20705  
(301) 937-4664

SDP-98-135

802 Silgo Avenue  
Silver Spring,  
Maryland, 20910  
The Interprofessional  
PLANNING & DESIGN STUDIO, LLC  
(301) 585-5576  
Engineers • Architects • Surveyors  
Planners & Landscape Architects

**IPDS**

**SITE DEVELOPMENT PLAN**

**SITE DEVELOPMENT PLAN**

**U.S. No. 1 JOINT VENTURE**  
PARCEL "A", PLAT CMP No. 3592, WAREHOUSE  
GUILFORD ELECTION DISTRICT No. 6  
HOWARD COUNTY, MARYLAND  
CENSUS TRACT 6089.02, TAX MAP 47, BLOCK 22/23  
WATER CODE C04, SEWER CODE 722000

1"=50'

07-13-98  
06-18-98

REVISIONS:

12-18-97

DATE:


JOB NUMBER:

**SDP-1**

SHEET 2 OF 13


**SDP-98-135**



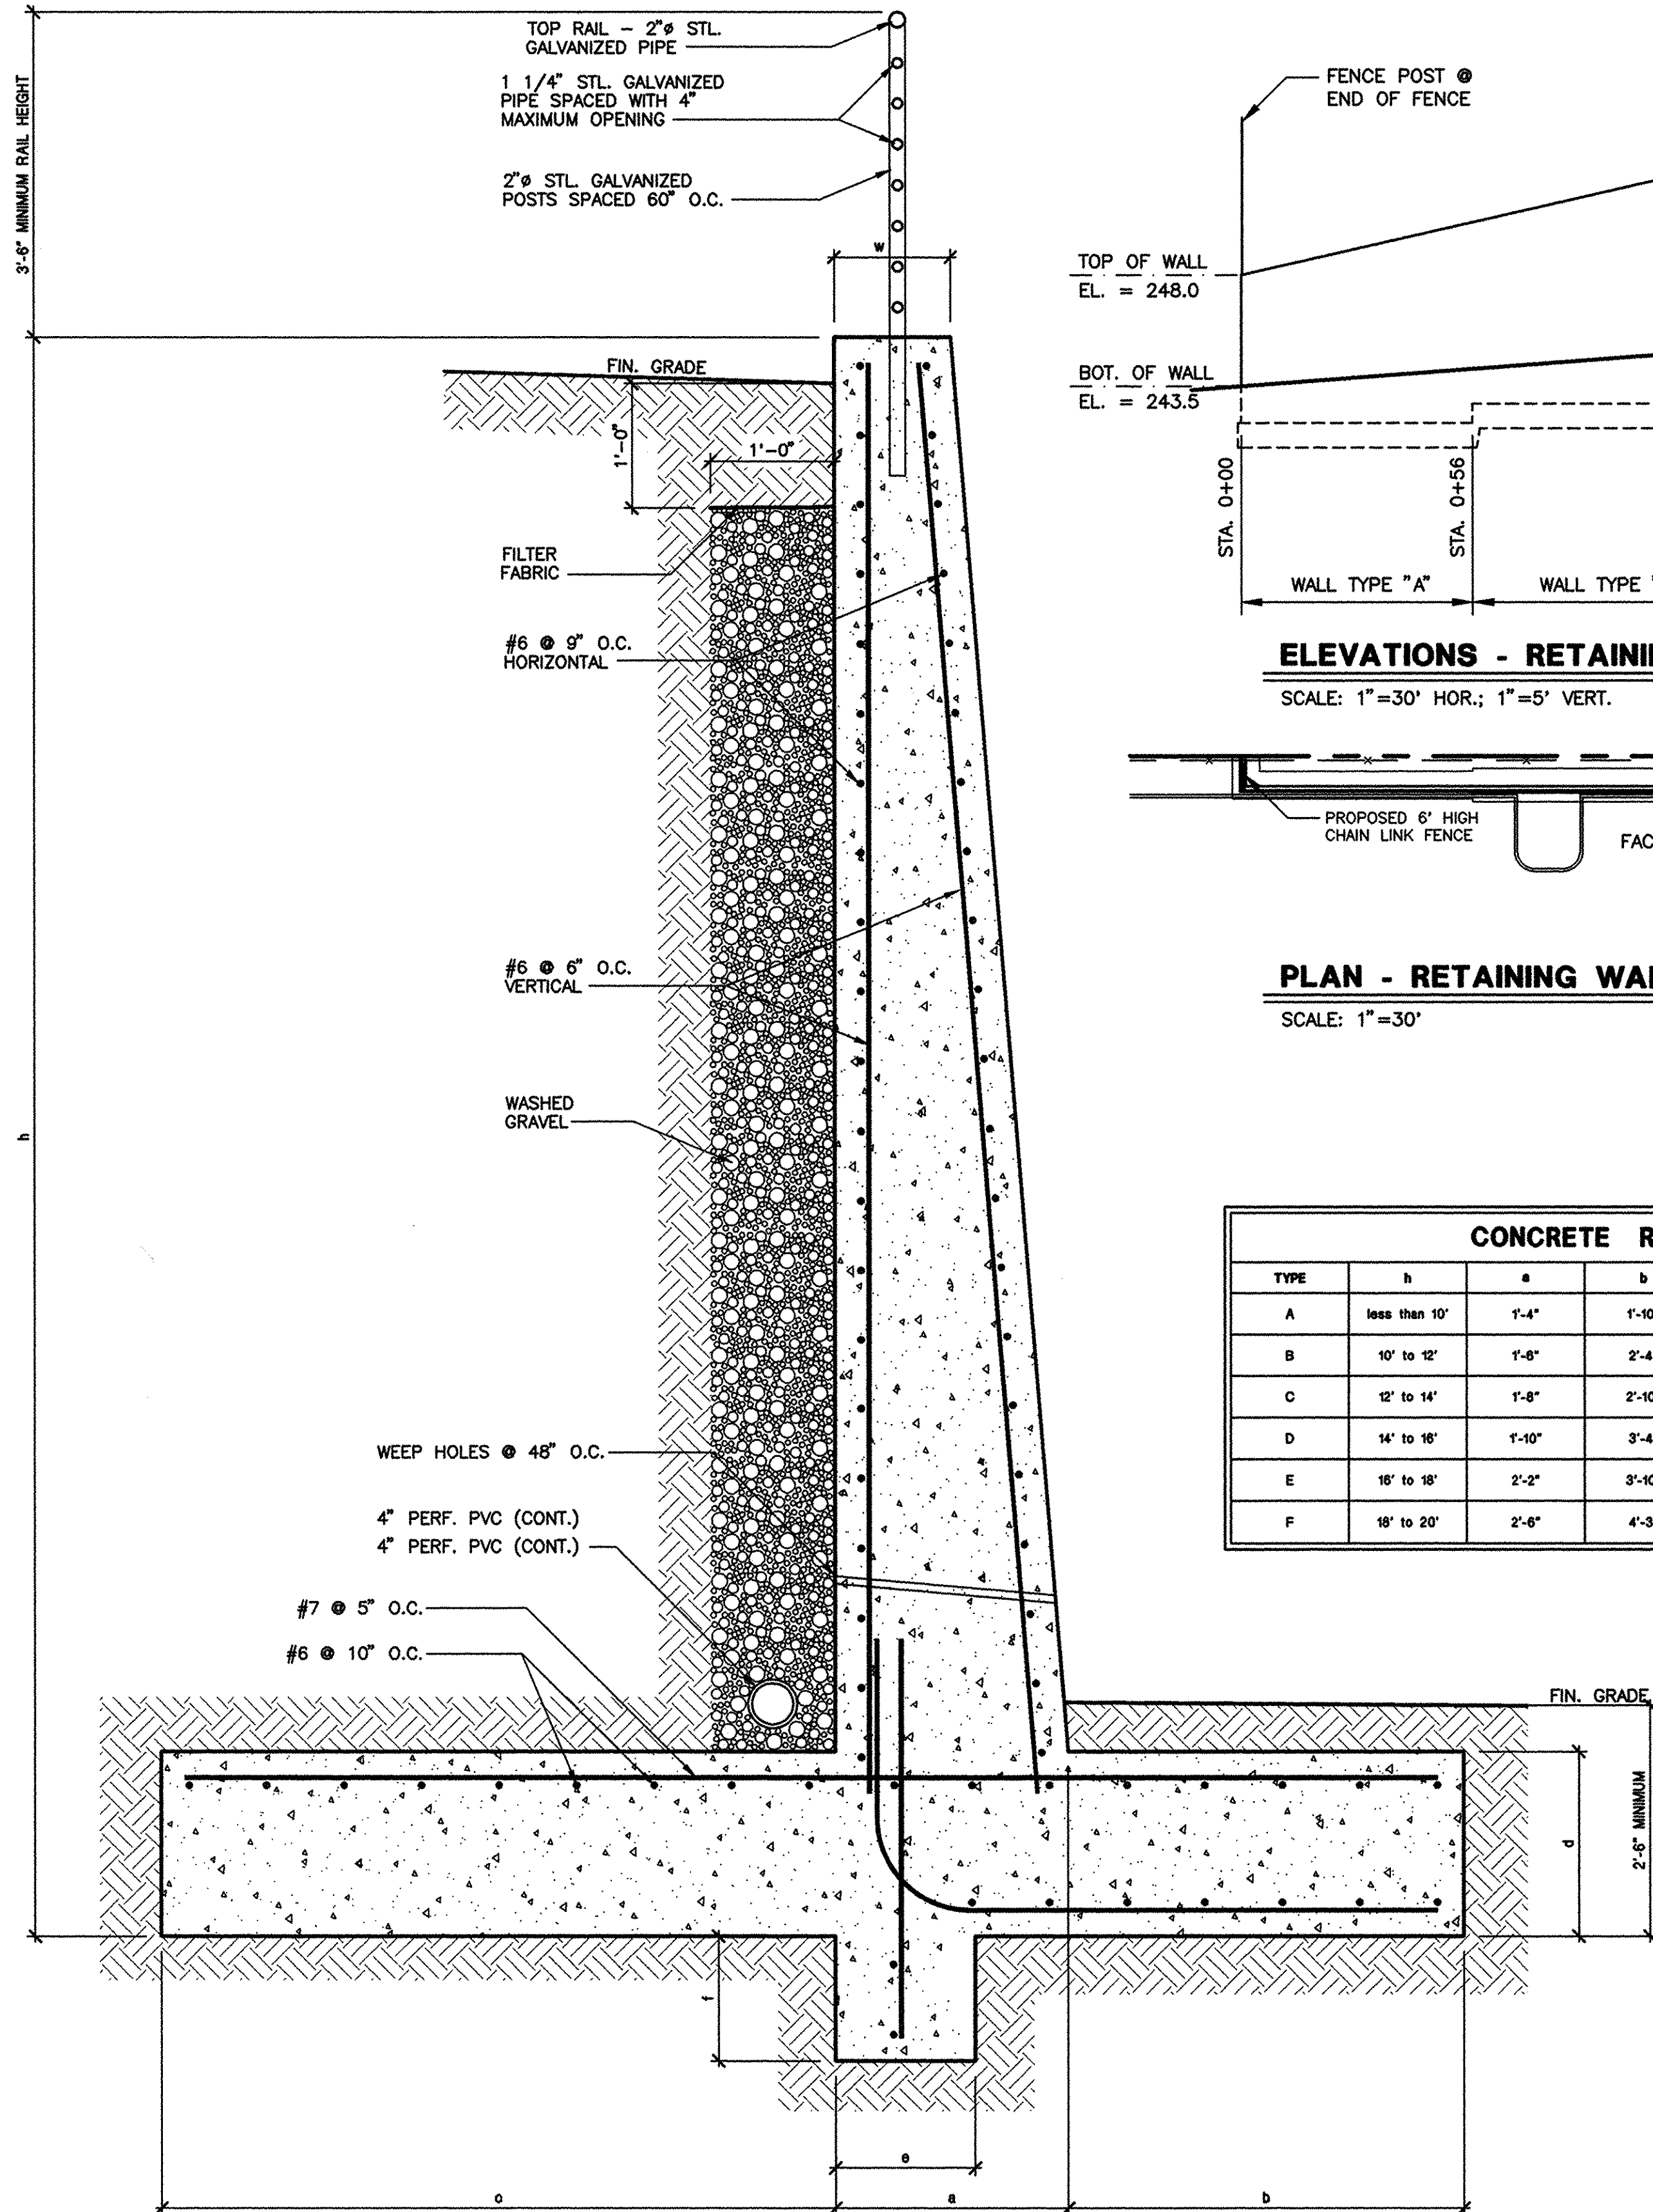


# RETAINING WALL DETAIL

NO SCALE

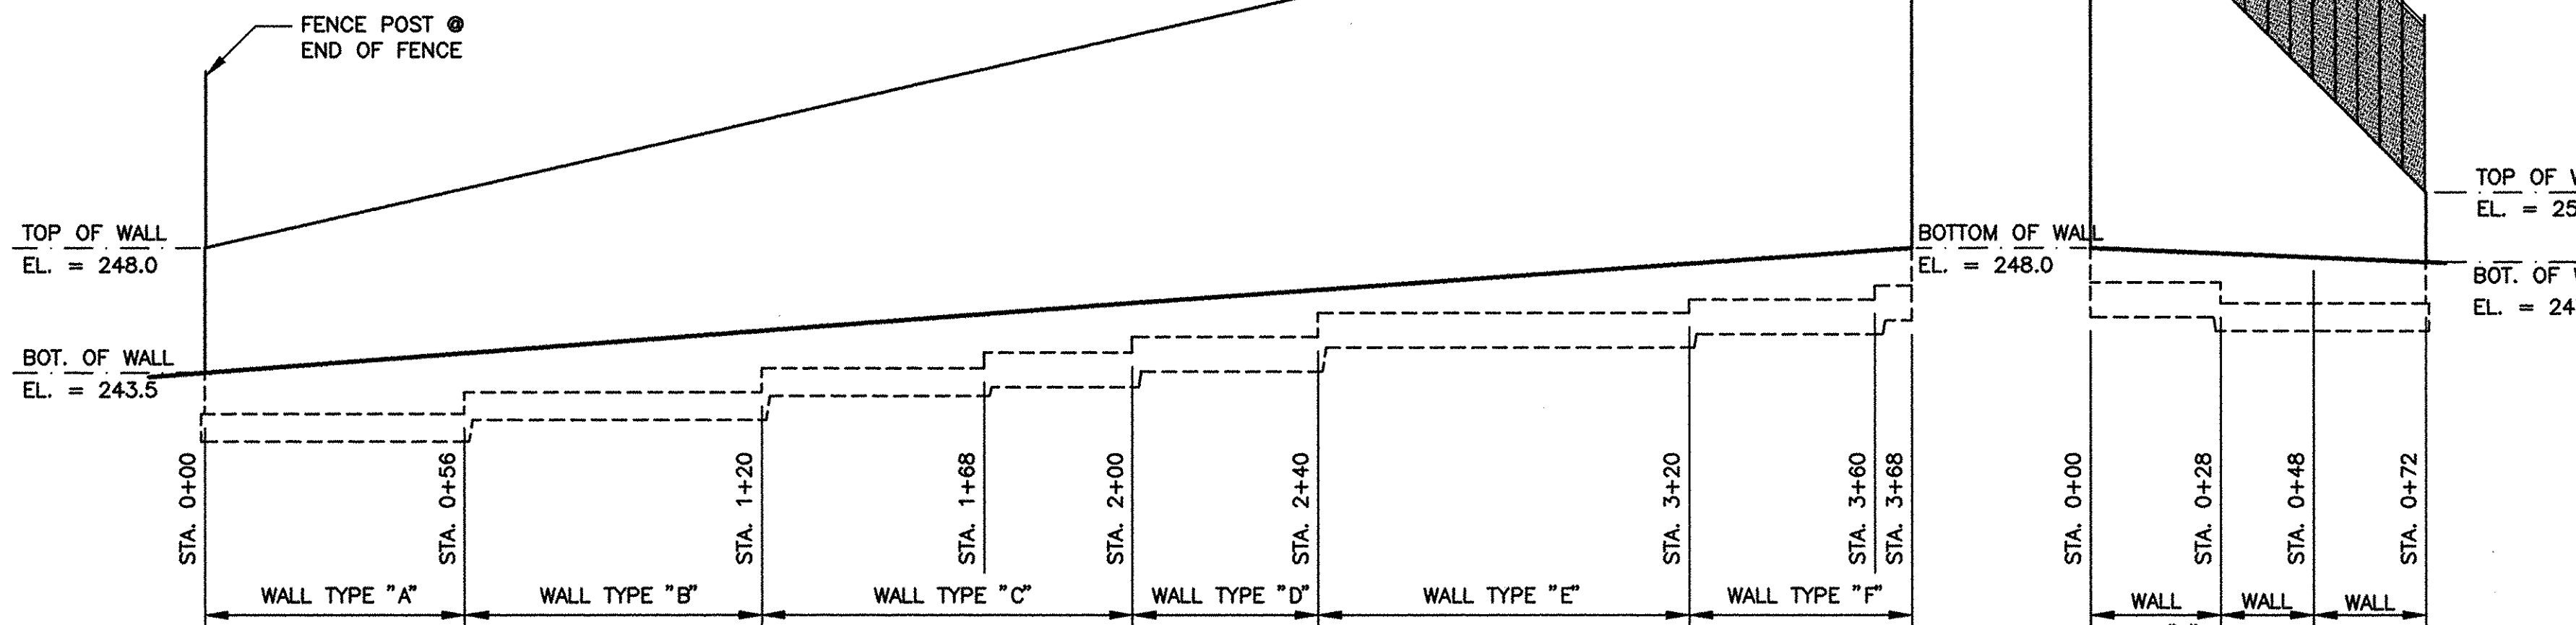

## ELEVATIONS - RETAINING WALL

SCALE: 1"=30' HOR.; 1"=5' VERT.

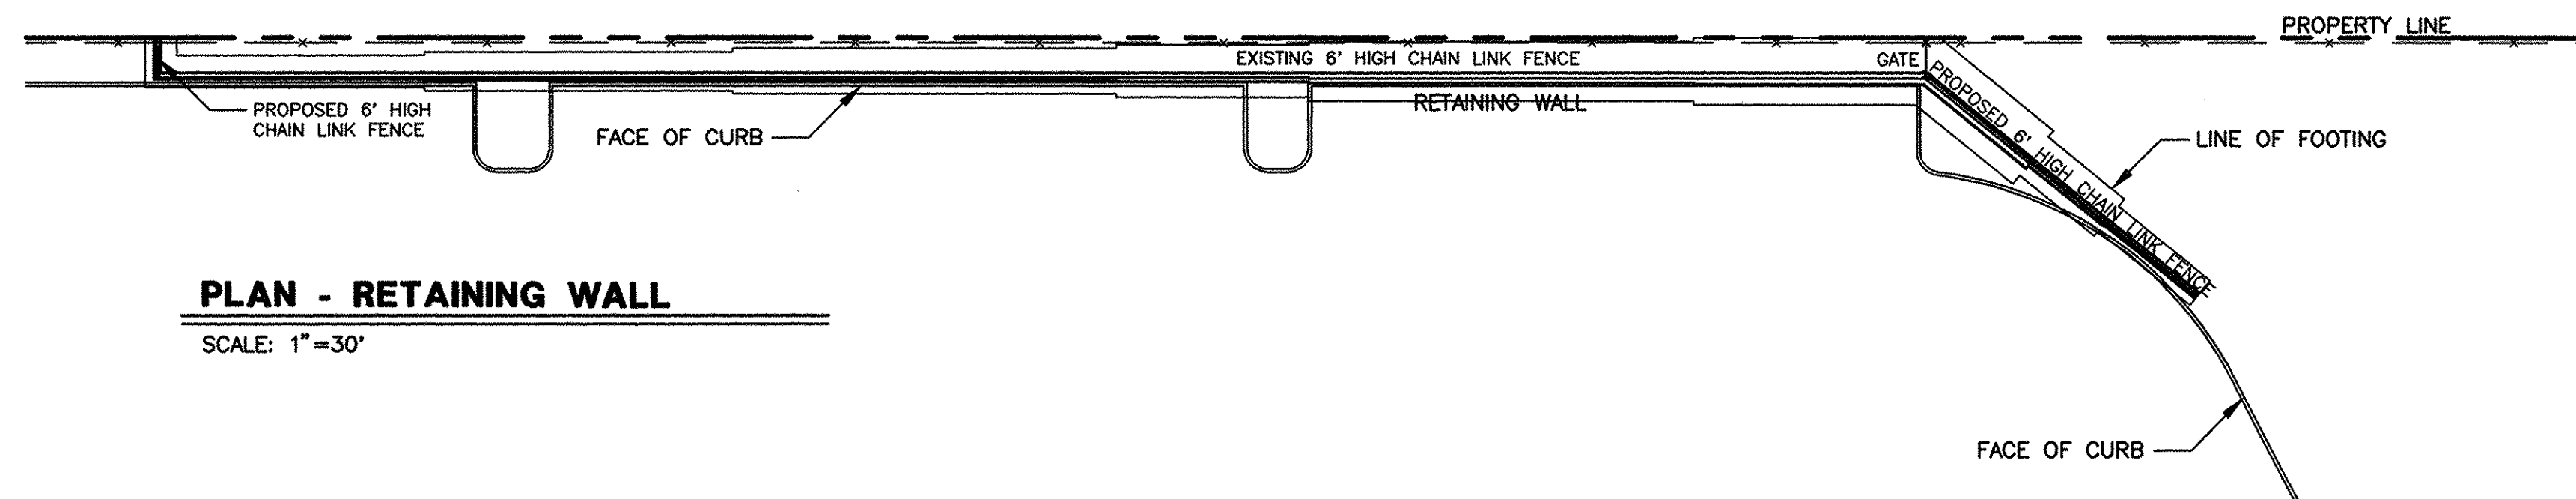

## PLAN - RETAINING WALL

SCALE: 1"=30'

CONCRETE RETANING WALL DIMENSIONS								
TYPE	h	a	b	c	d	e	f	w
A	less than 10'	1'-4"	1'-10"	3'-6"	1'-2"	1'-0"	1'-0"	1'-0"
B	10' to 12'	1'-8"	2'-4"	4'-3"	1'-4"	1'-0"	1'-0"	1'-0"
C	12' to 14'	1'-8"	2'-10"	5'-0"	1'-6"	1'-3"	1'-0"	1'-0"
D	14' to 16'	1'-10"	3'-4"	5'-6"	1'-8"	1'-3"	1'-0"	1'-0"
E	16' to 18'	2'-2"	3'-10"	6'-6"	1'-10"	1'-3"	1'-0"	1'-3"
F	18' to 20'	2'-6"	4'-3"	7'-3"	2'-0"	1'-3"	1'-0"	1'-3"

## STRUCTURAL NOTES

SOIL PRESSURE: SOIL BEARING CAPACITY BENEATH FOOTINGS TO BE A MINIMUM OF 3,000 PSF.

FOOTINGS: TO BE A MINIMUM OF 2'-8" BELOW OUTSIDE FINISH GRADE AND BEARING ON UNDISTURBED SOIL.

CONCRETE: MINIMUM  $F'_c = 5,000$  PSI; DESIGN, MIX AND PLACE IN ACCORDANCE WITH ACI 318-83. CONCRETE SHALL BE PROTECTED SO THAT THE TEMPERATURE AT THE SURFACE WILL NOT FALL BELOW 50 DEGREES F, OR THAT THERE WILL BE NO LOSS OF MOISTURE FROM THE SURFACE FOR A PERIOD OF SEVEN DAYS AFTER POURING. PROTECTION AGAINST LOSS OF MOISTURE SHALL BE ACCOMPLISHED BY COVERING THE CONCRETE WITH BURLAP OR COTTON MATS KEPT CONTINUOUSLY WET. DUSTING THE SURFACE WITH CEMENT IS PROHIBITED. AFTER SCREEDING THE SLAB, THE SURFACE SHALL BE FLOATED AND LATER STEEL TROWELED TO A SMOOTH, HARD, LEVEL FINISH. ALL CONCRETE SLABS SHALL BE A MAXIMUM OF 3/16" OUT OF LEVEL IN ANY 10'-0" LENGTH. CHAMFER ALL EXPOSED EDGES. USE OF ADDITIVES SHALL NOT BE PERMITTED UNLESS SPECIFICALLY APPROVED BY I.P.D.S. USE OF ADDITIVES CONTAINING CALCIUM CHLORIDE SHALL NOT BE PERMITTED.

REINFORCING: ASTM A-615 GRADE 40.

BY THE DEVELOPER:  
I/WE CERTIFY THAT ALL DEVELOPMENT AND/OR CONSTRUCTION WILL BE DONE IN ACCORDANCE WITH THESE PLANS AND THAT ANY RESPONSIBLE PERSONNEL INVOLVED IN THE CONSTRUCTION PROJECT WILL HAVE A CERTIFICATE OF ATTENDANCE AT A DEPARTMENT OF THE ENVIRONMENT APPROVED TRAINING PROGRAM FOR THE CONTROL OF SEDIMENT AND EROSION BEFORE BEGINNING THE PROJECT. I/WE WILL PROVIDE THE HOWARD SOIL CONSERVATION DISTRICT WITH AN AS-BUILT PLAN OF THE PROJECT WITHIN 30 DAYS OF COMPLETION. I/WE ALSO AUTHORIZE PERIODIC ON-SITE INSPECTIONS BY THE HOWARD SOIL CONSERVATION DISTRICT.

JOSEPH NAZARIO, OWNER  
NAZARIO DEVELOPMENT AND COMPANY  
DATE: 5-1-98

BY THE ENGINEER:  
I/WE CERTIFY THAT THIS PLAN FOR EROSION CONTROL, SOIL EROSION AND SEDIMENT CONTROL REPRESENTS A PRACTICAL AND WORKABLE PLAN BASED ON MY PERSONAL KNOWLEDGE OF THE SITE CONDITIONS. THIS PLAN WAS PREPARED IN ACCORDANCE WITH THE REQUIREMENTS OF THE HOWARD SOIL CONSERVATION DISTRICT. I HAVE NOTIFIED THE DEVELOPER THAT HE MUST PROVIDE THE HOWARD SOIL CONSERVATION DISTRICT WITH AN AS-BUILT PLAN OF THE PROJECT WITHIN 30 DAYS OF COMPLETION.

FRED L. SKELTON  
FRED L. SKELTON - MD. REGISTRATION No. 9070  
IPDS, LLC  
DATE: 6/5/98

THESE PLANS HAVE BEEN REVIEWED FOR THE HOWARD SOIL CONSERVATION DISTRICT AND MEET THE TECHNICAL REQUIREMENTS FOR SOIL EROSION AND SEDIMENT CONTROL.

CHRYL SIMMONS  
U.S. SOIL CONSERVATION SERVICE  
DATE: 9/30/98

THESE PLANS FOR SOIL EROSION AND SEDIMENT CONTROL MEET THE REQUIREMENTS OF THE HOWARD SOIL CONSERVATION DISTRICT.

FRED L. SKELTON  
HOWARD SOIL CONSERVATION DISTRICT  
DATE: 9/30/98

APPROVED: HOWARD COUNTY DEPARTMENT OF PLANNING AND ZONING

LEON S. BENTLEY  
DIRECTOR  
DATE: 10/6/98

CINDY HAMMOND  
CHIEF, DIVISION OF LAND DEVELOPMENT  
DATE: 10/5/98

CHRIS VANDERKAM  
CHIEF, DEVELOPMENT ENGINEERING DIVISION  
DATE: 10/1/98

APPROVED: FOR PUBLIC WATER AND PUBLIC SEWERAGE, STORM DRAINAGE SYSTEMS AND PUBLIC ROADS.

NO  
DIRECTOR  
DATE:


CHIEF, BUREAU OF ENGINEERING  
DATE:

## AS BUILT CERTIFICATE

FRED L. SKELTON - MD. REGISTRATION No. 9070  
IPDS, LLC  
DATE:

## OWNER \ DEVELOPER

Joseph Nazario  
Nazario Development and Company  
6500 Ammendale Road  
Beltsville, Maryland 20705  
(301) 937-4664

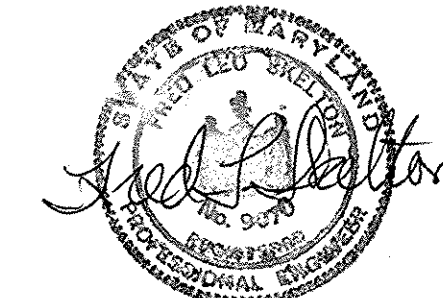

SDP-98-135

802 Silgo Avenue  
Silver Spring,  
Maryland, 20910  
(301) 585-5676  
The Interprofessional  
PLANNING & DESIGN STUDIO, LLC  
Engineers • Architects • Surveyors  
Planners & Landscape Architects

IPDS

## SITE DETAILS

U.S. No.1 JOINT VENTURE  
PARCEL "A", PLAT CMP No. 3592, WAREHOUSE  
GUILFORD ELECTION DISTRICT No. 6  
HOWARD COUNTY, MARYLAND  
CENSUS TRACT 6069.02, TAX MAP 47, BLOCK 22/23  
WATER CODE C04, SEWER CODE 7220000

AS NOTED

SCALE:

06-18-98

REVISIONS:

01-18-98

DATE:

JOB NUMBER:

SDP-2


SHEET 3 OF 13

SDP-98-135








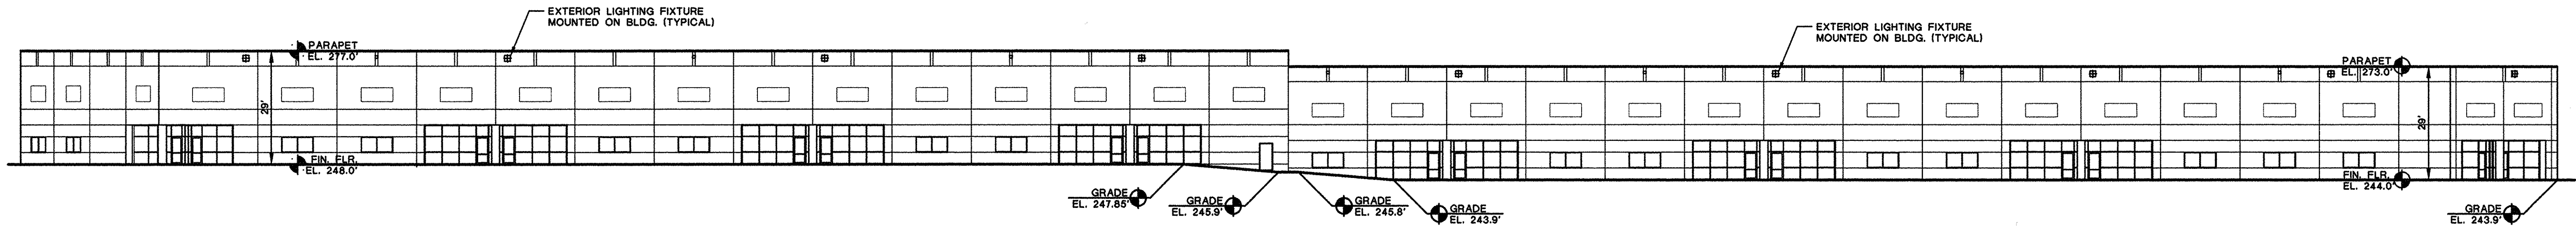


**FRONT BUILDING ELEVATION**

SCALE: 1"=20'

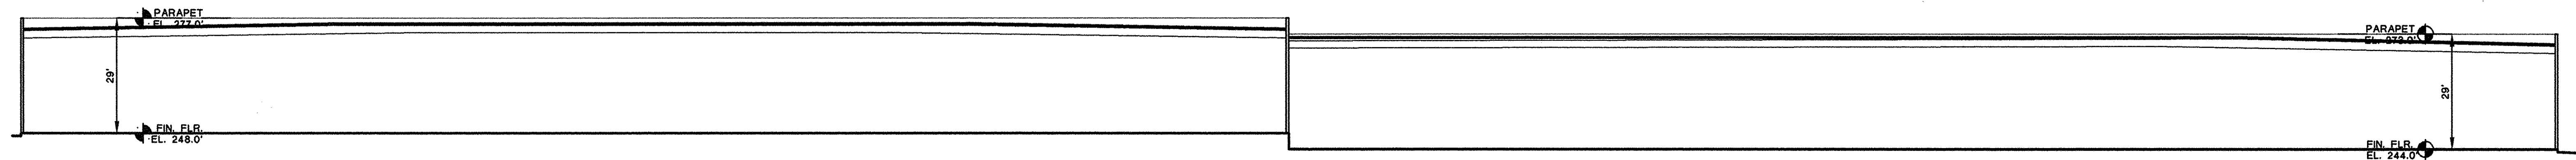


**BUILDING SECTION "A"**

SCALE: 1"=20'

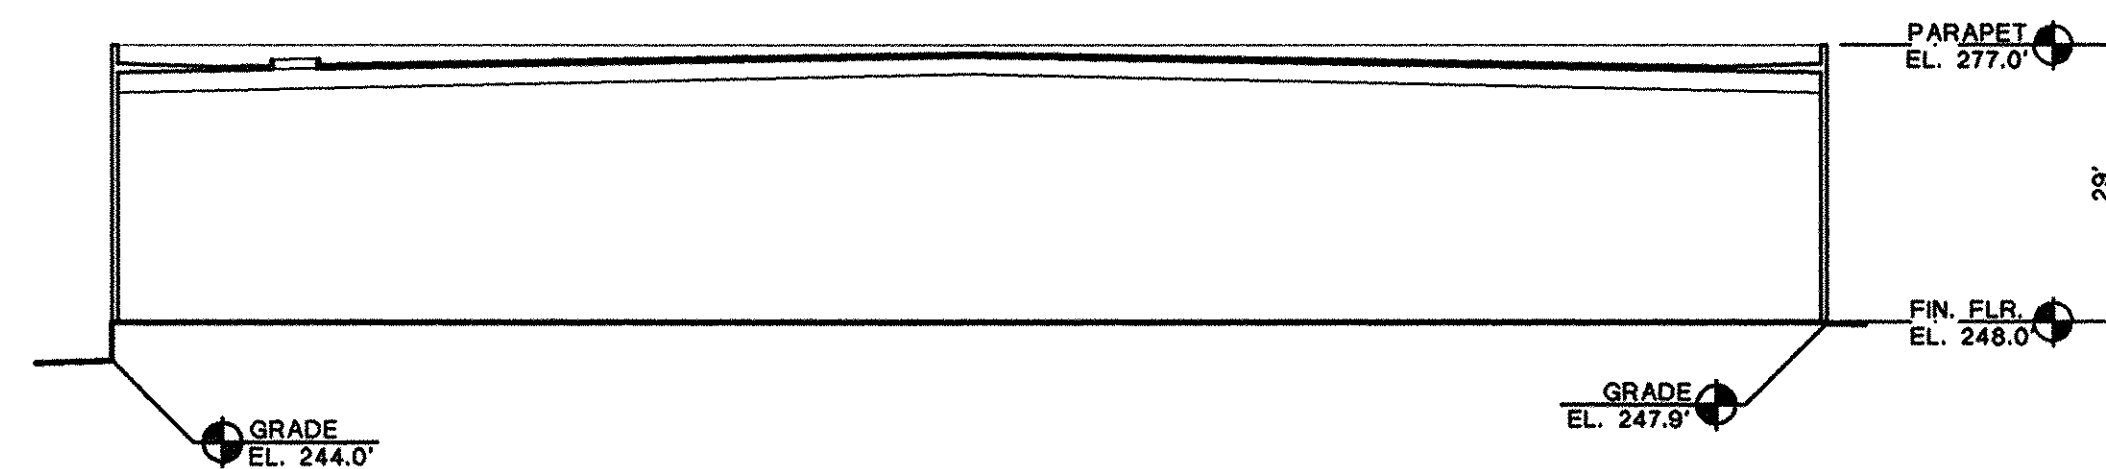


**BUILDING SECTION "B"**

SCALE: 1"=20'

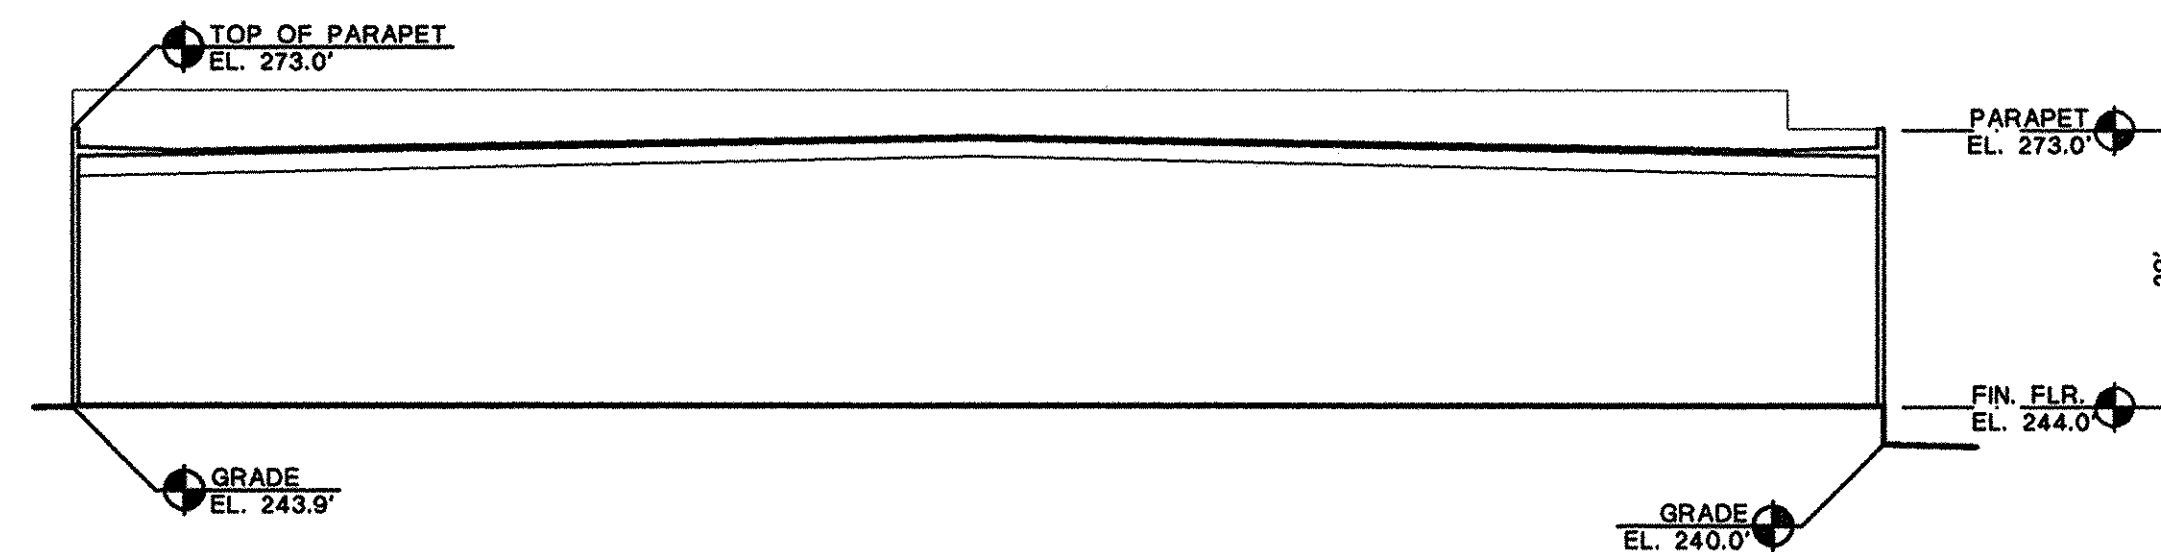

**BUILDING SECTION "C"**

SCALE: 1"=20'

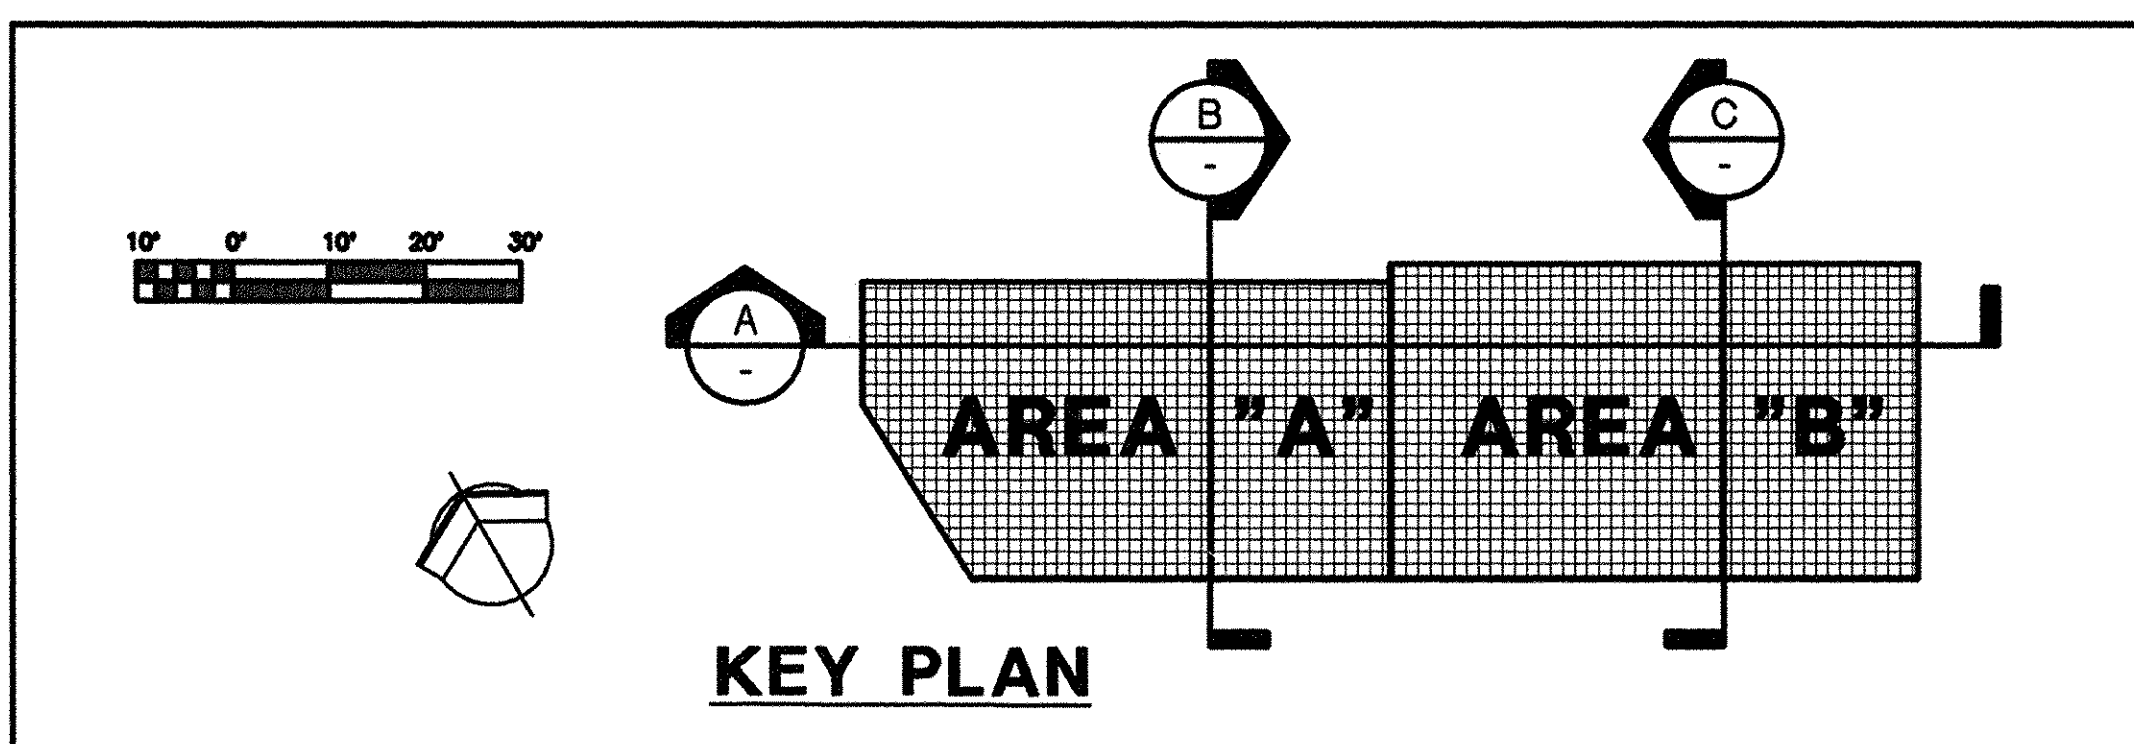

**KEY PLAN**

**OWNER \ DEVELOPER**  
Joseph Nazario  
Nazario Development and Company  
6500 Ammendale Road  
Beltsville, Maryland 20705  
(301) 937-4664



BY THE DEVELOPER: I/WE CERTIFY THAT ALL DEVELOPMENT AND/OR CONSTRUCTION WILL BE DONE IN ACCORDANCE TO THESE PLANS AND THAT ANY RESPONSIBLE PERSONNEL INVOLVED IN THE CONSTRUCTION PROJECT WILL HAVE A CERTIFICATE OF ATTENDANCE AT A DEPARTMENT OF THE ENVIRONMENT APPROVED TRAINING PROGRAM FOR THE CONTROL OF SEDIMENT AND EROSION BEFORE BEGINNING THE PROJECT. I/WE WILL PROVIDE THE HOWARD SOIL CONSERVATION DISTRICT WITH AN AS-BUILT PLAN OF THE PROJECT WITHIN 90 DAYS OF COMPLETION. I/WE ALSO AUTHORIZE PERIODIC ON-SITE INSPECTIONS BY THE HOWARD SOIL CONSERVATION DISTRICT.  JOSEPH NAZARIO, OWNER NAZARIO DEVELOPMENT AND COMPANY  5-1-98 DATE	
BY THE ENGINEER: I/WE CERTIFY THAT THIS PLAN FOR ROAD CONSTRUCTION, SOIL EROSION AND SEDIMENT CONTROL REPRESENTS A PRACTICAL AND WORKABLE PLAN BASED ON MY PERSONAL KNOWLEDGE OF THE SITE CONDITIONS. THIS PLAN WAS PREPARED IN ACCORDANCE WITH THE REQUIREMENTS OF THE HOWARD SOIL CONSERVATION DISTRICT. I HAVE NOTIFIED THE DEVELOPER THAT HE MUST OBTAIN THE HOWARD SOIL CONSERVATION DISTRICT WITHIN 90 DAYS OF COMPLETION.  Fred L. Skelton FRED L. SKELTON - MD. REGISTRATION No. 9070 IPDS, LLC  6/5/98 DATE	
THESE PLANS SOIL EROSION AND SEDIMENT CONTROL MEET THE REQUIREMENTS OF THE HOWARD SOIL CONSERVATION DISTRICT.  Cheryl Simmons NATURAL RESOURCES CONSERVATION SERVICE  9/30/98 DATE	
THESE PLANS HAVE BEEN REVIEWED FOR THE HOWARD SOIL CONSERVATION DISTRICT AND MEET THE TECHNICAL REQUIREMENTS FOR SOIL EROSION AND SEDIMENT CONTROL.  John R. Robertson HOWARD SOIL CONSERVATION DISTRICT  9/30/98 DATE	
APPROVED: HOWARD COUNTY DEPARTMENT OF PLANNING AND ZONING  Fred L. Skelton DIRECTOR  10/6/98 DATE	
Candy Hamilton CHIEF, DIVISION OF LAND DEVELOPMENT  10/5/98 DATE	
John R. Robertson CHIEF, DEVELOPMENT ENGINEERING DIVISION  10/1/98 DATE	

802 Sligo Avenue  
Silver Spring,  
Maryland, 20910  
(301) 585-5676  
IPDS  
The Interprofessional  
PLANNING & DESIGN STUDIO, LLC  
Engineers • Architects • Surveyors  
Planners & Landscape Architects

**FRONT BUILDING ELEVATION  
& BUILDING PROFILES**

**U.S. No.1 JOINT VENTURE**  
PARCEL "A", PLAT CMP No. 3692, WAREHOUSE  
GUILFORD ELECTION DISTRICT No. 6  
HOWARD COUNTY, MARYLAND  
CENSUS TRACT 6069.02, TAX MAP 47, BLOCK 22/23  
WATER CODE C04, SEWER CODE 7220000

1"=20'

06-18-98

04-30-98


JOB NUMBER:

**SDP-4**  
SHEET 5 OF 13

**SDP-98-135**


**SDP-98-135**



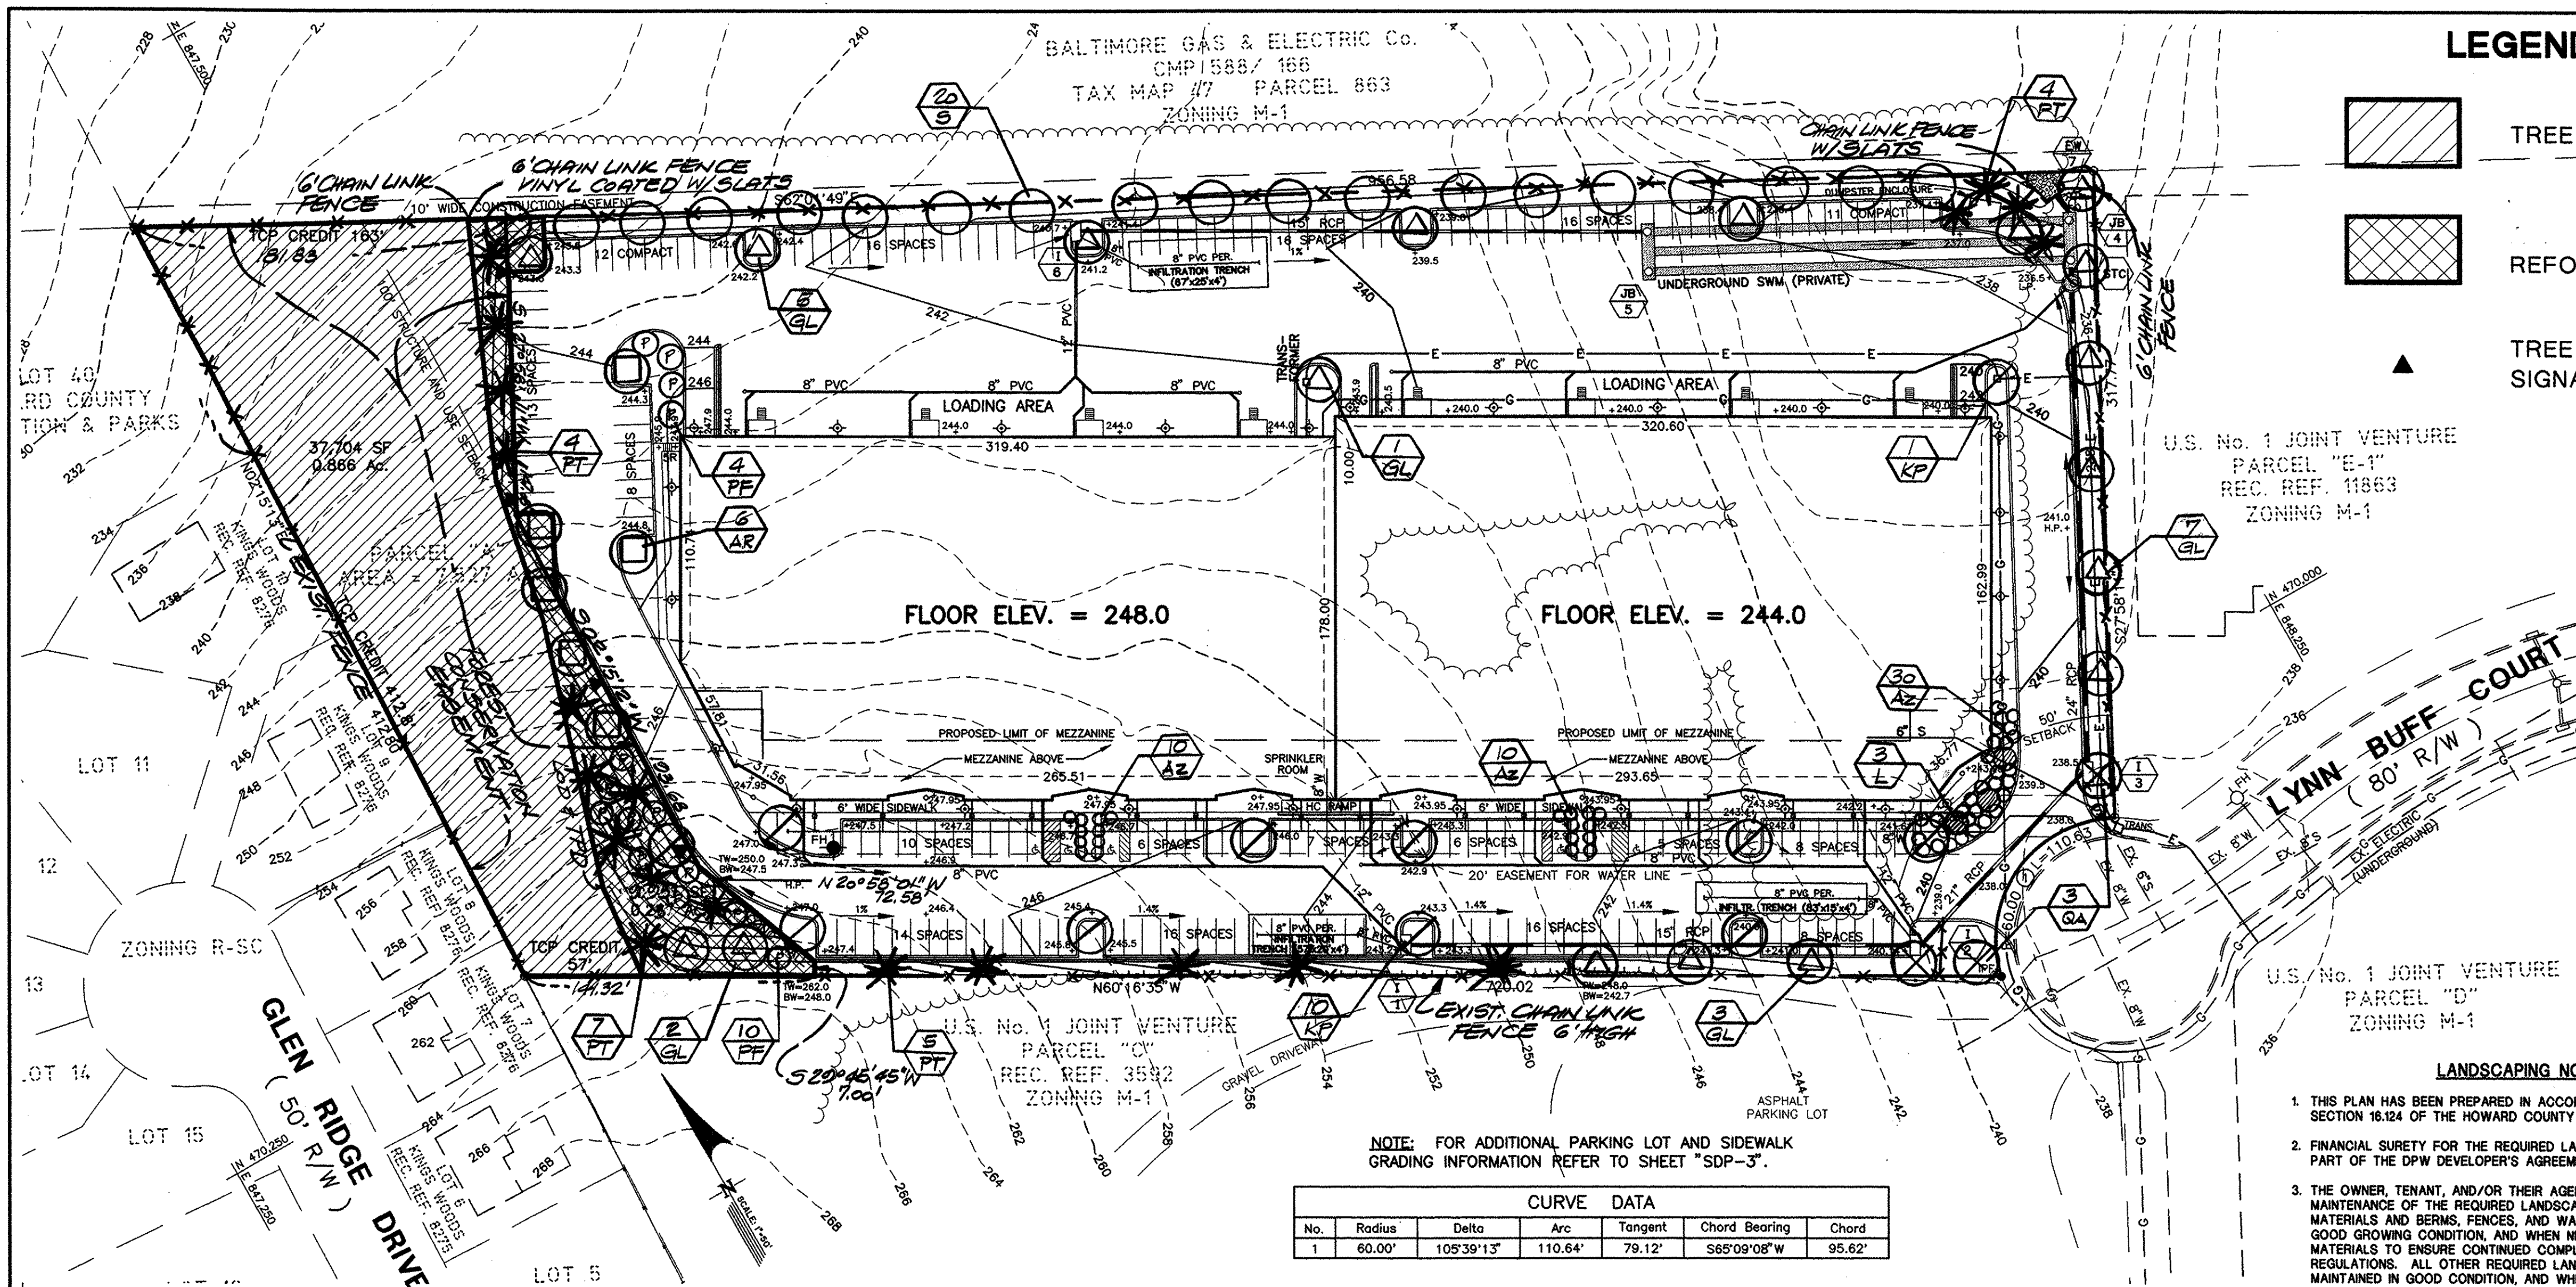

### LEGEND

- TREE PRESERVATION AREA
- REFORESTATION AREA
- TREE CONSERVATION SIGNAGE

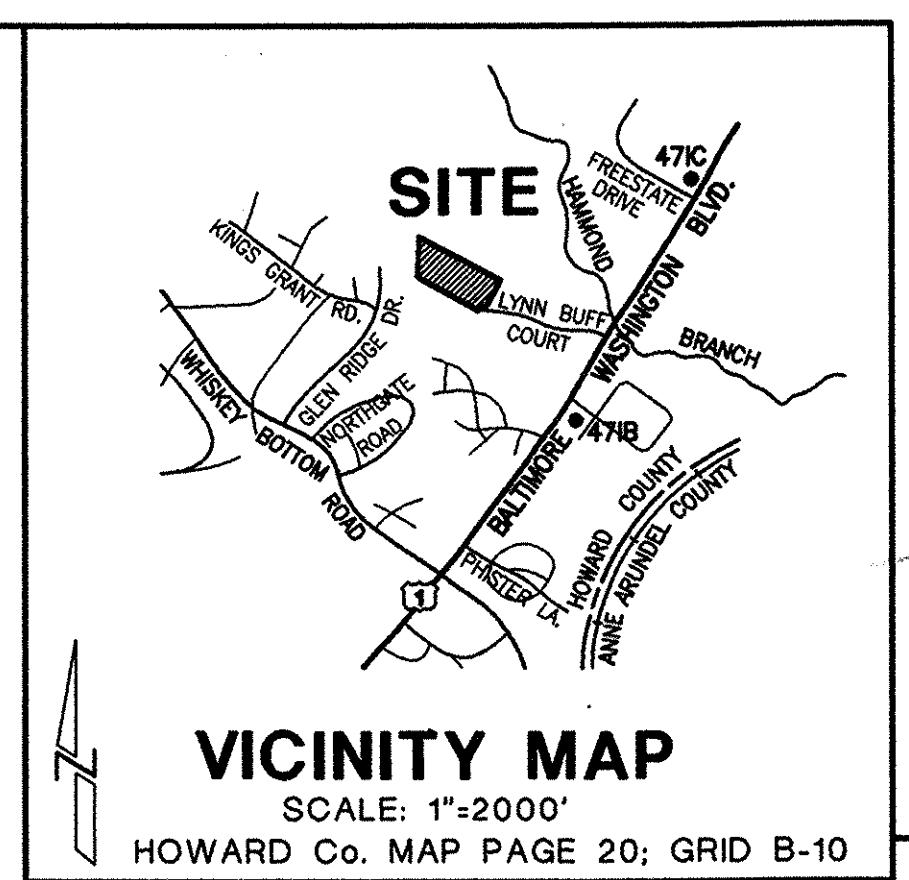

**DEVELOPER'S/BUILDER'S CERTIFICATE**

WE CERTIFY THAT THE LANDSCAPING SHOWN ON THIS PLAN WILL BE DONE ACCORDING TO THE PLAN, SECTION 16.124 OF THE HOWARD COUNTY CODE AND THE HOWARD COUNTY LANDSCAPE MANUAL. WE FURTHER CERTIFY THAT UPON COMPLETION A CERTIFICATION OF LANDSCAPE INSTALLATION ACCOMPANIED BY AN EXECUTED ONE YEAR GUARANTEE OF PLANT MATERIALS WILL BE SUBMITTED TO THE DEPARTMENT OF PLANNING AND ZONING.

JOSEPH NAZARIO OWNER  
NAZARIO DEVELOPMENT AND COMPANY  
FRED L. SKELTON - MD. REGISTRATION No. 9070  
IPDS, LLC

2-6-98 DATE  
05-01-98 DATE

APPROVED: HOWARD COUNTY DEPARTMENT OF PLANNING AND ZONING

10/6/98 DATE  
10/6/98 DATE  
10/1/98 DATE

**AS BUILT CERTIFICATE**

FRED L. SKELTON - MD. REGISTRATION No. 9070  
IPDS, LLC

DATE

### LANDSCAPING NOTES

- THIS PLAN HAS BEEN PREPARED IN ACCORDANCE WITH THE PROVISIONS OF SECTION 16.124 OF THE HOWARD COUNTY CODE AND THE LANDSCAPE MANUAL.
- FINANCIAL SURETY FOR THE REQUIRED LANDSCAPING HAS BEEN POSTED AS PART OF THE DPW DEVELOPER'S AGREEMENT IN THE AMOUNT OF \$41,190.00.
- THE OWNER, TENANT, AND/OR THEIR AGENTS SHALL BE RESPONSIBLE FOR MAINTENANCE OF THE REQUIRED LANDSCAPING, INCLUDING BOTH PLANT MATERIALS AND BERMS, FENCES, AND WALLS. ALL PLANT MATERIALS IN GOOD GROWING CONDITION, AND WHEN NECESSARY, REPLACED WITH NEW MATERIALS TO ENSURE CONTINUED COMPLIANCE WITH APPLICABLE REGULATIONS. ALL OTHER REQUIRED LANDSCAPING SHALL BE PERMANENTLY MAINTAINED IN GOOD CONDITION, AND WHEN NECESSARY, REPAIRED OR REPLACED.

CURVE DATA					
No.	Radius	Delta	Arc	Tangent	Chord Bearing
1	60.00'	105°39'13"	110.64'	79.12'	S65°09'08"W 95.62'

NOTE: FOR ADDITIONAL PARKING LOT AND SIDEWALK GRADING INFORMATION REFER TO SHEET "SDP-3".

### PLANTING SCHEDULE

CATEGORY	SYMBOL	BOTANICAL NAME	COMMON NAME	TYPE	SIZE	QUANTITIES			COST IN \$		
						STREET TREES	ON-SITE (PARKING LOT)	BUFFERS & SCREENING	MATERIALS	INSTALLATION	TOTAL COST
SHADE TREES	AR	ACER RUBRUM	RED MAPLE	C	2 1/2 - 3" CAL. B&B			8			
	GL	GLEDITSIA TRIACANTHOS INERMIS	HONEYLOCUST	C	2 1/2 - 3" CAL. B&B		6	12			
	QA	QUERCUS ACUTISSIMA	SAWTOOTH OAK	C	2 1/2 - 3" CAL. B&B	3					
	S	SOPHORA JAPONICA	REGENT SCHOLARTREE	C	2 1/2 - 3" CAL. B&B			20			
ORNAMENTALS AND EVERGREENS	KP	KOELREUTERIA PANICULATA	GOLDEN RAIN TREE	O	6 - 8" B&B		11				
	PF	PHOTINIA FRASERI	RED PHOTINIA	O	6 - 8" B&B			14			
	PT	PINUS THUNBERGII	JAPANESE BLACK PINE	E	6 - 8" B&B			20			
	AZ	AZALEA KURUME	AZALEA	S	18 - 24" CON.	30	20				
SHRUBS	L	LEUCODIUM GATESBAEII	DROOPING LEUCODIUM	S	18 - 24" CON.	3					

PERIMETER LANDSCAPE EDGE - SCHEDULE "A"						
CATEGORY	ADJACENT TO ROADWAYS	ADJACENT TO PERIMETER PROPERTIES				
		NORTH	EAST	SOUTH	WEST	
LANDSCAPE TYPE	E	C (DUMPSITE)	C (PERIMETER)	A	A	C
LINEAR FEET OF ROADWAY FRONTAGE / PERIMETER	110'	15'	986.68'	317.77'	720.02'	412.80'
CREDIT OF EXISTING VEGETATION	NONE	NONE	163'	NONE	67'	412.80'
CREDIT FOR WALL, FENCE, OR BERM	NONE	YES	YES	NONE	NONE	NONE
NUMBER OF PLANTS REQUIRED				OPTIONAL	OPTIONAL	EXIST. TREES PRESERVED
SHADE TREES	110/40x3	15/40x1	793.88/40x20	0	0	0
EVERGREEN TREES	0	15/20x1	0	0	0	0
SHRUBS	110/4x28	0	0	0	0	0
NUMBER OF PLANTS PROVIDED						
SHADE TREES	3	1	20	0	0	0
EVERGREEN TREES	0	0	0	0	0	0
OTHER TREES (21 SUB.)	33	0	0	0	0	0
SHRUBS						

SCHEDULE "B" PARKING LOT INTERNAL LANDSCAPING	
NUMBER OF PARKING SPACES	193 SPACES
NUMBER OF TREES REQUIRED (1 PER 20 SPACES)	193 ÷ 20 = 10
NUMBER OF TREES PROVIDED (SHADE TREES 121 SUBSTITUTION)	17
NUMBER OF PLANTING ISLANDS PROVIDED	10
LANDSCAPE ISLAND AREA PROVIDED	2,400 SF

### OWNER \ DEVELOPER

Joseph Nazario  
Nazario Development and Company  
6500 Ammendale Road  
Beltsville, Maryland 20705  
(301) 937-4664

### Woodland Conservation Worksheet for Non-Governmental Projects

Zone: M-1  
Gross Tract: 7.527 Ac.  
Floodplain: 7.527 Ac.  
Previously Dedicated Land-Net Tract: 7.527 Ac.  
Subdivision/Block/Lot: U.S. No. 1 Joint Venture - Parcel "A"

Woodland Conservation Calculations:

Existing Woodland WCT (15 % x Net tract)  
Smaller of a. or b.  
Woodland above WCT (a-b); if < 0 enter 0  
Woodland Cleared Smaller of d. or e.  
Clearing below WCT (e-f); if < 0 enter 0  
Replacement (f x 0.25) (g x 2.0)

Afforestation: (net tract x .2 - a), or (net tract x .15 - a) if < 0 enter 0  
Replacement required = (c+h+i+j-l-g) =

Woodland Conservation Provided: (acres)  
Woodland Preservation 0.87  
Reforestation/Replacement 0.25  
Afforestation 1.68 x \$0.30 x 43560 = \$21,956.24  
Area approved for fee-in-lieu Off-site Credits 2.80  
Woodland Conservation Provided (must equal or exceed item "m" above) 2.80


Additional woodland retained but not part of any requirements: \_\_\_\_\_ acres

Owner: Joseph Nazario, Nazario Dev. & Co.  
Address: 6500 Ammendale Road  
Beltsville, Maryland 20705  
(301) 937-4664  
Phone: 47, 81, 22/23  
Tax map/Grid/parcel: 47, 81, 22/23  
Permit #:


Net Tract (acres)	Floodplain (acres)
a. 6.78	k. N/A
b. 1.13	
c. 1.13	
d. 5.65	
e. 5.91	
f. 5.65	
g. 0.26	
h. 1.41	
i. 0.52	
j. 0.00	
m. 2.80	

Tree Conservation Plan Certified By:


Name: Siegfried W. Teichler  
Address: 802 Sligo Avenue  
Silver Spring, MD 20910  
License: RLA #230

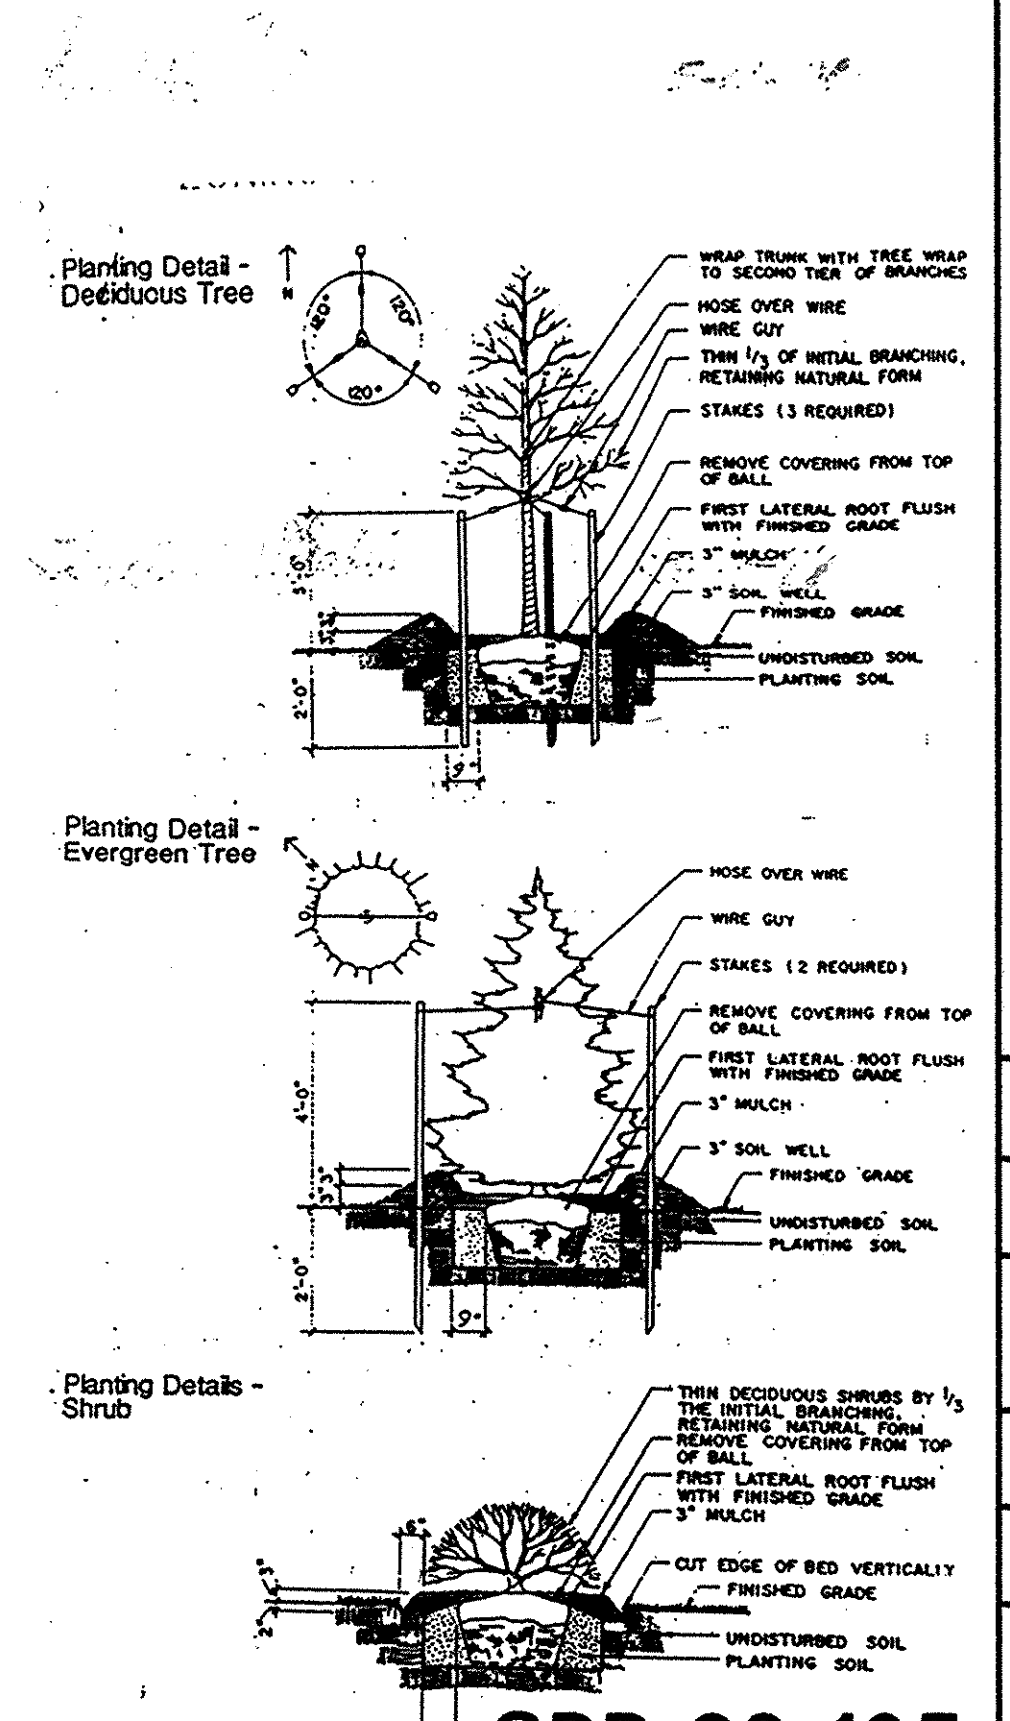




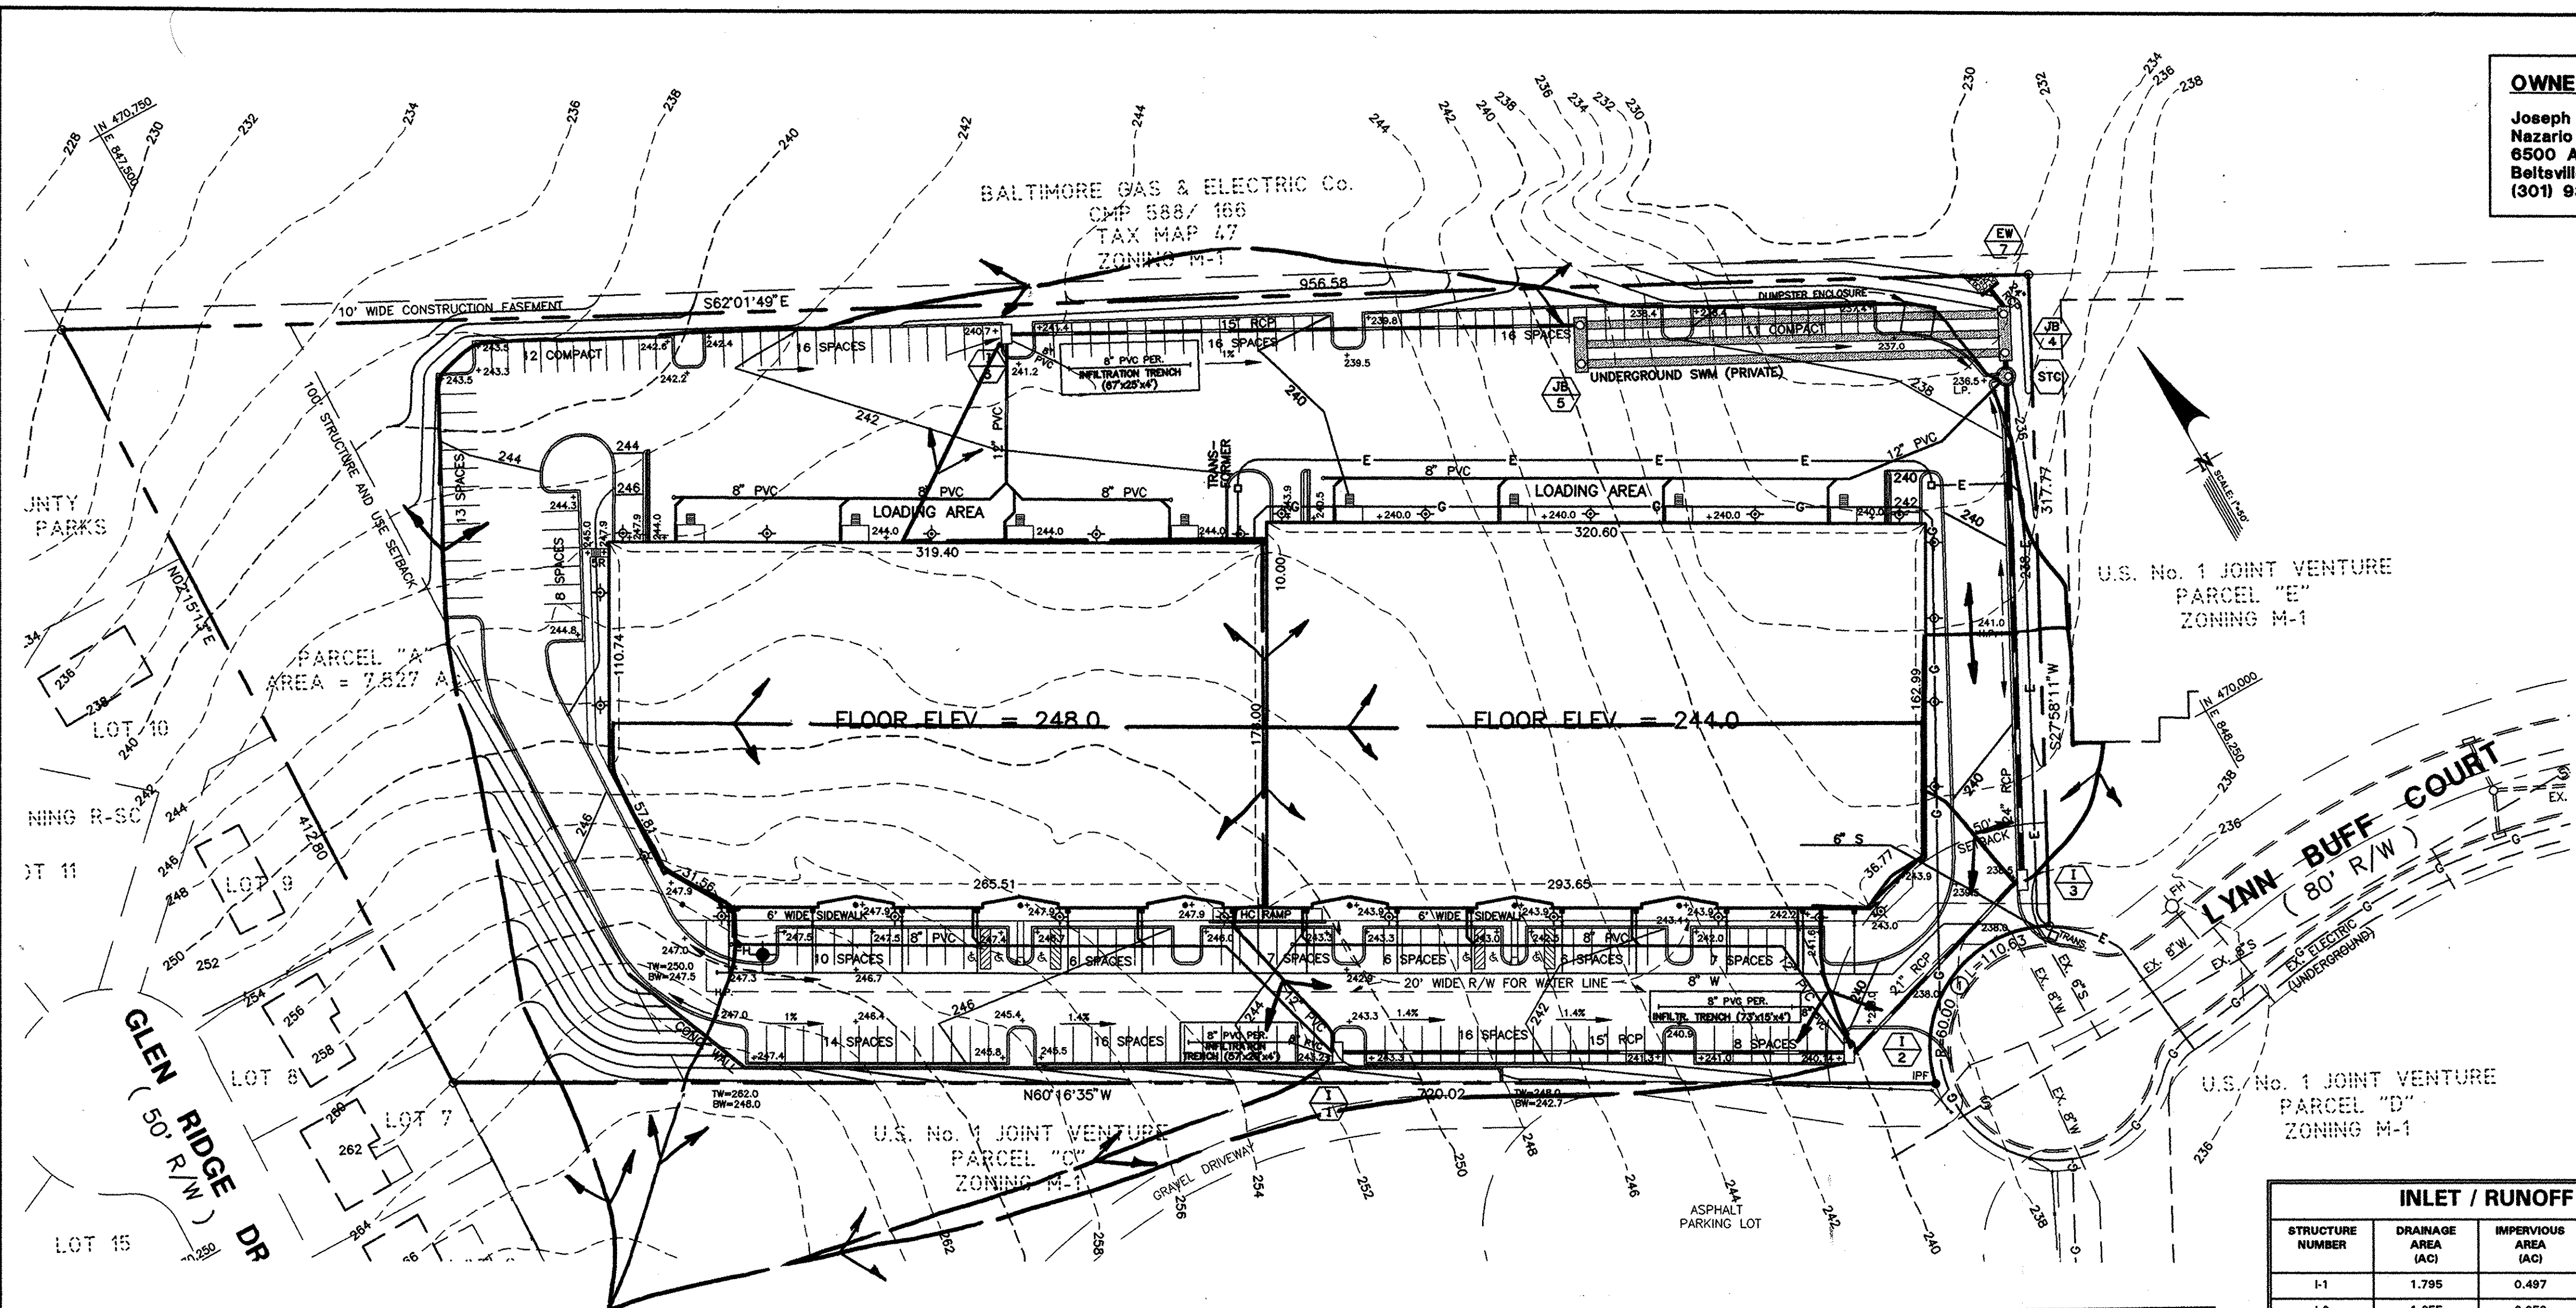

**DRAINAGE AREA MAP**  
SCALE: 1"=50'

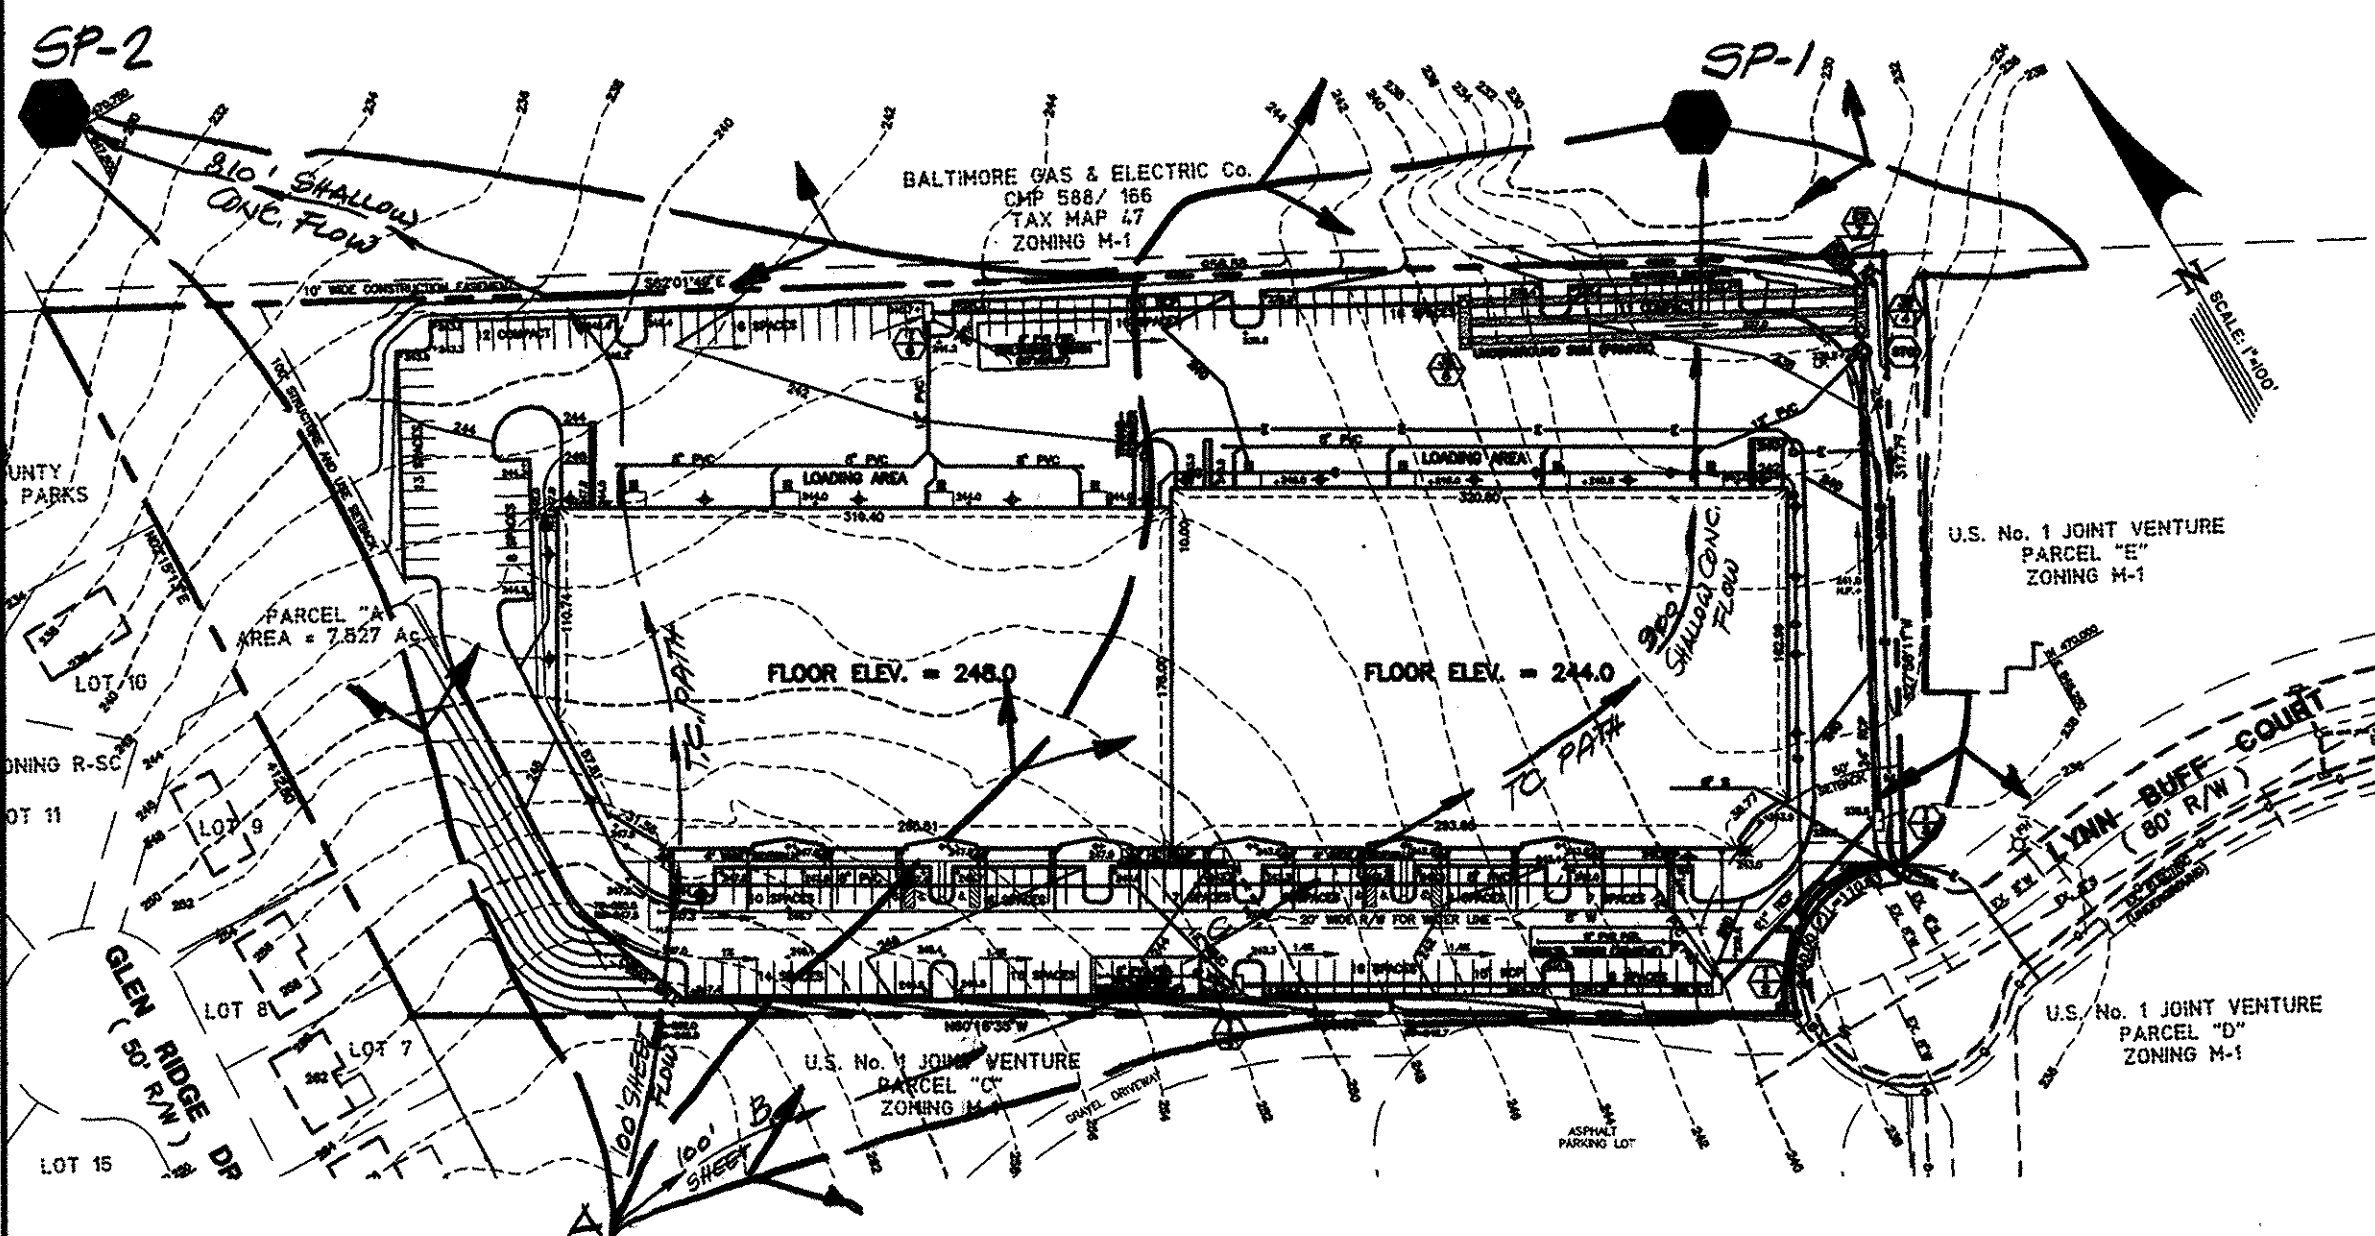

**PRE-DEVELOPMENT DRAINAGE AREA MAP**  
SCALE: 1"=100'

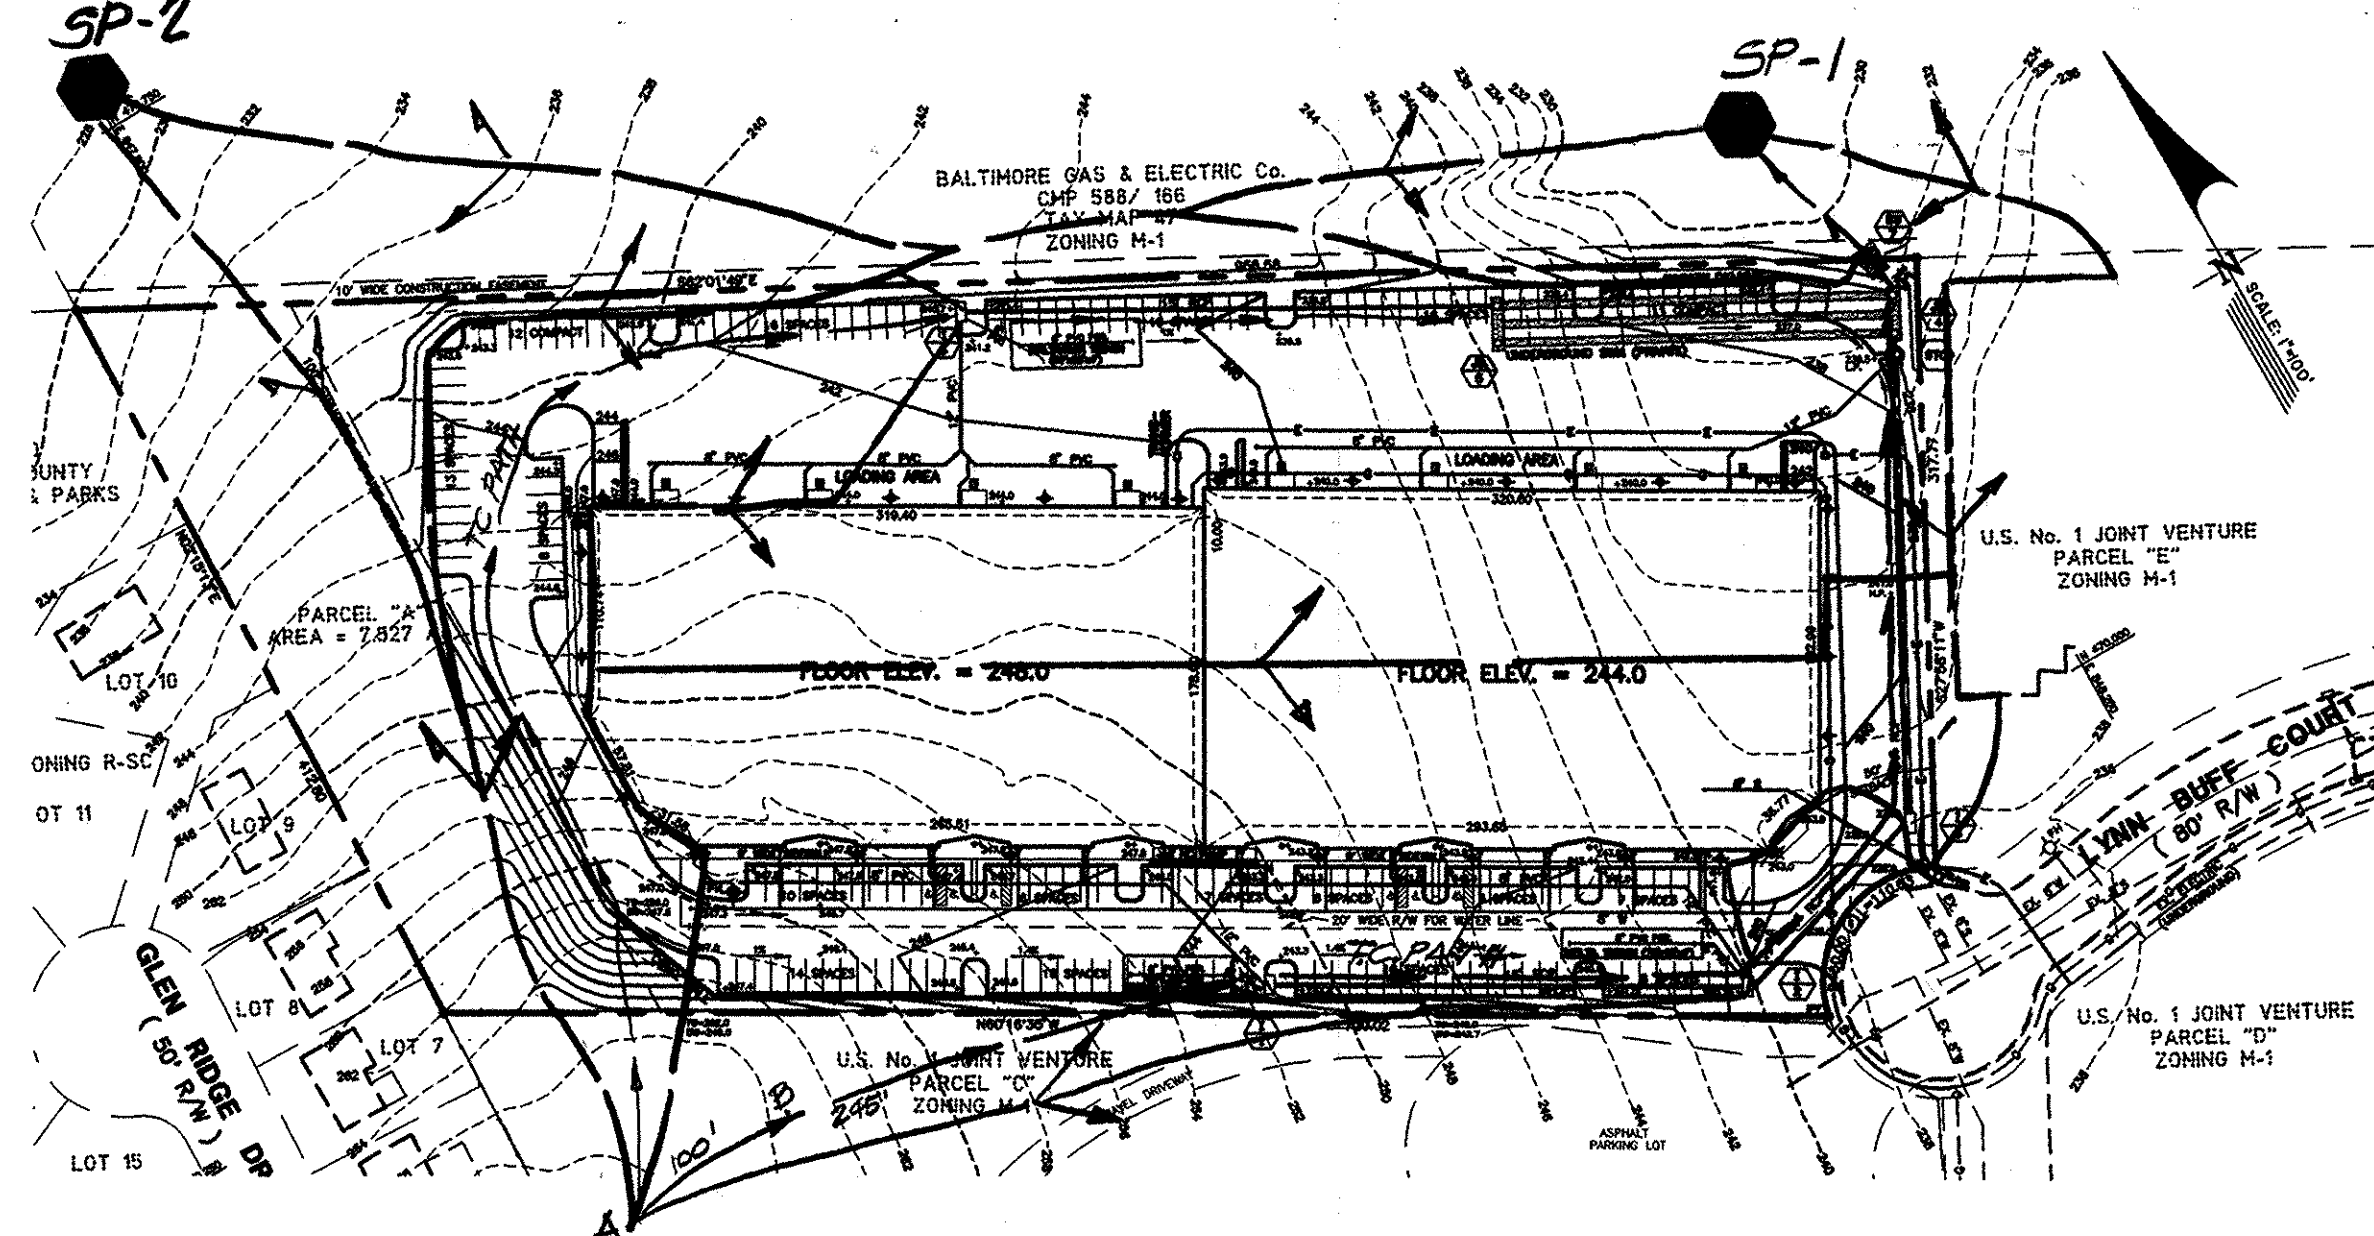


**POST-DEVELOPMENT DRAINAGE AREA MAP**  
SCALE: 1"=100'

HYDROLOGIC TABLE						
STUDY POINT	DRAINAGE AREA (ACRES)		CURVE NUMBER		TIME OF CONCENTRATION	
	PRE-DEVELOPED	POST-DEVELOPED	PRE-DEVELOPED	POST-DEVELOPED	PRE-DEVELOPED	POST-DEVELOPED
1	6.087	9.21	61	80	0.320	0.314
2	3.98	0.742	55	55	0.3125	0.216

INLET / RUNOFF TABLE				
STRUCTURE NUMBER	DRAINAGE AREA (AC)	IMPERVIOUS AREA (AC)	PERVIOUS AREA (AC)	TIME OF CONCENTRATION
I-1	1.795	0.487	0.798	17.2 min.
I-2	1.655	0.959	0.896	10.12 min.
I-3	0.108	0.079	0.029	5 min.
STCUB-4	1.939	1.246	0.009	5 min.
JB-5				
I-6	1.737	1.473	0.264	19.82 min.
EW-7				

**OWNER / DEVELOPER**  
Joseph Nazario  
Nazario Development and Company  
6500 Amundale Road  
Beltsville, Maryland 20705  
(301) 937-4664

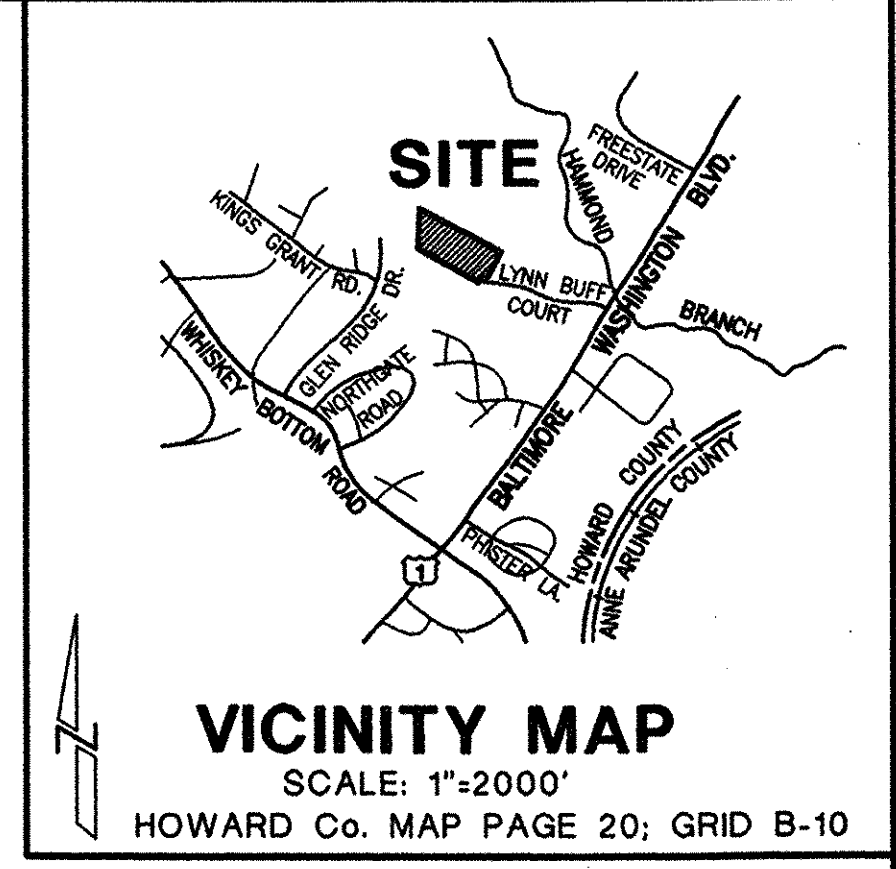

LEGEND	EXISTING		PROPOSED	
	DESCRIPTION	SYMBOL	DESCRIPTION	SYMBOL
PROPERTY LINE		---		---
TREELINE		~~~~~		~~~~~
CONTOUR LINE		---250---		---250---
SPOT ELEVATION		X 250		+ 250
STORMDRAIN PIPE		---		---
LIMIT OF DISTURBANCE		---		---
HANDICAPPED SPACE		---		---
FIRE HYDRANT		○ FH		○ FH
CURB & GUTTER		---		---
WHEELCHAIR RAMP		*		*
TOP OF WALL		---		---
BOTTOM OF WALL		---		---
DRAINAGE DIVIDE		---		---
STUDY POINT		○ S.P.		○ S.P.
TIME OF CONCENTRATION PATH (T.C. PATH)		---		---

BY THE DEVELOPER:  
I/WE CERTIFY THAT ALL DEVELOPMENT AND/OR CONSTRUCTION WILL BE DONE IN ACCORDANCE TO THESE PLANS AND THAT ANY RESPONSIBLE PERSONNEL INVOLVED IN THE CONSTRUCTION PROJECT WILL HAVE A CERTIFICATE OF ATTENDANCE AT A DEPARTMENT OF THE ENVIRONMENT APPROVED TRAINING PROGRAM FOR THE CONTROL OF SEDIMENT AND EROSION BEFORE BEGINNING THE PROJECT. I/WE WILL PROVIDE THE HOWARD SOIL CONSERVATION DISTRICT WITH AN AS-BUILT PLAN OF THE PROJECT WITHIN 90-DAYS OF COMPLETION. I/WE ALSO AUTHORIZE PERIODIC ON-SITE INSPECTIONS BY THE HOWARD SOIL CONSERVATION DISTRICT.  
*Joseph Nazario* 05-01-98  
JOSEPH NAZARIO, OWNER  
NAZARIO DEVELOPMENT AND COMPANY DATE

BY THE ENGINEER:  
I/WE CERTIFY THAT THIS PLAN FOR POST-CONSTRUCTION, SOIL EROSION AND SEDIMENT CONTROL REPRESENTS A PRACTICAL AND WORKABLE PLAN BASED ON MY PERSONAL KNOWLEDGE OF THE SITE CONDITIONS. THIS PLAN WAS PREPARED IN ACCORDANCE WITH THE REQUIREMENTS OF THE HOWARD SOIL CONSERVATION DISTRICT. I/WE HAVE ADVISED THE DEVELOPER THAT WE MUST PROVIDE THE HOWARD SOIL CONSERVATION DISTRICT WITH AN AS-BUILT PLAN OF THE PROJECT WITHIN 90-DAYS OF COMPLETION.  
*Fred L. Skelton* 05-01-98  
FRED L. SKELTON - MD, REGISTRATION No. 9070  
IPDS, LLC DATE

THESE PLANS FOR SOIL EROSION AND SEDIMENT CONTROL MEET THE REQUIREMENTS OF THE HOWARD SOIL CONSERVATION DISTRICT.  
*Cheryl Simmons* 9/30/98  
CHERYL SIMMONS, REGISTERED PROFESSIONAL ENGINEER  
NATURAL RESOURCES CONSERVATION SERVICE DATE

THESE PLANS HAVE BEEN REVIEWED FOR THE HOWARD SOIL CONSERVATION DISTRICT AND MEET THE TECHNICAL REQUIREMENTS FOR SOIL EROSION AND SEDIMENT CONTROL.  
*John R. Kuhn* 9/30/98  
JOHN R. KUHN, REGISTERED PROFESSIONAL ENGINEER  
HOWARD SOIL CONSERVATION DISTRICT DATE

APPROVED: HOWARD COUNTY DEPARTMENT OF PLANNING AND ZONING  
*David Smith* 10/6/98  
DIRECTOR DATE  
*Andy Hamilton* 10/5/98  
CHIEF, DIVISION OF LAND DEVELOPMENT DATE  
*Mike DeMunn* 10/1/98  
CHIEF, DEVELOPMENT ENGINEERING DIVISION DATE



802 Silgo Avenue  
Silver Spring, Maryland, 20910  
(301) 585-5676  
The Interprofessional  
**IPDS**  
PLANNING & DESIGN STUDIO, LLC  
Engineers • Architects • Surveyors  
Planners & Landscape Architects

**DRAINAGE AREA MAPS**


**U.S. No. 1 JOINT VENTURE**  
PARCEL "A", PLAT CMP No. 3592, WAREHOUSE  
GUILFORD ELECTION DISTRICT No. 6  
HOWARD COUNTY, MARYLAND  
CENSUS TRACT 6089.02, TAX MAP 47, BLOCK 22/23  
WATER CODE 004, SEWER CODE 7220000

**AS NOTED**  
SCALE:


REVISIONS:  
DATE: 04-30-98  
JOB NUMBER:  
**DA-1**  
SHEET 7 OF 13

**SDP-98-135**



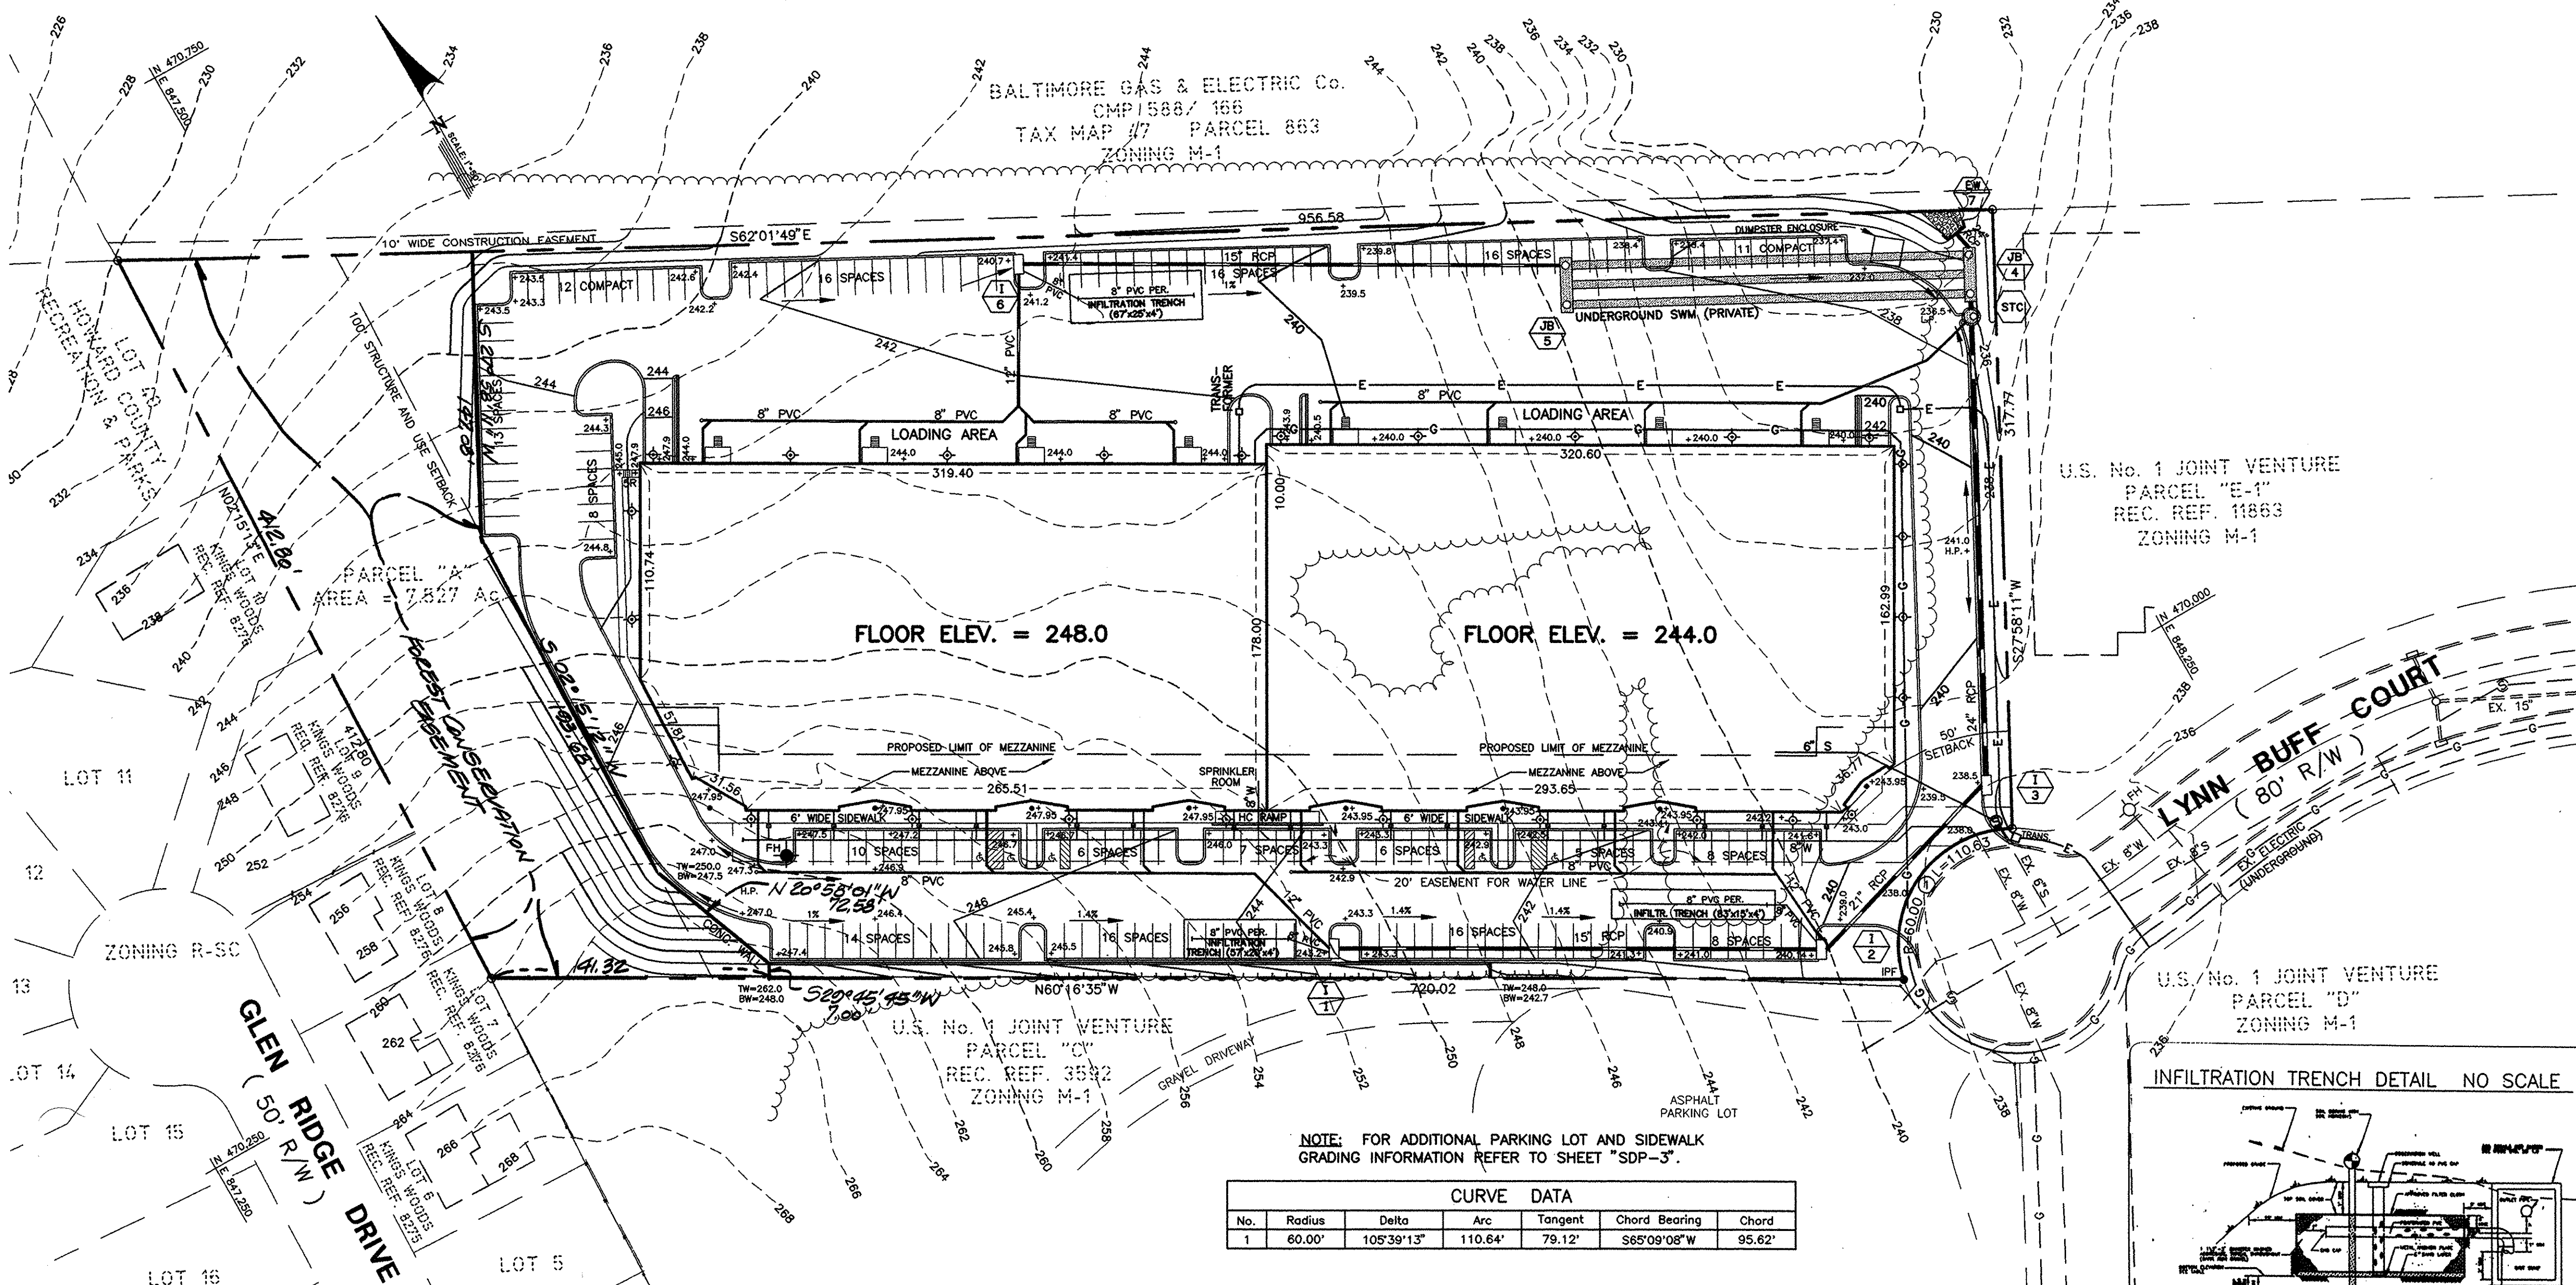

CURVE DATA					
No.	Radius	Delta	Arc	Tangent	Chord Bearing
1	60.00'	105°39'13"	110.64'	79.12'	S65°09'08"W 95.62'

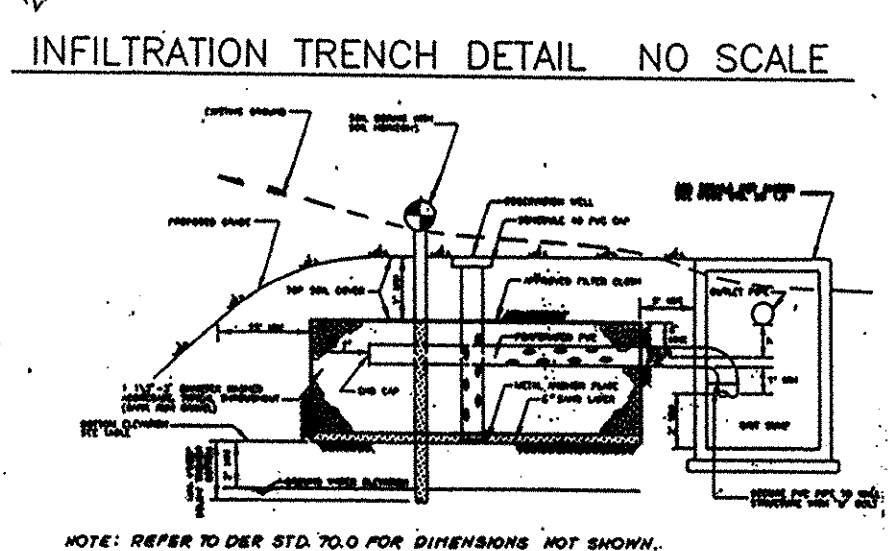

**OPERATION AND MAINTENANCE SCHEDULE  
FOR UNDERGROUND SWM QUANTITY STORAGE PIPES AND  
INFILTRATION TRENCH INLET STRUCTURE**


1. THE INFILTRATION TRENCH INLET STRUCTURES AND THE 48" DIA. UNDERGROUND STORMWATER STORAGE PIPES SHALL BE INSPECTED AND CLEANED EVERY SIX MONTHS TO MAINTAIN OPERATION AND FUNCTION. THE OWNER SHALL INSPECT THE INFILTRATION TRENCH INLET STRUCTURES, STORMCEPTOR AND UNDERGROUND STORAGE PIPES EVERY SIX MONTHS AT A MINIMUM AND AFTER ESPECIALLY SEVERE STORMS. WHEN SEDIMENT ACCUMULATION OF MORE THAN 2" OR ANY DEBRIS THAT MIGHT OBSTRUCT THE OPENING IS OBSERVED, THE FACILITY MUST BE CLEANED.
2. THE FACILITY SHALL BE CLEANED IMMEDIATELY AFTER PETROLEUM SPILLS. THE OWNER SHALL CONTACT APPROPRIATE REGULATORY AGENCIES.
3. THE MAINTENANCE OF THE INFILTRATION TRENCH INLETS AND STORMCEPTOR STRUCTURES SHALL BE DONE USING A VACUUM TRUCK WHICH WILL REMOVE THE WATER, SEDIMENT, DEBRIS, FLOATING HYDROCARBONS AND OTHER MATERIALS IN THE INLET. PROPER CLEANING AND DISPOSAL OF THE REMOVED MATERIALS AND LIQUID MUST BE FOLLOWED BY THE OWNER.
4. THE SEDIMENT DEBRIS SHALL BE REMOVED FROM THE 48" DIA. STORAGE PIPES BY VACUUM TRUCK OR OTHER MANUAL MEANS.
5. THE UNDERGROUND STORAGE PIPES CONTROL STRUCTURE SHALL BE CHECKED FOR ANY OBSTRUCTION AT LEAST EVERY SIX MONTHS. IF OBSTRUCTIONS ARE FOUND THE OWNER SHALL HAVE THEM REMOVED.
6. THE OWNER SHALL PROVIDE CORRECTIVE MAINTENANCE ANY TIME THE TRENCHES DO NOT DRAIN DOWN COMPLETELY WITHIN 96 HOURS.
7. THE OWNER SHALL RETAIN AND MAKE THE INSPECTION/MONITORING FORMS AVAILABLE TO THE HOWARD COUNTY OFFICIALS UPON THEIR REQUEST.
8. THE SWM SYSTEM IS TO BE PRIVATELY OWNED AND MAINTAINED.

NO.	TYPE	WIDTH DIAM.	TOP ELEV.	INV. ELEV.	STANDARD DETAIL
1	INLET A-5	6' x 5'	243.70	236.83	SD 4.01
2	INLET A-5	5' x 5'	240.54	232.78	SD 4.01
3	INLET A-10	2.5' x 10'	238.50	235.00	SD 4.02
4	JUNCTION BOX A-5	6' x 5'	237.50	231.00	SEE DETAIL
5	JUNCTION BOX		238.90	232.00	SEE DETAIL
6	INLET A-5	5' x 5'	241.20	234.93	SD 4.01
7	ENDWALL TYPE "C"	24"	234.20	230.70	SD 5.21
STC	STORMCEPTOR	96" DIA.	237.50	226.00	STC 2400

FROM	TO	SIZE	TYPE	LENGTH (FEET)
1	2	15" RCP	CL IV	244
2	3	21" RCP	CL IV	116
3	STC	24" RCP	CL IV	230
STC	4	24" RCP	CL IV	4
4	7	24" RCP	CL III	11
5	6	15" RCP	CL IV	272
6	4	TRIPLE 48"	CMP	600

SIZE	TYPE	LENGTH
15"	RCP CL IV	516
21"	RCP CL IV	116
24"	RCP CL III	11
24"	RCP CL IV	234
48"	CMP	600

- NOTE: REFER TO DER STD. 70.0 FOR DIMENSIONS NOT SHOWN.
- NOTE: TRENCH SHALL BE FILLED WITH 1/2" TO 3/4" WASHED BANK-RUN GRAVEL OR NO. 8 OR #3 WASHED CRUSHED BLUESTONE. BLUESTONE MUST BE OBTAINED FROM AN APPROVED SUPPLIER.
- INFILTRATION TRENCH GENERAL NOTES AND SPECIFICATIONS
1. INFILTRATION SYSTEM MAY NOT RECEIVE RUNOFF UNTIL THE ENTIRE CONTIGUOUS DRAINAGE AREA TO THE INFILTRATION TRENCH HAS RECEIVED RAINFALL STABILIZATION.
  2. HEAVY EQUIPMENT AND TRAFFIC SHALL BE RESTRICTED FROM TRAVELLING OVER INFILTRATION AREAS TO MINIMIZE COMPACTION OF THE SOIL.
  3. EXCAVATE THE TRENCH TO THE DESIGN DIMENSIONS. EXCAVATED MATERIALS SHALL BE PLACED AWAY FROM THE TRENCH TO PREVENT SOIL FROM BEING BLOWN INTO THE TRENCH OR TO PREVENT SOIL FROM BEING BLOWN INTO THE TRENCH DURING SUBSEQUENT INSTALLATION PROCEDURE. THE DEBRIS OF THE TRENCH SHALL BE SOOTHED WITHIN THE TRENCH AND BEAD BY HEAVY EQUIPMENT.
  4. A LIST OF NON-WOVEN FABRICS THAT MEET HOWARD COUNTY SPECIFICATIONS ARE AS FOLLOWS. ANY ALTERNATIVE FILTER FABRIC MUST BE APPROVED BY THE ENGINEER AND HOWARD COUNTY.
  5. EACH ROLL MUST BE CUT TO THE PROPER WIDTH PRIOR TO INSTALLATION. THE CUT WIDTH MUST INCLUDE SUFFICIENT MATERIAL TO CONFORM TO TRENCH DIMENSIONS AND FOR A 1 INCH MINIMUM TOP OVERLAP. THE FILTER FABRIC SHALL BE PLACED ON THE BOTTOM OF THE INFILTRATION TRENCH FOR A DISTANCE OF 5 TO 11 INCHES. STONES OR OTHER ANCHORING OBJECTS SHOULD BE PLACED ON THE FABRIC AT THE JOINTS OF THE TRENCH TO HOLD THE TRENCH OPEN DURING WINDY WEATHER. WHEN OVERLAPS ARE REQUIRED BETWEEN ROLLS, THE OVERLAP SHALL BE IN ORDER TO PROVIDE A MINIMUM 12 INCH OVERLAP.
  6. A 6 INCH SAND FILTER LAYER SHALL BE PLACED ON THE BOTTOM OF THE INFILTRATION TRENCH AND COMPACTED USING PLATE COMPACTORS. THE SAND FOR THE INFILTRATION TRENCH SHALL BE WASHED AND MEET ASTM STD. NO. 3 OR NO. 10. ANY ALTERNATIVE SAND GRADATION MUST BE APPROVED BY THE ENGINEER AND HOWARD COUNTY.
  7. A MAXIMUM LOOSE LAY THICKNESS OF 12 INCHES IS RECOMMENDED. THE GRAVEL FOR THE INFILTRATION TRENCH SHALL BE WASHED AND MEET ONE OF THE FOLLOWING AGGREGATE AND STD. NO. 3 OR 3. ANY ALTERNATIVE GRAVEL GRADATION MUST BE APPROVED BY THE ENGINEER AND HOWARD COUNTY. FOLLOWING THE STONE AGGREGATE PLACEMENT, THE FILTER FABRIC SHALL BE PLACED OVER THE STONE AGGREGATE TO FORM A 6 INCH MINIMUM LONGITUDINAL LAP. THE OVERLAP SHALL BE 6 INCHES OR MORE. THE SAND SHALL BE PLACED OVER THE LAP AT SUFFICIENT INTERVALS TO MAINTAIN THE LAP DURING SUBSEQUENT BACKFILLING.
  8. CARE SHALL BE EXERCISED TO PREVENT NATURAL OR FILL SOIL FROM INTERMIXING WITH THE STONE AGGREGATE. ALL CONTAMINATED STONE AGGREGATE SHALL BE REMOVED AND REPLACED WITH UNCONTAMINATED STONE AGGREGATE.
  9. Voids CAN BE CREATED BETWEEN THE FABRIC AND EXCAVATED AREAS AND SHALL BE AVOIDED. REMOVING Boulders OR OTHER OBJECTS FROM THE TRENCH SHALL BE DONE BY HAND. NATURAL SOIL SHOULD BE PLACED IN THESE VOIDS AT THE MOST CONVENIENT TIME DURING CONSTRUCTION TO INSURE FABRIC CONFORMITY TO THE EXCAVATION EDGE.
  10. VERTICALLY EXCAVATED WALLS MAY BE DIFFICULT TO MAINTAIN IN AREAS WHERE THE SOIL MOISTURE IS HIGH OR WHERE SOFT CONVEYOR OR CONVEYABLE SOILS PREDOMINATE. THESE CONDITIONS MAY REQUIRE LAYING BACK OF THE SIDE SLOPES TO MAINTAIN STABILITY.
  11. PVC DISTRIBUTION PIPES SHALL BE 48" AND MEET ASTM STD. D 3034. PERFORATIONS SIZE AND SPACING SHALL MEET ASTM STD. D 2728. PERFORATED PIPE SHALL BE PROVIDED ONLY WITHIN THE INFILTRATION TRENCH AND SHALL TERMINATE 1 FOOT SHORT OF THE INFILTRATION TRENCH WALL. THE END OF THE PVC PIPE SHALL BE CAPPED.
  12. THE OBSERVATION WELL IS TO CONSIST OF 4-INCH TO 6-INCH DIAMETER PVC PIPE WITH A CAP AT GROUND LEVEL AND IS TO BE LOCATED IN THE LONGITUDINAL CENTER OF THE INFILTRATION TRENCH. A PERFORATED PVC PIPE SHALL BE PROVIDED AND PLACED VERTICALLY WITHIN THE INFILTRATION TRENCH. A CAP PROVIDED AT THE BOTTOM OF THE PIPE. THE BOTTOM OF THE PIPE SHALL REST ON THE TRENCH BOTTOM.

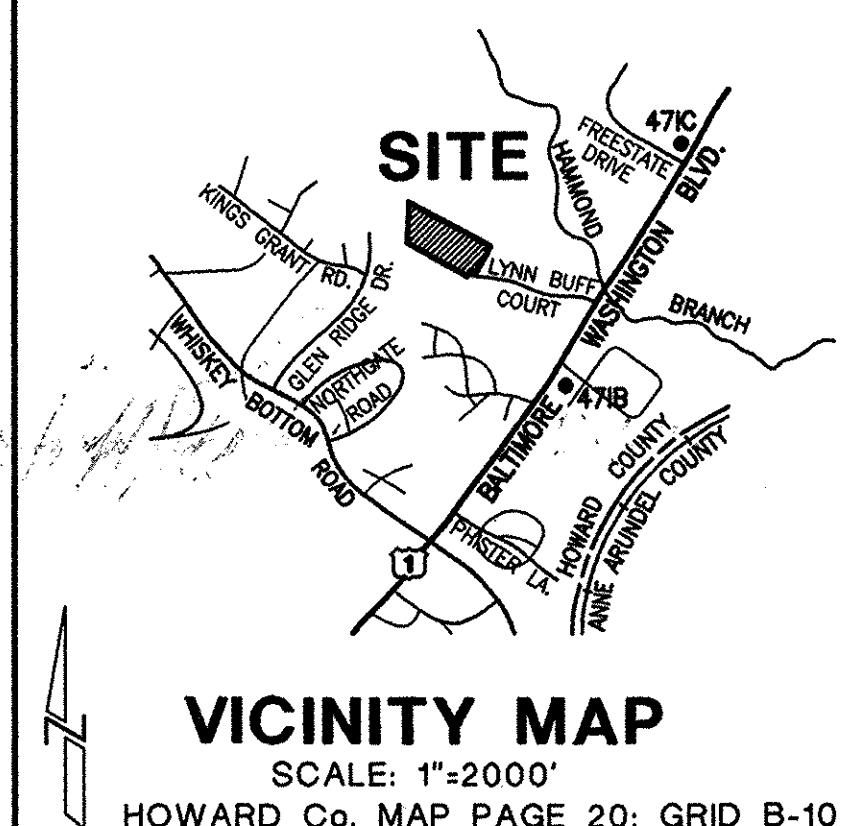

BY THE DEVELOPER:

I/WE CERTIFY THAT ALL DEVELOPMENT AND/OR CONSTRUCTION WILL BE DONE IN ACCORDANCE TO THESE PLANS AND THAT ANY RESPONSIBLE PERSONNEL INVOLVED IN THE CONSTRUCTION PROJECT WILL HAVE A CERTIFICATE OF ATTENDANCE AT A DEPARTMENT OF THE ENVIRONMENT APPROVED TRAINING PROGRAM FOR THE CONTROL OF SEDIMENT AND EROSION BEFORE BEGINNING THE PROJECT. I/WE WILL PROVIDE THE HOWARD SOIL CONSERVATION DISTRICT WITH AN AS-BUILT PLAN OF THE PROJECT WITHIN 90 DAYS OF COMPLETION. I/WE ALSO AUTHORIZE PERIODIC ON-SITE INSPECTIONS BY THE HOWARD SOIL CONSERVATION DISTRICT.

JOSEPH NAZARIO, OWNER  
NAZARIO DEVELOPMENT AND COMPANY  
5-1-98 DATE

BY THE ENGINEER:

I/WE CERTIFY THAT THIS PLAN FOR CONSTRUCTION, SOIL EROSION AND SEDIMENT CONTROL REPRESENTS A PRACTICAL AND WORKABLE PLAN BASED ON MY PERSONAL KNOWLEDGE OF THE SITE CONDITIONS. THIS PLAN WAS PREPARED IN ACCORDANCE WITH THE REQUIREMENTS OF THE HOWARD SOIL CONSERVATION DISTRICT. I/WE WILL PROVIDE THE HOWARD SOIL CONSERVATION DISTRICT WITH AN AS-BUILT PLAN OF THE PROJECT WITHIN 90 DAYS OF COMPLETION.

FRED L. SKELTON, MD. REGISTRATION NO. 9070  
IPDS, LLC  
6/5/98 DATE

THESE PLANS FOR SOIL EROSION AND SEDIMENT CONTROL MEET THE REQUIREMENTS OF THE HOWARD SOIL CONSERVATION DISTRICT.

CHIEF, DIVISION OF LAND DEVELOPMENT  
9/30/98 DATE

THESE PLANS HAVE BEEN REVIEWED FOR THE HOWARD SOIL CONSERVATION DISTRICT AND MEET THE TECHNICAL REQUIREMENTS FOR SOIL EROSION AND SEDIMENT CONTROL.


JOHN R. BLANTON  
HOWARD SOIL CONSERVATION DISTRICT  
9/30/98 DATE

APPROVED: HOWARD COUNTY DEPARTMENT OF PLANNING AND ZONING

10/6/98 DATE

CHIEF, DEVELOPMENT ENGINEERING DIVISION  
10/5/98 DATE

10/1/98 DATE

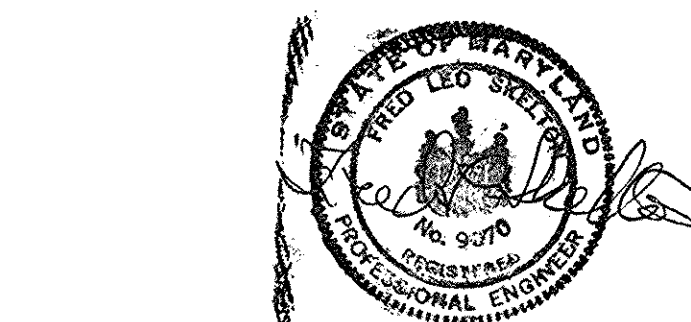

**OWNER \ DEVELOPER**

Joseph Nazario  
Nazario Development and Company  
6500 Ammendale Road  
Beltsville, Maryland 20705  
(301) 937-4664

**SDP-98-135**

**IPDS**  
The Interprofessional  
PLANNING & DESIGN STUDIO, LLC  
Engineers • Architects • Surveyors  
Planners & Landscape Architects

802 Silgo Avenue  
Silver Spring,  
Maryland, 20910  
(301) 585-5676

**STORMWATER  
MANAGEMENT PLAN**

**U.S. No. 1 JOINT VENTURE**  
PARCEL "A", PLAT CMP No. 3592, WAREHOUSE  
GUILFORD ELECTION DISTRICT No. 6  
HOWARD COUNTY, MARYLAND  
CENSUS TRACT 6089.02, TAX MAP 47, BLOCK 22/23  
WATER CODE C04, SEWER CODE 7220000

SCALE: 1"=50'

REVISIONS:

06-18-98

DATE: 01-28-98



JOB NUMBER:

**SWM-1**

SHEET 8 OF 13

**SDP-98-135**



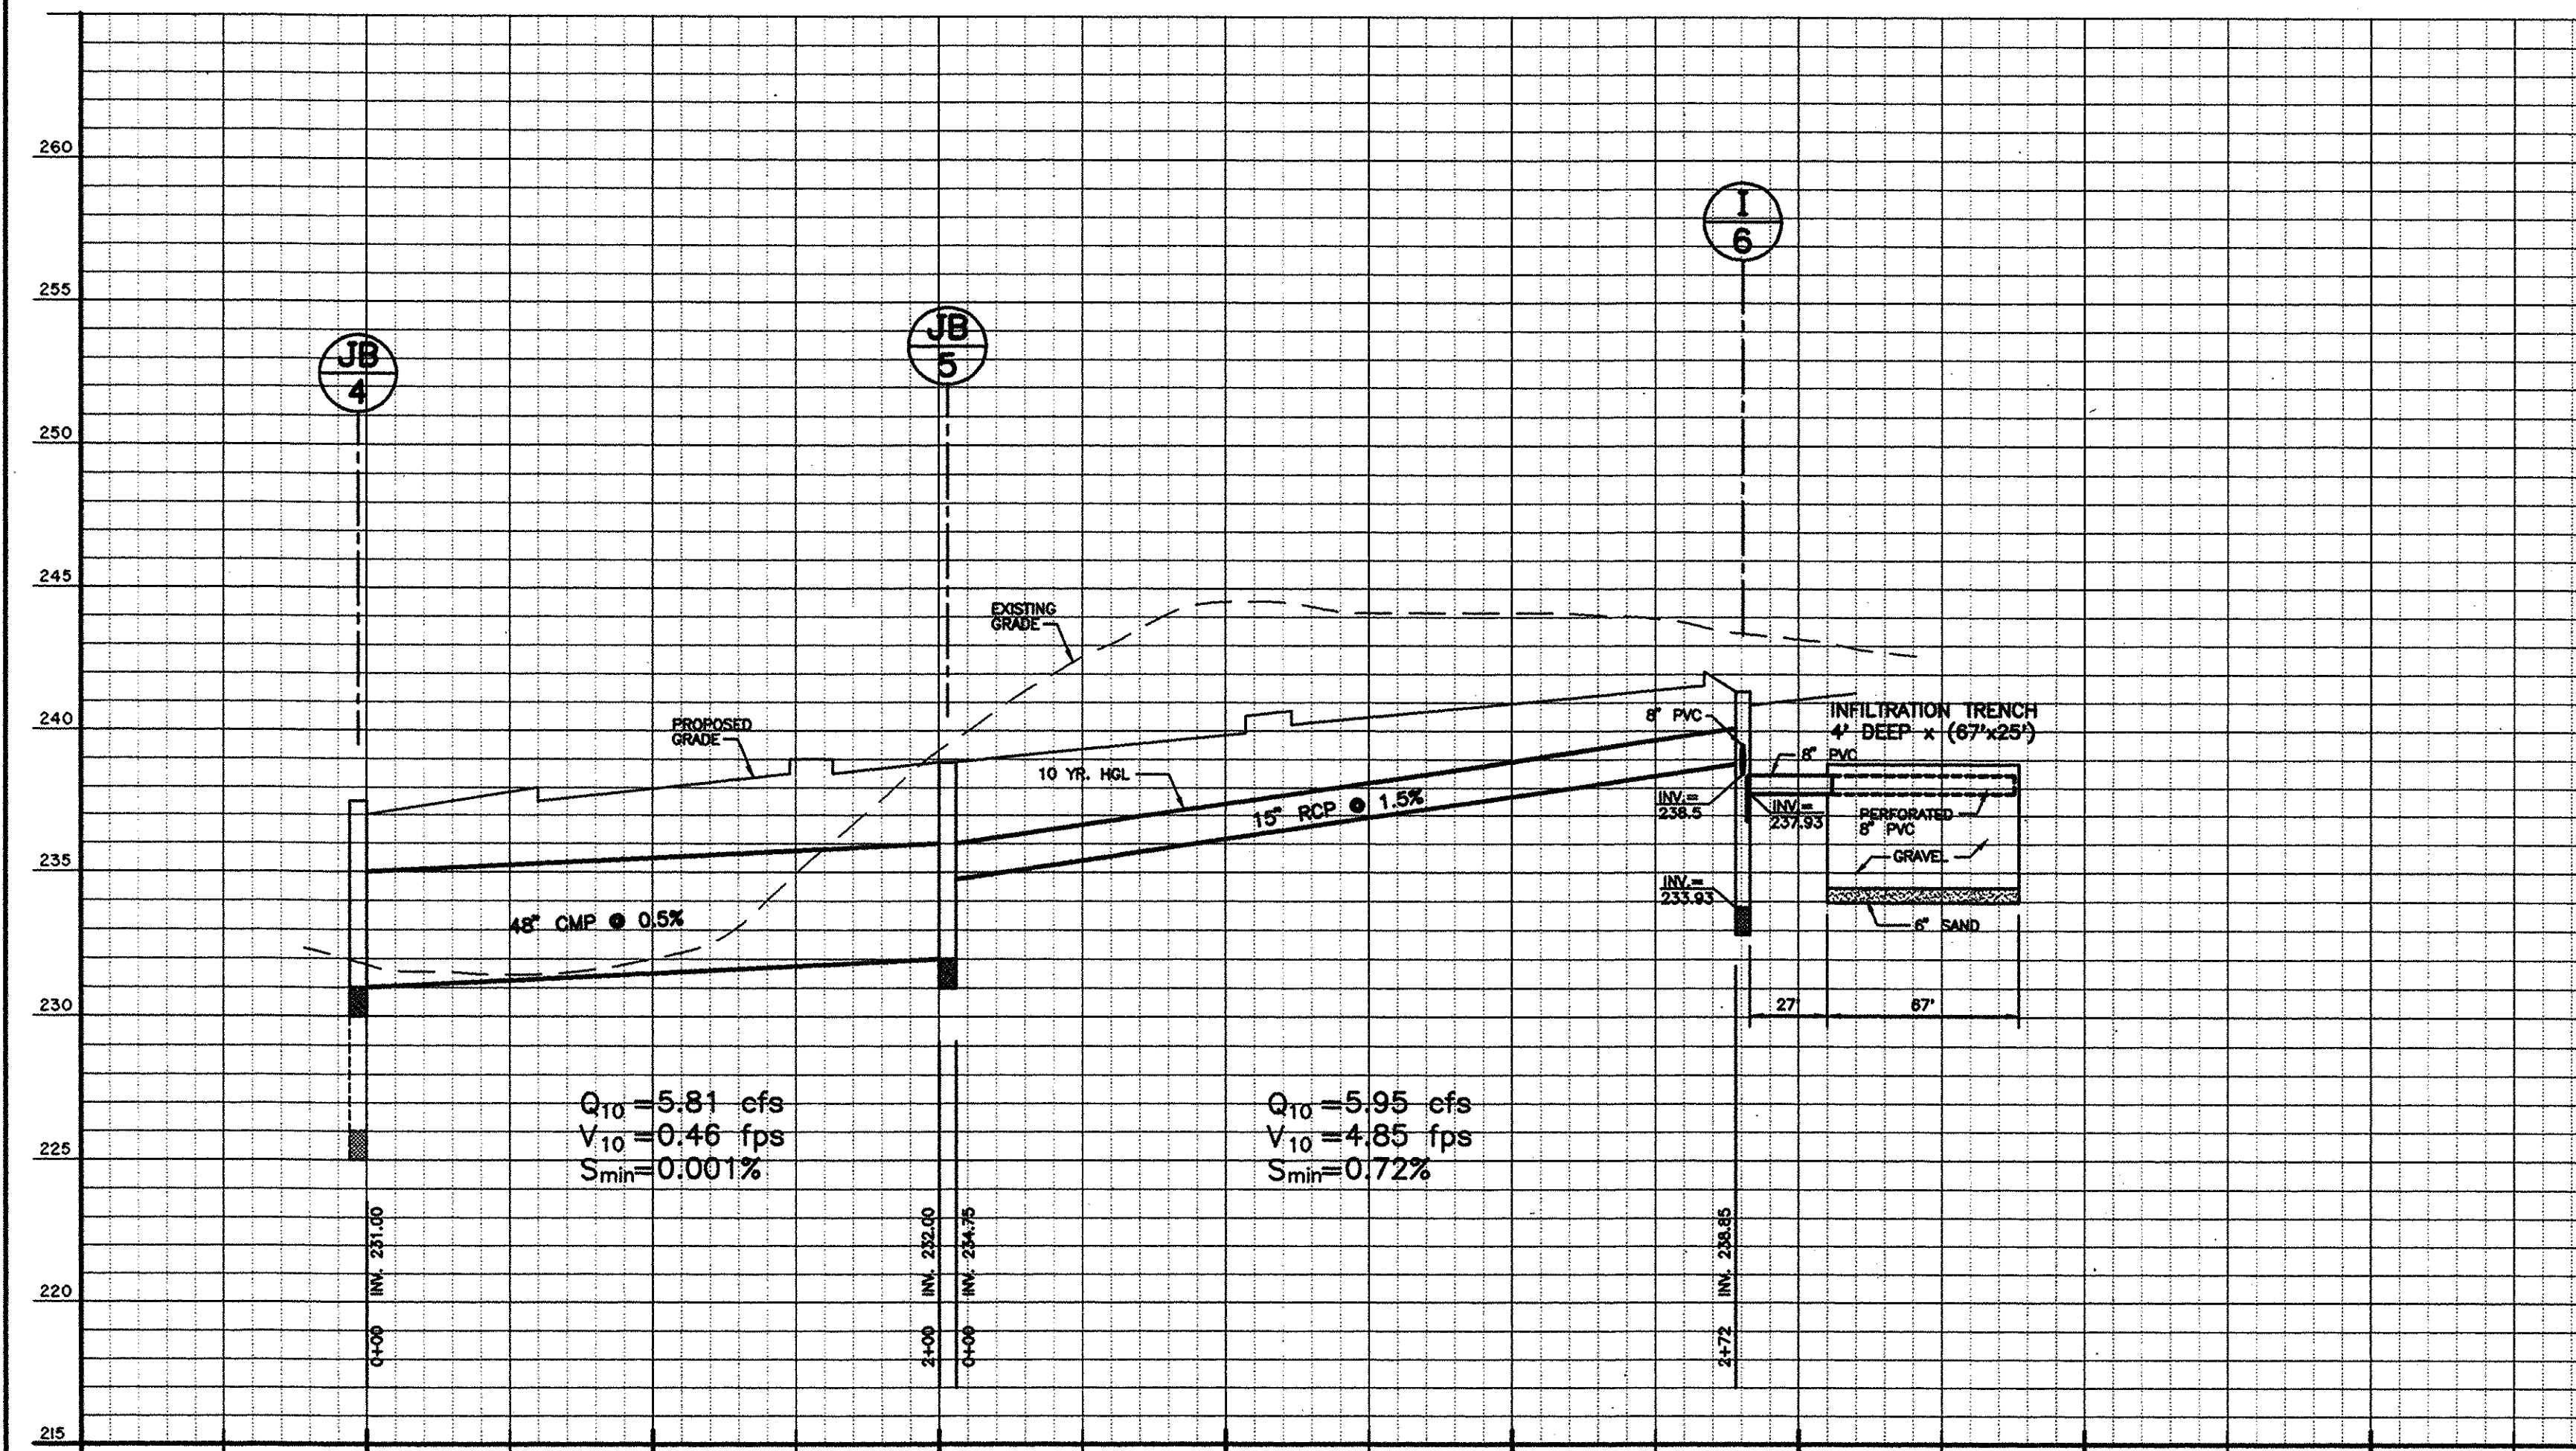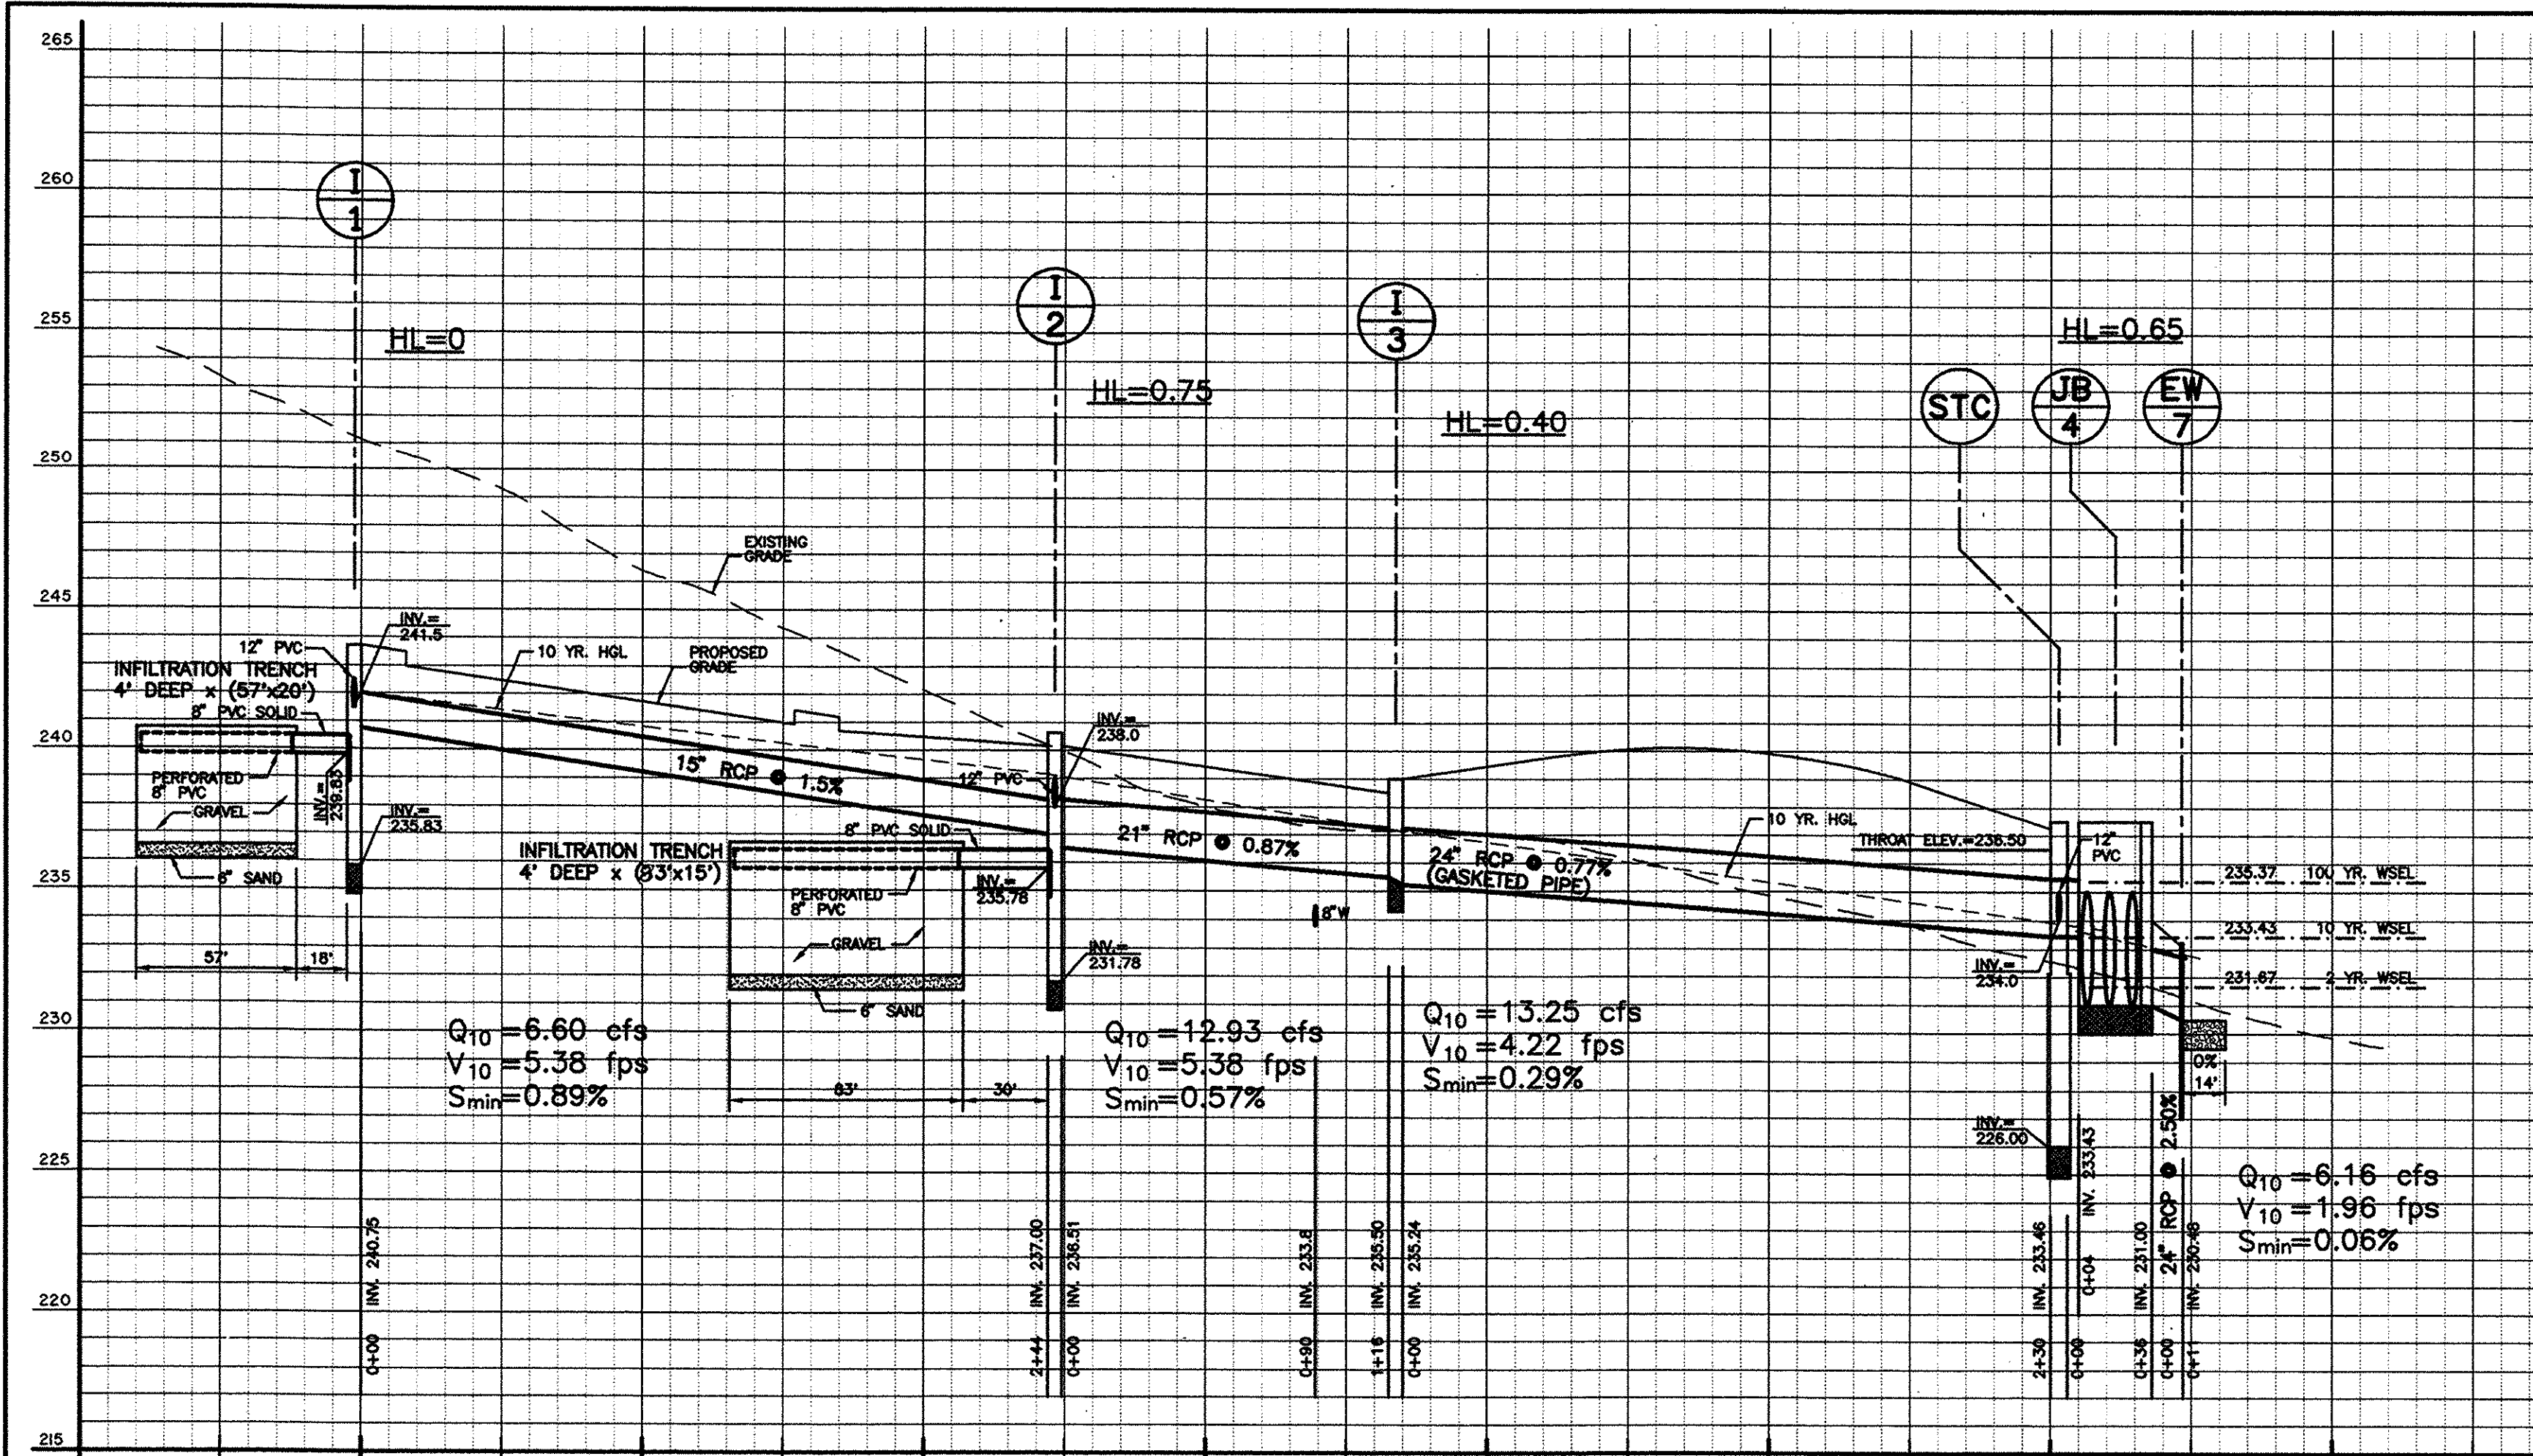

# **CONTRACTOR INSTALLATION INSTRUCTIONS:** **PRECAST CONCRETE STORMCEPTOR**

STAKEOUT-OUT THE LOCATION OF THE STORMCEPTOR AND EXCAVATE HOLE. EXCAVATE ADEQUATE SPACE TO CONNECT INLET AND OUTLET PIPES TO UNIT. INSTALL A 12" DEEP (OR AS REQUIRED) LAYER OF COMPACTED AGGREGATE SUBBASE AT THE BOTTOM OF THE EXCAVATION. INSTALL MULE OR SHORING AS NEEDED.

CHECK ELEVATION OF UNIT BY MEASURING ITS SECTIONS FROM BASE OF THE STORAGE CHAMBER (BOTTOM OF UNIT'S SLAB) TO THE INVERT OF STORMCEPTOR BYPASS CHAMBER INLET ELEVATION (FIBERGLASS INSERT). SUBTRACT THIS DISTANCE FROM DESIGN INVERT ELEVATION TO DETERMINE TOP OF SUBBASE ELEVATION. CHECK ELEVATION OF INSTALLED SUBBASE AND ADJUST AS NEEDED.

SECURE INSPECTOR APPROVAL OF SUBGRADE AND SUBBASE.

INSTALL STORAGE CHAMBER. INSTALL SCREW INSERTS INTO BASE OF STORAGE CHAMBER. ATTACH CABLES OF CHAINS TO ALL 3 LIFT LUGS ON THE BASE SLAB. USING LARGE EQUIPMENT OR CRANE LIFT AND PLACE THE BASE SECTION OF THE STORAGE CHAMBER IN THE EXCAVATED HOLE ON THE SUBBASE. MAKE SURE THE BASE IS LEVEL. SPECIFIC ALIGNMENT OF THIS PART IS NOT REQUIRED. INSTALL RUBBER GASKET ON BASE UNIT AND COAT WITH LUBRICATING GREASE (PROVIDED IN SHIPMENT), IF NOT PRELUBRICATED. INSTALL ADDITIONAL STORAGE CHAMBER SECTIONS, AS REQUIRED (PROCEDURE IS SAME AS STEP 8).

FOR STORMCEPTOR MODELS STC-900, STC-1200 AND STC-1800 SKIP STEP 5 AND GO TO STEP 6)

INSTALL REDUCING SLAB (STORMCEPTOR MODELS STC-2400, STC-3600, STC-4800, STC-6000 AND STC-7200) CHECK THAT SECTION IS SET FLUSH, LEVEL AND IS AT THE PROPER ELEVATION. INSTALL RUBBER GASKET ON THE TRANSITION SLAB SPIGOT AND COAT WITH LUBRICATING GREASE (PROVIDE IN SHIPMENT).

INSTALL BYPASS CHAMBER OF STORMCEPTOR WITH FACTORY INSTALLED STORMCEPTOR INSERT. LIFT BYPASS SECTION AND INSTALL WHILE CHECKING ALIGNMENT AND GRADE OF INLET AND OUTLET DRAINAGE PIPES. CHECK TO MAKE SURE THE BYPASS CHAMBER IS SET FLUSH, LEVEL AND IS AT THE PROPER ELEVATION. THE BYPASS CHAMBER MUST BE ORIENTED SUCH THAT INLET PIPE DISCHARGES INTO THE V-SHAPED FIBERGLASS WEIRS INSIDE INSERT. INSTALL RUBBER GASKET ON TOP OF BYPASS SECTION AND COAT WITH LUBRICATING GREASE, IF NOT PRELUBRICATED.

INSTALL STORMCEPTOR DROP PIPES ACCORDING TO STC PIPE INSTALLATION PROCEDURES ON REVERSE SIDE OF THESE INSTRUCTIONS.

INSTALL RISER SECTION. LIFT RISER SECTION AND INSTALL, WHILE CHECKING THAT SECTION IS SET FLUSH AND IS AT PROPER ELEVATION AND THAT UNIT IS LEVEL. SPECIFIC ALIGNMENT OF THIS PART IS REQUIRED, IF STEPS ARE INCLUDED. ALIGN STEPS ABOVE INLET INSPECTION PORT. NOTE, FOR SHALLOW INSTALLATIONS THIS SECTION MAY NOT BE REQUIRED.

INSTALL TOP SLAB WITH OPENING FOR STORMCEPTOR COVER. IF OPENING IS OFFSET (NOT CENTERED) THE TOP SLAB OPENING SHOULD BE ORIENTED ABOVE THE STORMCEPTOR INLET INSPECTION PORT (PLUG).

BACKFILL STORMCEPTOR WITH APPROVED BACKFILL MATERIAL (NO ORGANIC OR TOPSOIL IS TO BE USED FOR BACKFILL). BACKFILL AND COMPACT IN 8 INCH LIFTS. BACKFILL SHOULD BE COMPACTED TO LOCAL/STATE REQUIREMENTS.

INSTALL AND SET GRADE ADJUSTING RINGS, AS NEEDED. PLUG ALL LIFT HOLES WITH TAPERED FLEXIBLE PLUG AND KNOCK IN TO PLACE. PLUGS IN STORAGE CHAMBER MUST BE GROUTED INSIDE AND OUTSIDE WITH GROUT.



INSTALL AND SET STORMCEPTOR FRAME AND COVER.

INSTALL INLET AND OUTLET STORM DRAIN PIPES. CONNECT INLET AND OUTLET STORM DRAIN PIPES WITH FLEXIBLE BOOTS (WHEN PROVIDED AND WITH NON-SHRINK GROUT WHEN NO FLEXIBLE BOOTS ARE PROVIDED). THE INVERT OF THE INLET AND OUTLET PIPE IS TO MATCH WITH THE INVERT OF THE STORMCEPTOR INSERT. FLEXIBLE BOOT INSTALLATION PROCEDURES: CENTER THE PIPE IN BOOT OPENING. LUBRICATE THE INSIDE OF THE PIPE AND THE OUTSIDE OF THE BOOT. IF THE PIPE OUTSIDE DIAMETER IS THE SAME AS THE INSIDE DIAMETER OF THE BOOT, POSITION THE PIPE CLAMP IN THE GROOVE OF THE BOOT WITH THE SCREW AT THE TOP. TIGHTEN THE PIPE CLAMP SCREW TO 60 INCH POUNDS. IF THE PIPE IS MUCH SMALLER THAN THE BOOT LIFT THE BOOT SUCH THAT IT CONTACTS THE BOTTOM OF THE PIPE WHILE TIGHTENING THE CLAMP TO ENSURE EVEN CONTRACTION OF THE RUBBER. MOVE PIPE HORIZONTALLY AND/OR VERTICALLY TO BRING TO GRADE.

THE STORMCEPTOR SHOULD BE PUMPED OUT WHEN THE SEDIMENT CONTROL MEASURES ARE REMOVED (SITE PERMANENTLY STABILIZED).

FINAL INSPECTION

## **TYPICAL:** **RIP-RAP OUTFALL CHANNEL:** not to scale

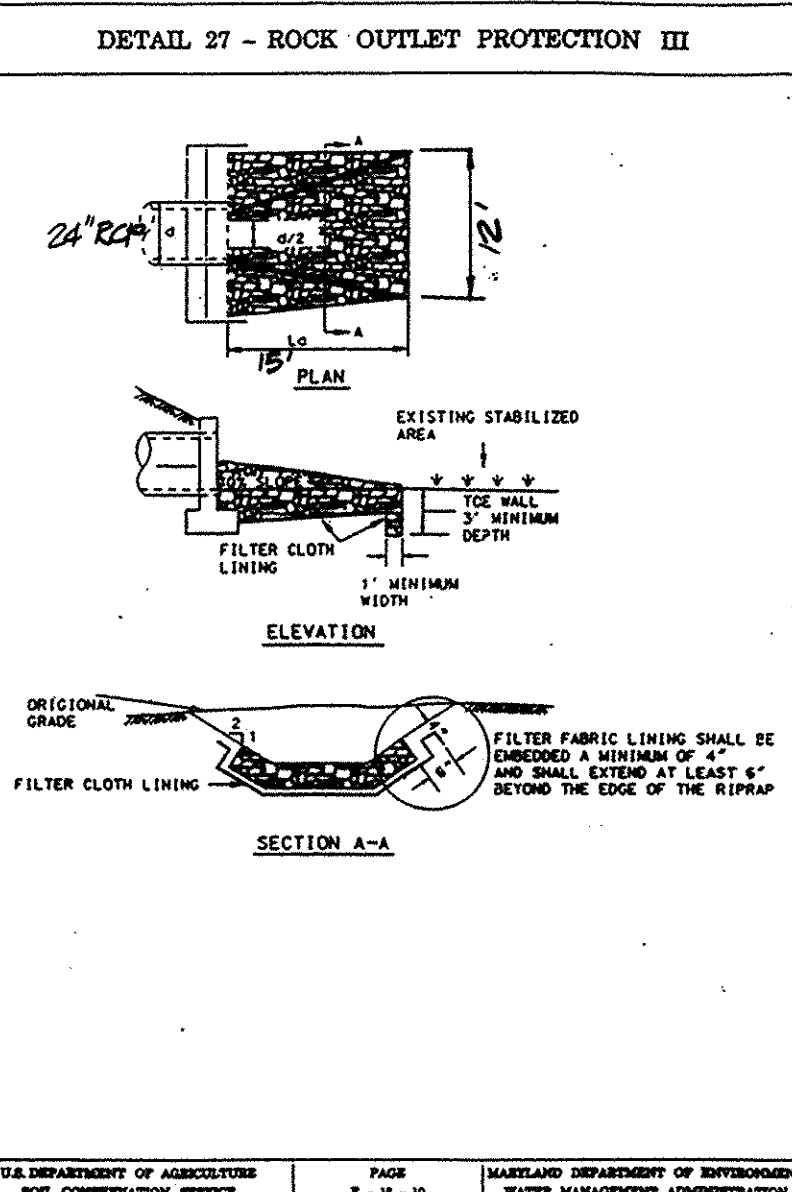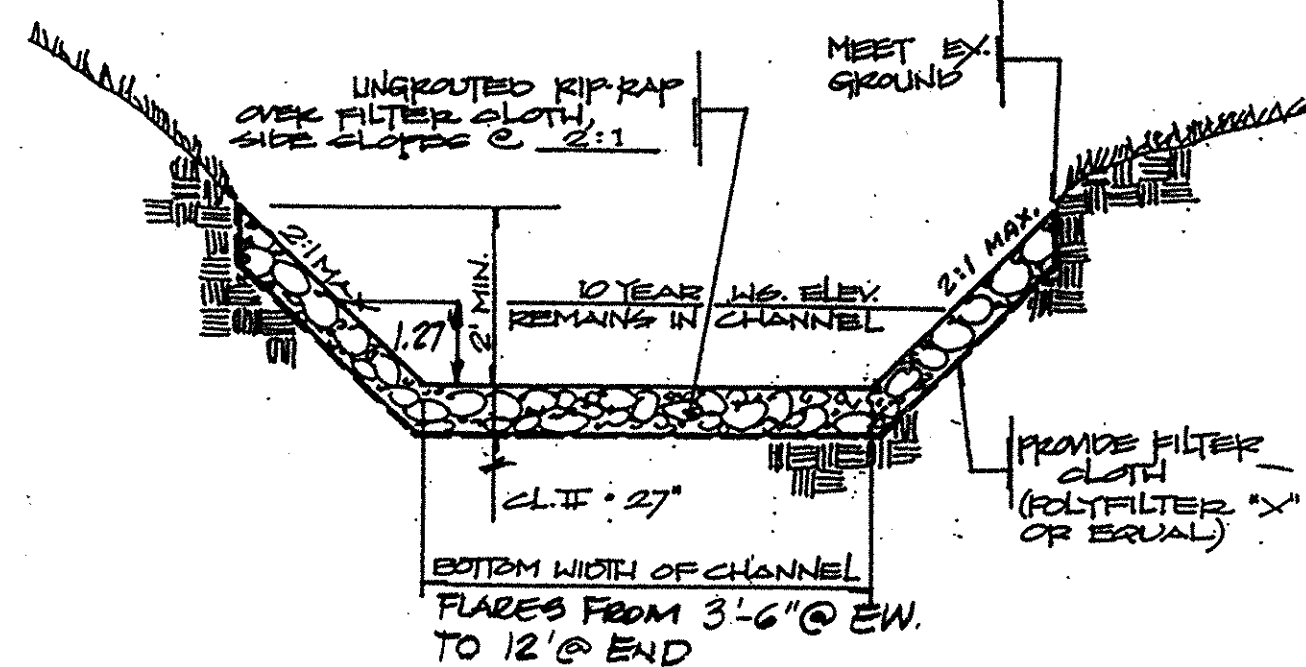

**ROCK OUTLET PROTECTION III**

**Construction Specifications:**

- The subgrade for the filter, rip-rap, or gabion shall be prepared to the required lines and grades. Any fill required in the subgrade shall be compacted to a density of approximately that of the surrounding undisturbed material.
- The rock or gravel shall conform to the specified grading limits when installed respectively in the rip-rap or filter.
- Geotextile shall be protected from punching, cutting, or tearing. Any damage other than on occasional small hole shall be repaired by placing another piece of geotextile over the damaged part or by completely replacing the geotextile. All overlaps shall be for rip-rap or for joining two pieces of geotextile shall be a minimum of one foot.
- Stones for the rip-rap or gabion outlets may be placed by equipment. They shall be constructed to the full course thickness in one operation and in such a manner as to avoid displacement of underlying material. The stones for rip-rap or gabion outlets shall be delivered and placed in a manner that will ensure that it is reasonably homogeneous with the smaller stones and spoils filling the voids between the larger stones. Rip-rap shall be placed in a manner to prevent damage to the filter blanket or geotextile. Hand placement will be required to the extent necessary to prevent damage to the permanent works.
- The stone shall be placed so that it blends in with the existing ground. If the stone is placed too high than the flow will be forced out of the channel and scour adjacent to the stone will occur.

BY THE DEVELOPER:

I/WE CERTIFY THAT ALL DEVELOPMENT AND/OR CONSTRUCTION WILL BE DONE IN ACCORDANCE TO THESE PLANS AND THAT ANY RESPONSIBLE PERSONNEL INVOLVED IN THE CONSTRUCTION PROJECT WILL HAVE A CERTIFICATE OF ATTENDANCE AT A DEPARTMENT OF THE ENVIRONMENT APPROVED TRAINING PROGRAM FOR THE CONTROL OF SEDIMENT AND EROSION BEFORE BEGINNING THE PROJECT. I/WE HAVE PROVIDED THE HOWARD SOIL CONSERVATION DISTRICT WITH AN AS-BUILT PLAN OF THE PROJECT WITHIN 30 DAYS OF COMPLETION. I/WE ALSO AUTHORIZE PERIODIC ON-SITE INSPECTIONS BY THE HOWARD SOIL CONSERVATION DISTRICT.

JOSEPH NAZARIO / OWNER  
 NAZARIO DEVELOPMENT AND COMPANY

DATE: 5-1-98

BY THE ENGINEER:

I/WE CERTIFY THAT THIS PLAN FOR SOIL CONSERVATION, SOIL EROSION AND SEDIMENT CONTROL REPRESENTS A PRACTICAL AND WORKABLE PLAN BASED ON MY PERSONAL KNOWLEDGE OF THE SITE CONDITIONS. THIS PLAN WAS PREPARED IN ACCORDANCE WITH THE REQUIREMENTS OF THE HOWARD SOIL CONSERVATION DISTRICT. I HAVE NOTED THE DEVELOPER THAT HE MUST PROVIDE THE HOWARD SOIL CONSERVATION DISTRICT WITH AN AS-BUILT PLAN OF THE PROJECT WITHIN 30 DAYS OF COMPLETION.

FRED L. SKELTON - MD. REGISTRATION No. 9070  
 IPDS, LLC

DATE: 6/5/98

THESE PLANS HAVE BEEN REVIEWED FOR THE HOWARD SOIL CONSERVATION DISTRICT AND MEET THE TECHNICAL REQUIREMENTS FOR SOIL EROSION AND SEDIMENT CONTROL.

Paul Simmons  
 S. SOIL CONSERVATION SERVICE

DATE: 9/30/98

THESE PLANS FOR SOIL EROSION AND SEDIMENT CONTROL MEET THE REQUIREMENTS OF THE HOWARD SOIL CONSERVATION DISTRICT.

John R. Rintoul  
 HOWARD SOIL CONSERVATION DISTRICT

DATE: 9/30/98

APPROVED: HOWARD COUNTY DEPARTMENT OF PLANNING AND ZONING

Director: [Signature] DATE: 10/6/98

Chief, Division of Land Development: [Signature] DATE: 10/5/98

Chief, Development Engineering Division: [Signature] DATE: 10/1/98

APPROVED: FOR PUBLIC WATER AND PUBLIC SEWERAGE, STORM DRAINAGE SYSTEMS AND PUBLIC ROADS.

Director: [Signature] DATE: [ ]

Chief, Bureau of Engineering: [Signature] DATE: [ ]

**AS BUILT CERTIFICATE**

FRED L. SKELTON - MD. REGISTRATION No. 9070  
 IPDS, LLC


DATE: [ ]

**OWNER / DEVELOPER**

Joseph Nazario  
 Nazario Development and Company  
 6500 Annapondale Road  
 Beltsville, Maryland 20705  
 (301) 937-4664


**SDP-98-135**



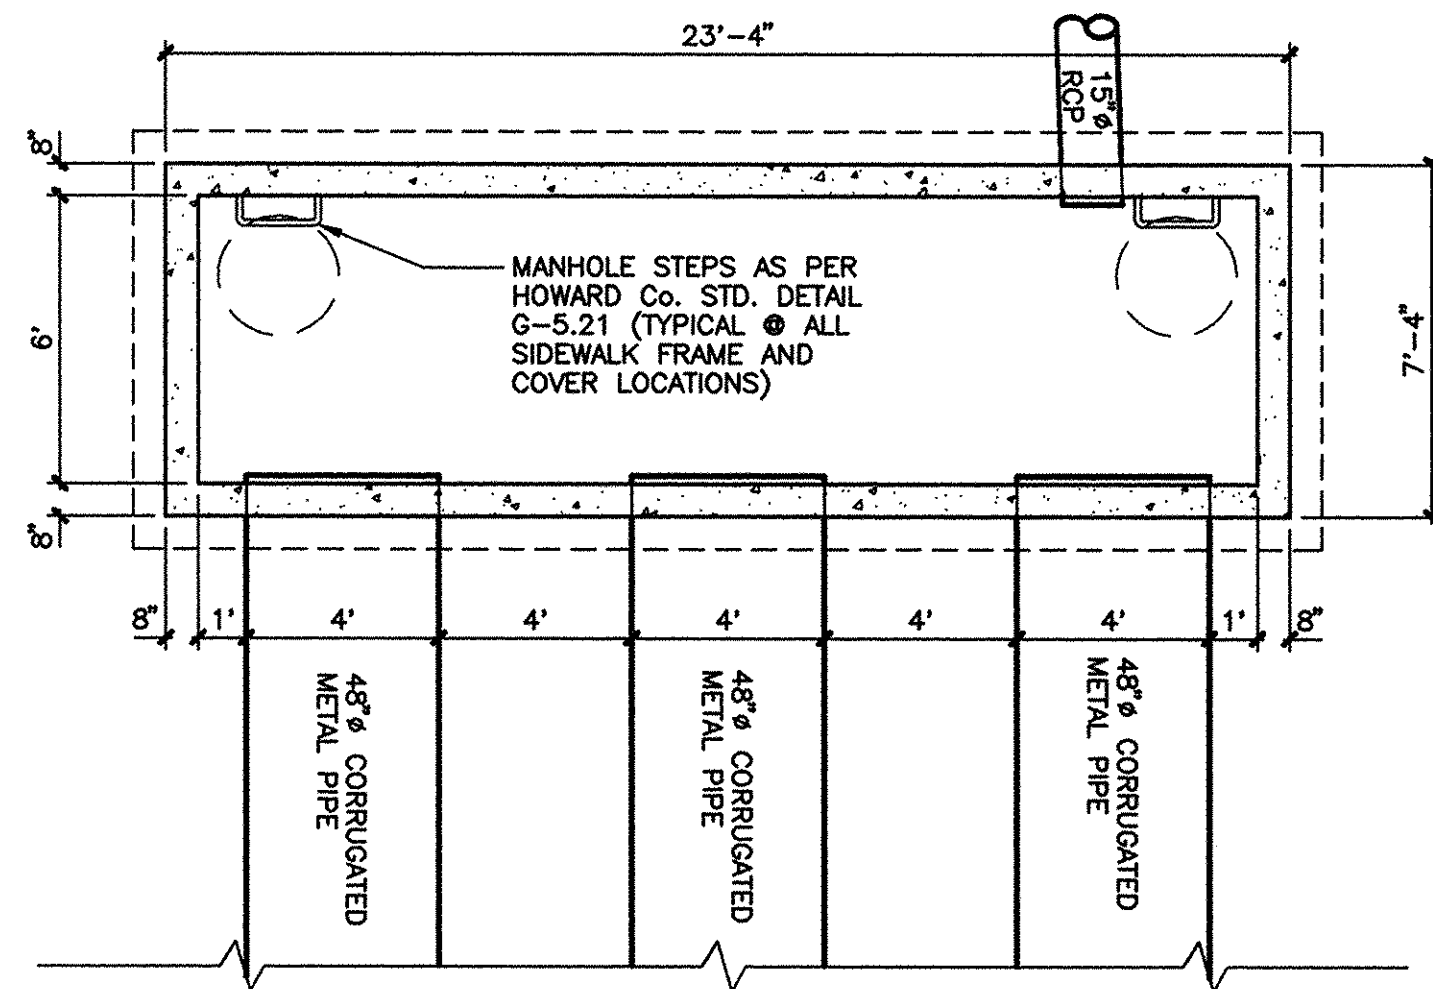


**JUNCTION BOX No. 5 - PLAN VIEW**

SCALE: 1/4"=1'-0"

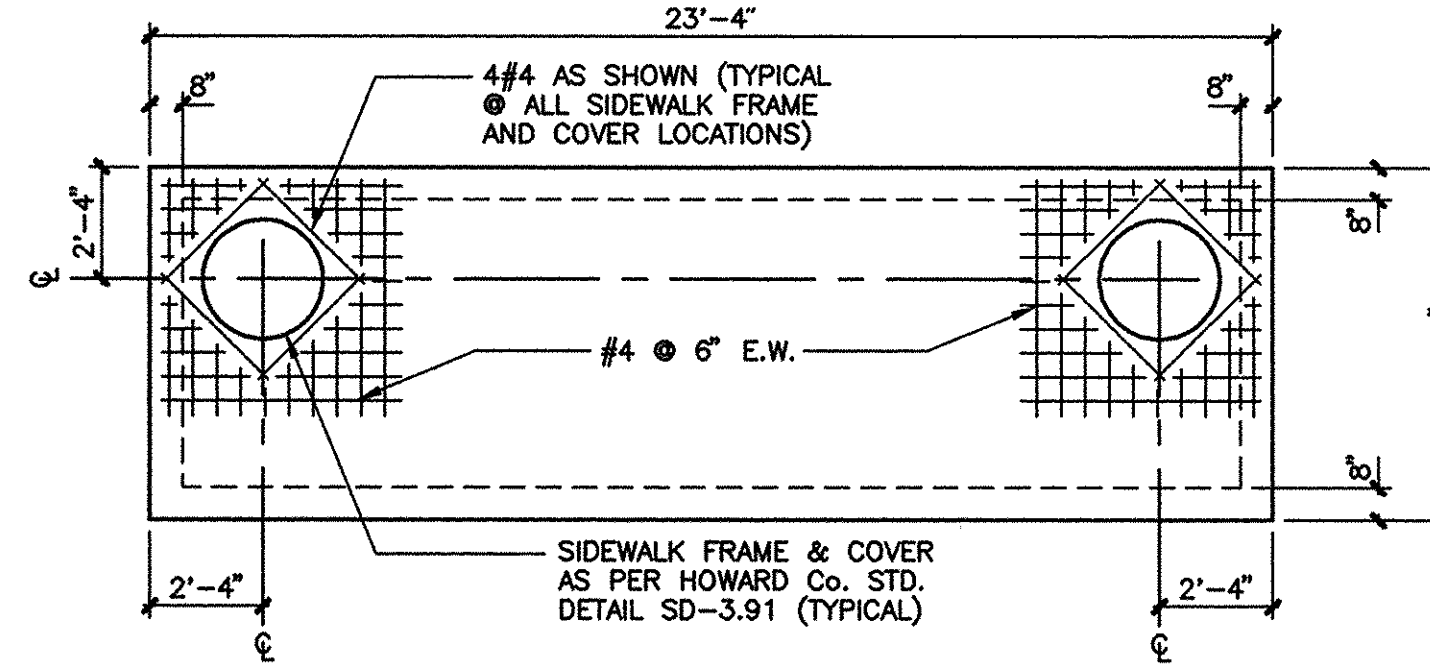


**JUNCTION BOX No. 5 - TOP SLAB DETAIL**

SCALE: 1/4"=1'-0"

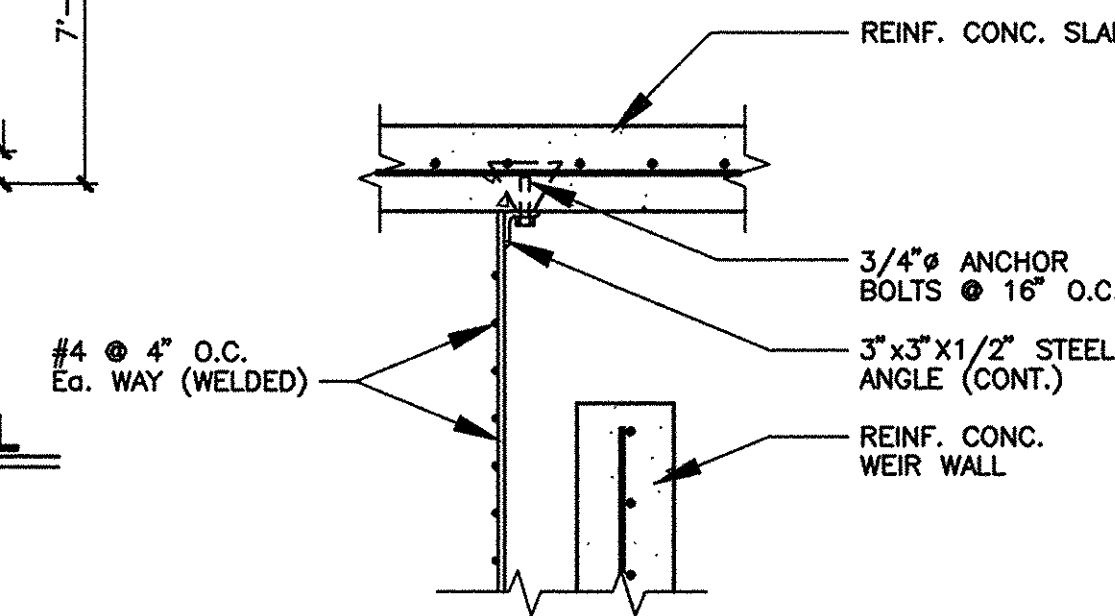


**DETAIL - TRASH RACK**

SCALE: 3/4"=1'-0"

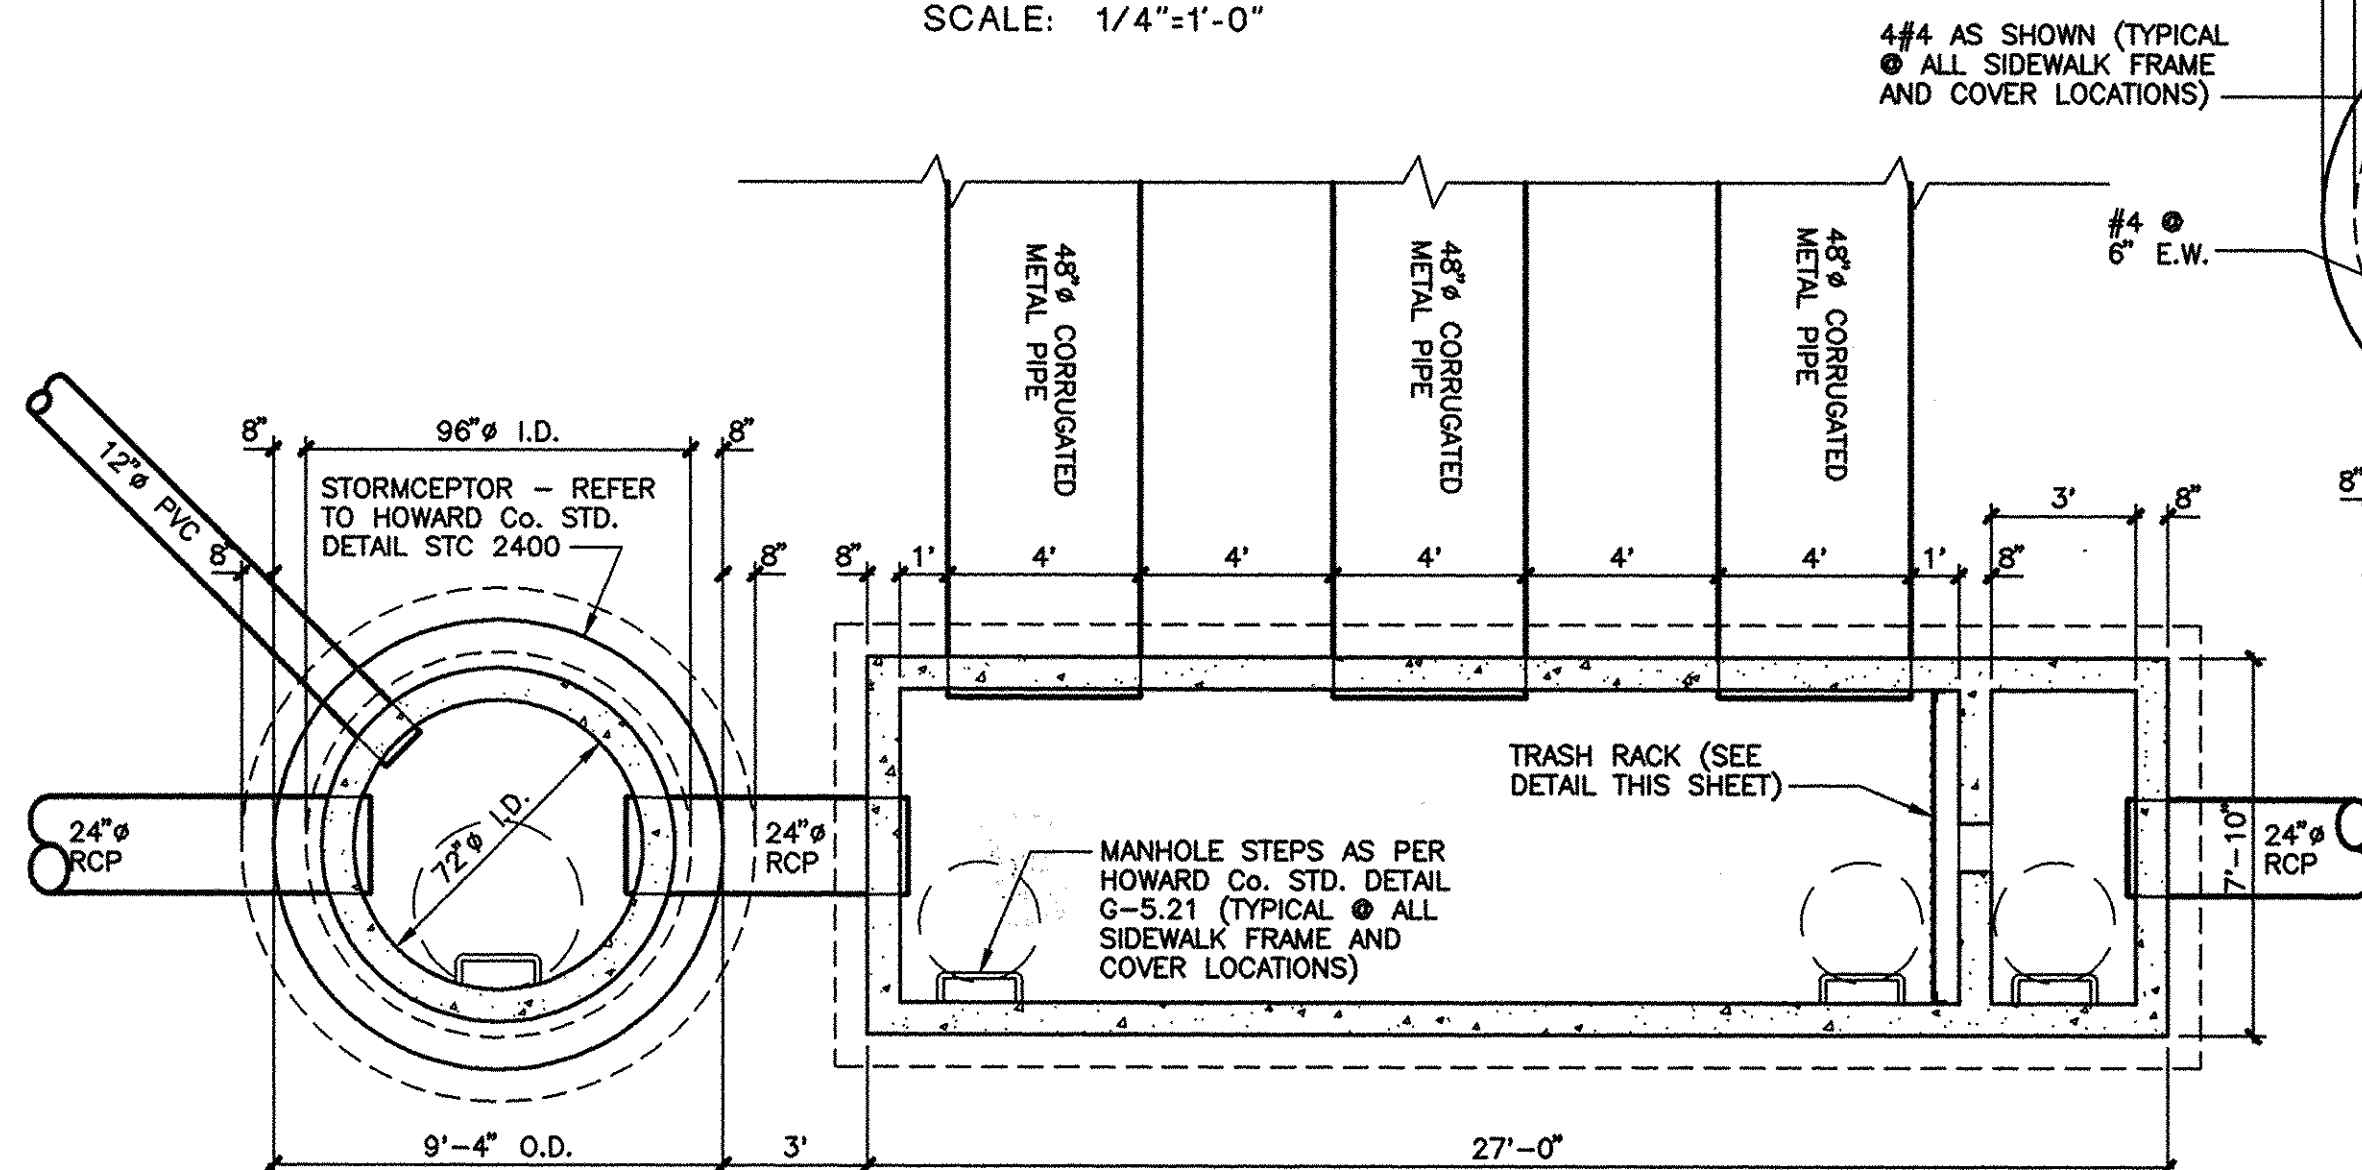


**JUNCTION BOX No. 4 - PLAN VIEW**

SCALE: 1/4"=1'-0"

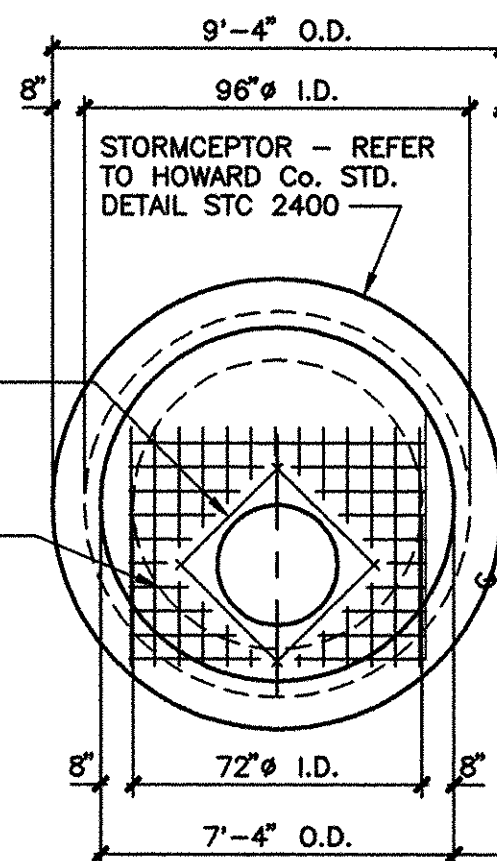

**JUNCTION BOX No. 4 - TOP SLAB DETAIL**

SCALE: 1/4"=1'-0"

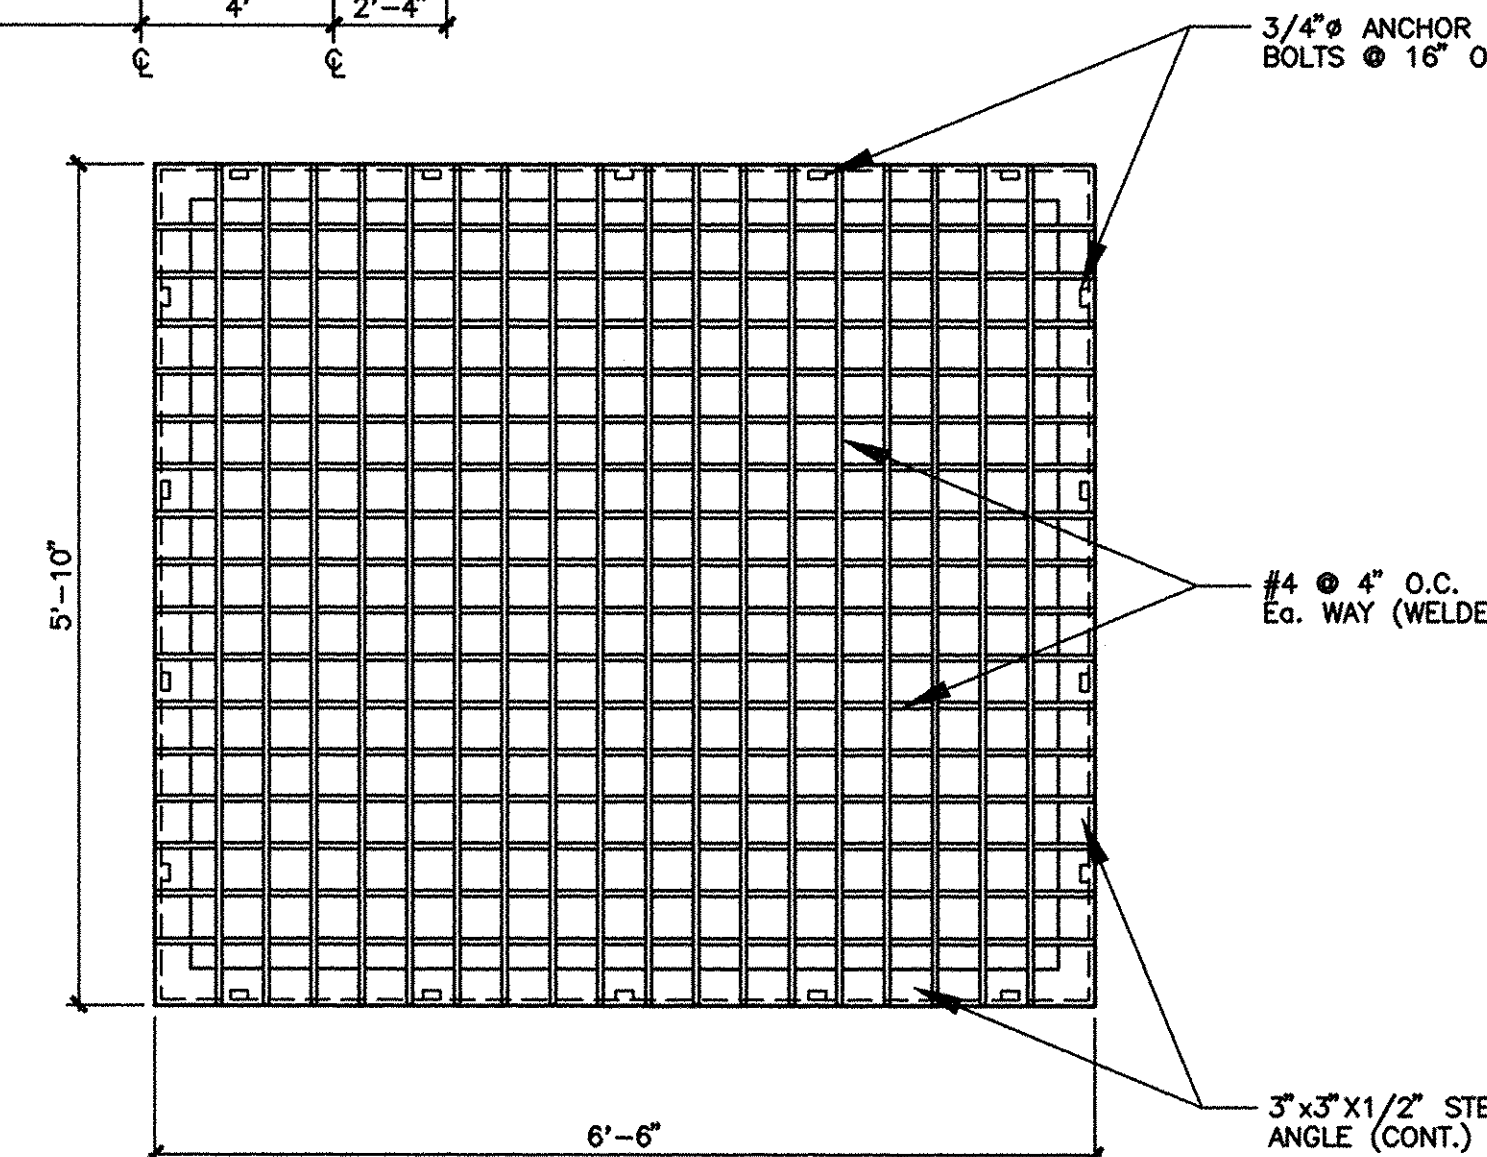

**ELEVATION - TRASH RACK**

SCALE: 3/4"=1'-0"


### UNDERGROUND PIPE STORAGE (PRIVATE)

#### SPECIFICATIONS FOR CONSTRUCTION

- CONTRACTOR SHALL SUBMIT SHOP DRAWINGS TO ENGINEER AND HOWARD COUNTY FOR APPROVAL PRIOR TO COMMENCING WORK.
- ALL WORK SHALL BE PLACED ON UNDISTURBED SUBGRADE. ANY OVER-EXCAVATION SHALL BE BACKFILLED WITH CR-6 CRUSHED RUN AND COMPACTED TO 95% AASHTO UNDER DIRECTION OF ENGINEER. NO CONSTRUCTION SHALL BE PLACED ON WET OR FROZEN GROUND.
- ALL WELDING SHALL BE DONE BY MANUFACTURER'S WELDER. WELDS SHALL BE WATERPROOFED PRIOR TO BACKFILLING AND FINAL INSPECTION.
- ALL STEEL USED FOR STORAGE STRUCTURE SHALL BE CORRUGATED STEEL ALUMINIZED PIPE, 12 GAUGE.
- THE CONTRACTOR SHALL GUARANTEE TOTAL RUST-PROOFING OF THE STEEL PIPE.
- PIPES SHALL BE BEDDED IN 12" OF SAND.
- MINIMUM COVER SHALL BE 18".

#### NOTES

- REFER TO ARMC, INC. METAL PRODUCTS DIVISION (OR EQUAL AND APPROVED) FOR LOCATIONS OF WELDED CONNECTIONS.
- SHOP DRAWINGS TO BE SUBMITTED TO HOWARD COUNTY AND THE ENGINEER PRIOR TO CONSTRUCTION.

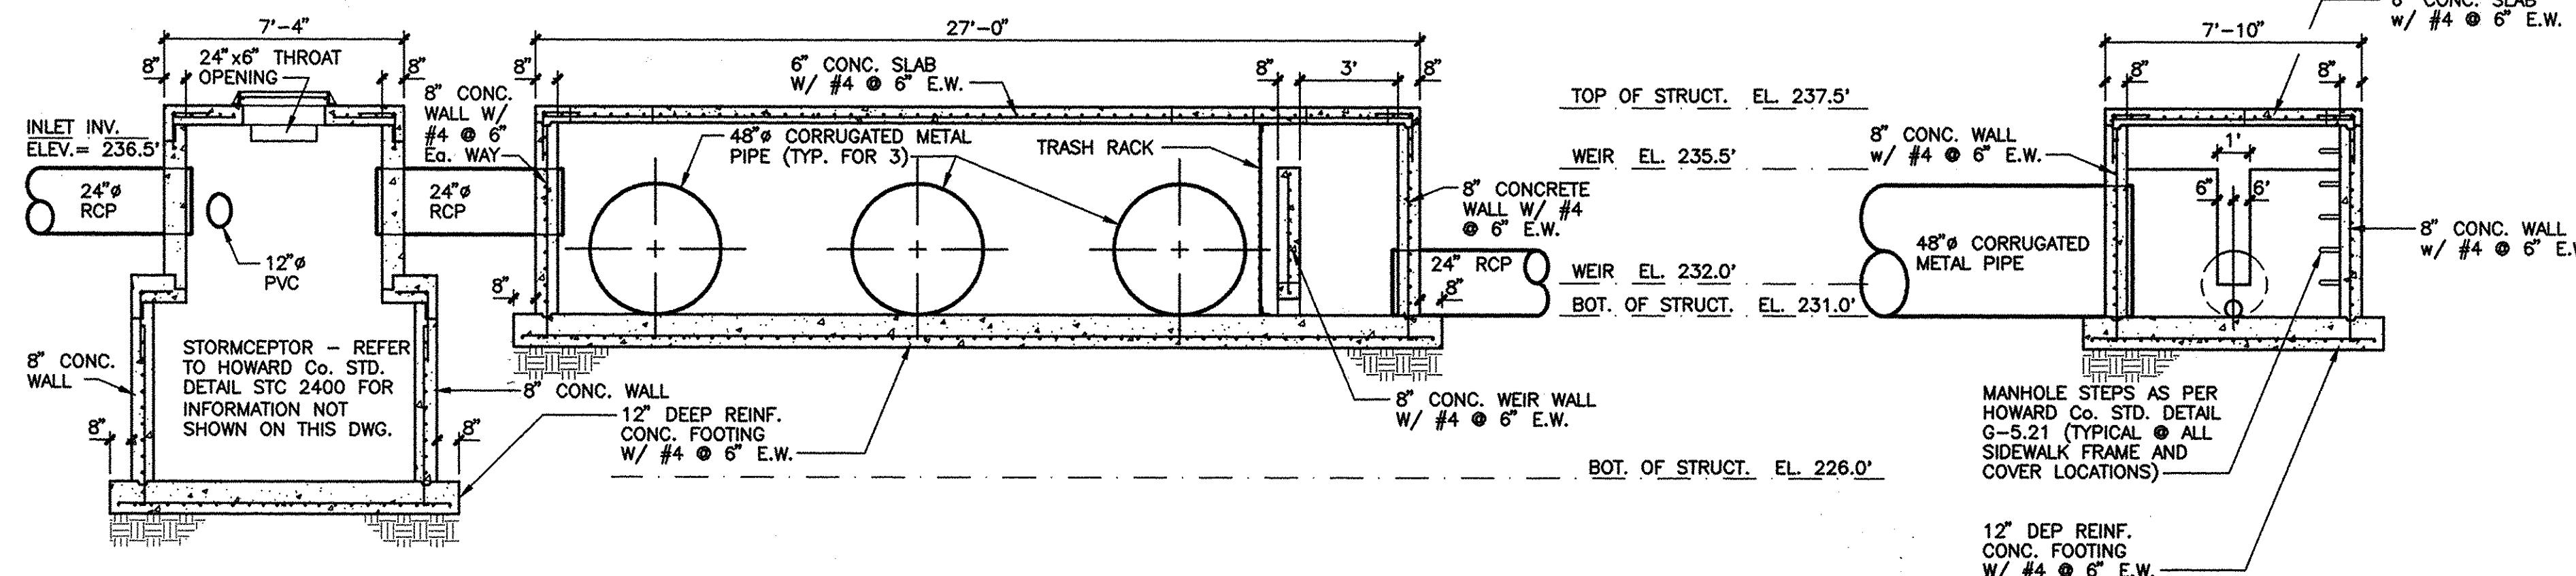


**JUNCTION BOX No. 4 - LONGITUDINAL SECTION**

SCALE: 1/4"=1'-0"

**JUNCTION BOX No. 4 - CROSS SECTION**

SCALE: 1/4"=1'-0"

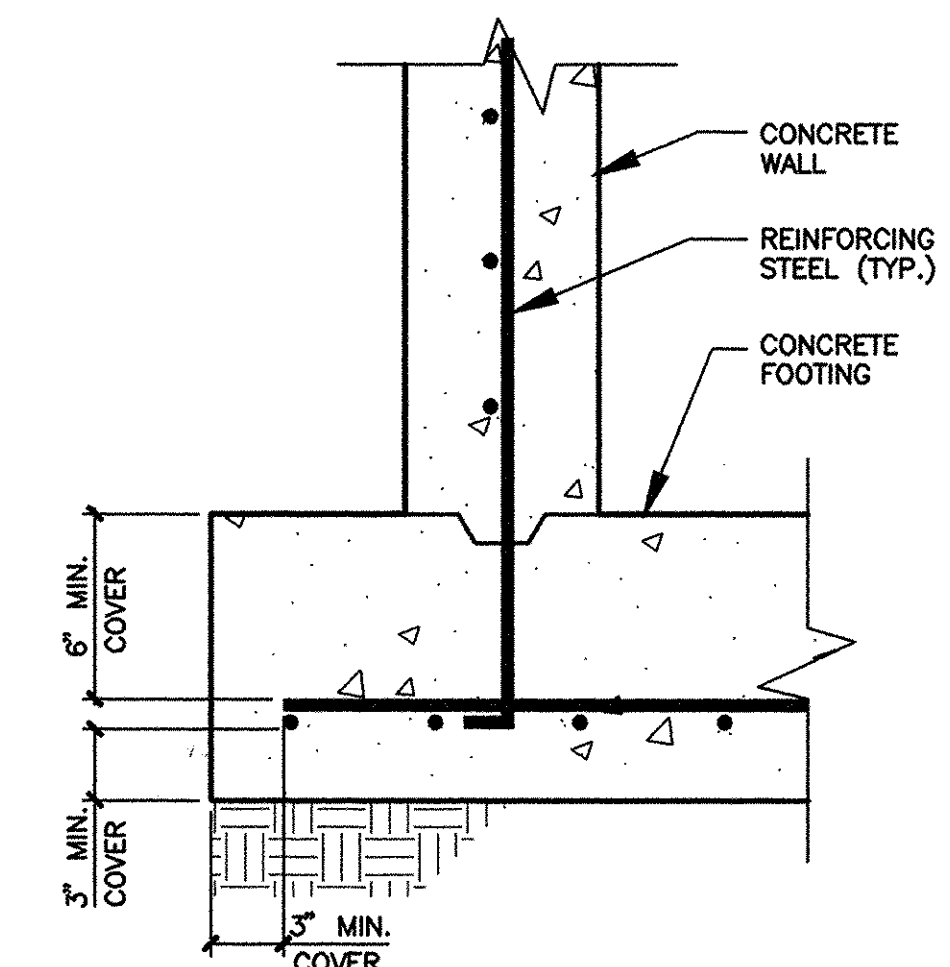

**TYPICAL FOOTING DETAIL**

NO SCALE

BY THE DEVELOPER:

I/WE CERTIFY THAT ALL DEVELOPMENT AND/OR CONSTRUCTION WILL BE DONE IN ACCORDANCE WITH THESE PLANS AND THAT ANY RESPONSIBLE PERSONNEL INVOLVED IN THE CONSTRUCTION PROJECT WILL HAVE A CERTIFICATE OF ATTENDANCE AT A DEPARTMENT OF THE ENVIRONMENT APPROVED TRAINING PROGRAM FOR THE CONTROL OF SEDIMENT AND EROSION BEFORE BEGINNING THE PROJECT. I/WE WILL PROVIDE THE HOWARD SOIL CONSERVATION DISTRICT WITH AN AS-BUILT PLAN OF THE PROJECT WITHIN 30 DAYS OF COMPLETION. I/WE ALSO AUTHORIZE PERIODIC ON-SITE INSPECTIONS BY THE HOWARD SOIL CONSERVATION DISTRICT.

JOSEPH NAZARIO, OWNER  
NAZARIO DEVELOPMENT AND COMPANY

5-1-98  
DATE

BY THE ENGINEER:

I/WE CERTIFY THAT THIS PLAN FOR ROAD CONSTRUCTION, SOIL EROSION AND SEDIMENT CONTROL REPRESENTS A PRACTICAL AND WORKABLE PLAN BASED ON MY PERSONAL KNOWLEDGE OF THE SITE CONDITIONS. THIS PLAN WAS PREPARED IN ACCORDANCE WITH THE REQUIREMENTS OF THE HOWARD SOIL CONSERVATION DISTRICT. I/WE ALSO AUTHORIZE PERIODIC ON-SITE INSPECTIONS BY THE HOWARD SOIL CONSERVATION DISTRICT WITHIN 30 DAYS OF COMPLETION.

FRED L. SKELTON - MD. REGISTRATION No. 9070  
IPDS, LLC

6/5/98  
DATE

THESE PLANS HAVE BEEN REVIEWED FOR THE HOWARD SOIL CONSERVATION DISTRICT AND MEET THE TECHNICAL REQUIREMENTS FOR SOIL EROSION AND SEDIMENT CONTROL.

Daryl Simmons, U.S. SOIL CONSERVATION SERVICE  
9/30/98  
DATE

THESE PLANS FOR SOIL EROSION AND SEDIMENT CONTROL MEET THE REQUIREMENTS OF THE HOWARD SOIL CONSERVATION DISTRICT.

John R. Skelton, HOWARD SOIL CONSERVATION DISTRICT  
9/30/98  
DATE

APPROVED: HOWARD COUNTY DEPARTMENT OF PLANNING AND ZONING

Director, 10/6/98  
DATE

Chief, Division of Land Development, 10/5/98  
DATE

Chief, Development Engineering Division, 10/1/99  
DATE

APPROVED: FOR PUBLIC WATER AND PUBLIC SEWERAGE, STORM DRAINAGE SYSTEMS AND PUBLIC ROADS.

Director, DATE

Chief, Bureau of Engineering, DATE



#### AS BUILT CERTIFICATE

FRED L. SKELTON - MD. REGISTRATION No. 9070  
IPDS, LLC

DATE

#### OWNER \ DEVELOPER

Joseph Nazario  
Nazario Development and Company  
6500 Ammendale Road  
Beltsville, Maryland 20705  
(301) 937-4664

802 Sligo Avenue  
Silver Spring, Maryland 20910  
(301) 585-5676  
IPDS  
The Interprofessional  
PLANNING & DESIGN STUDIO, LLC  
Engineers • Architects • Surveyors  
Planners & Landscape Architects

IPDS  
The Interprofessional  
PLANNING & DESIGN STUDIO, LLC  
Engineers • Architects • Surveyors  
Planners & Landscape Architects

STORMWATER MANAGEMENT  
DETAILS

U.S. No. 1 JOINT VENTURE  
PARCEL "A", PLAT CMP No. 3592, WAREHOUSE  
GUILFORD ELECTION DISTRICT No. 6  
HOWARD COUNTY, MARYLAND  
CENSUS TRACT 6068.02, TAX MAP 47, BLOCK 22/23  
WATER CODE C04, SEWER CODE 7220000

#### AS NOTED

SCALE:

06-18-98

REVISIONS:

01-18-98

DATE:


JOB NUMBER:

SWM-3


SHEET 10 OF 13

SDP-98-135



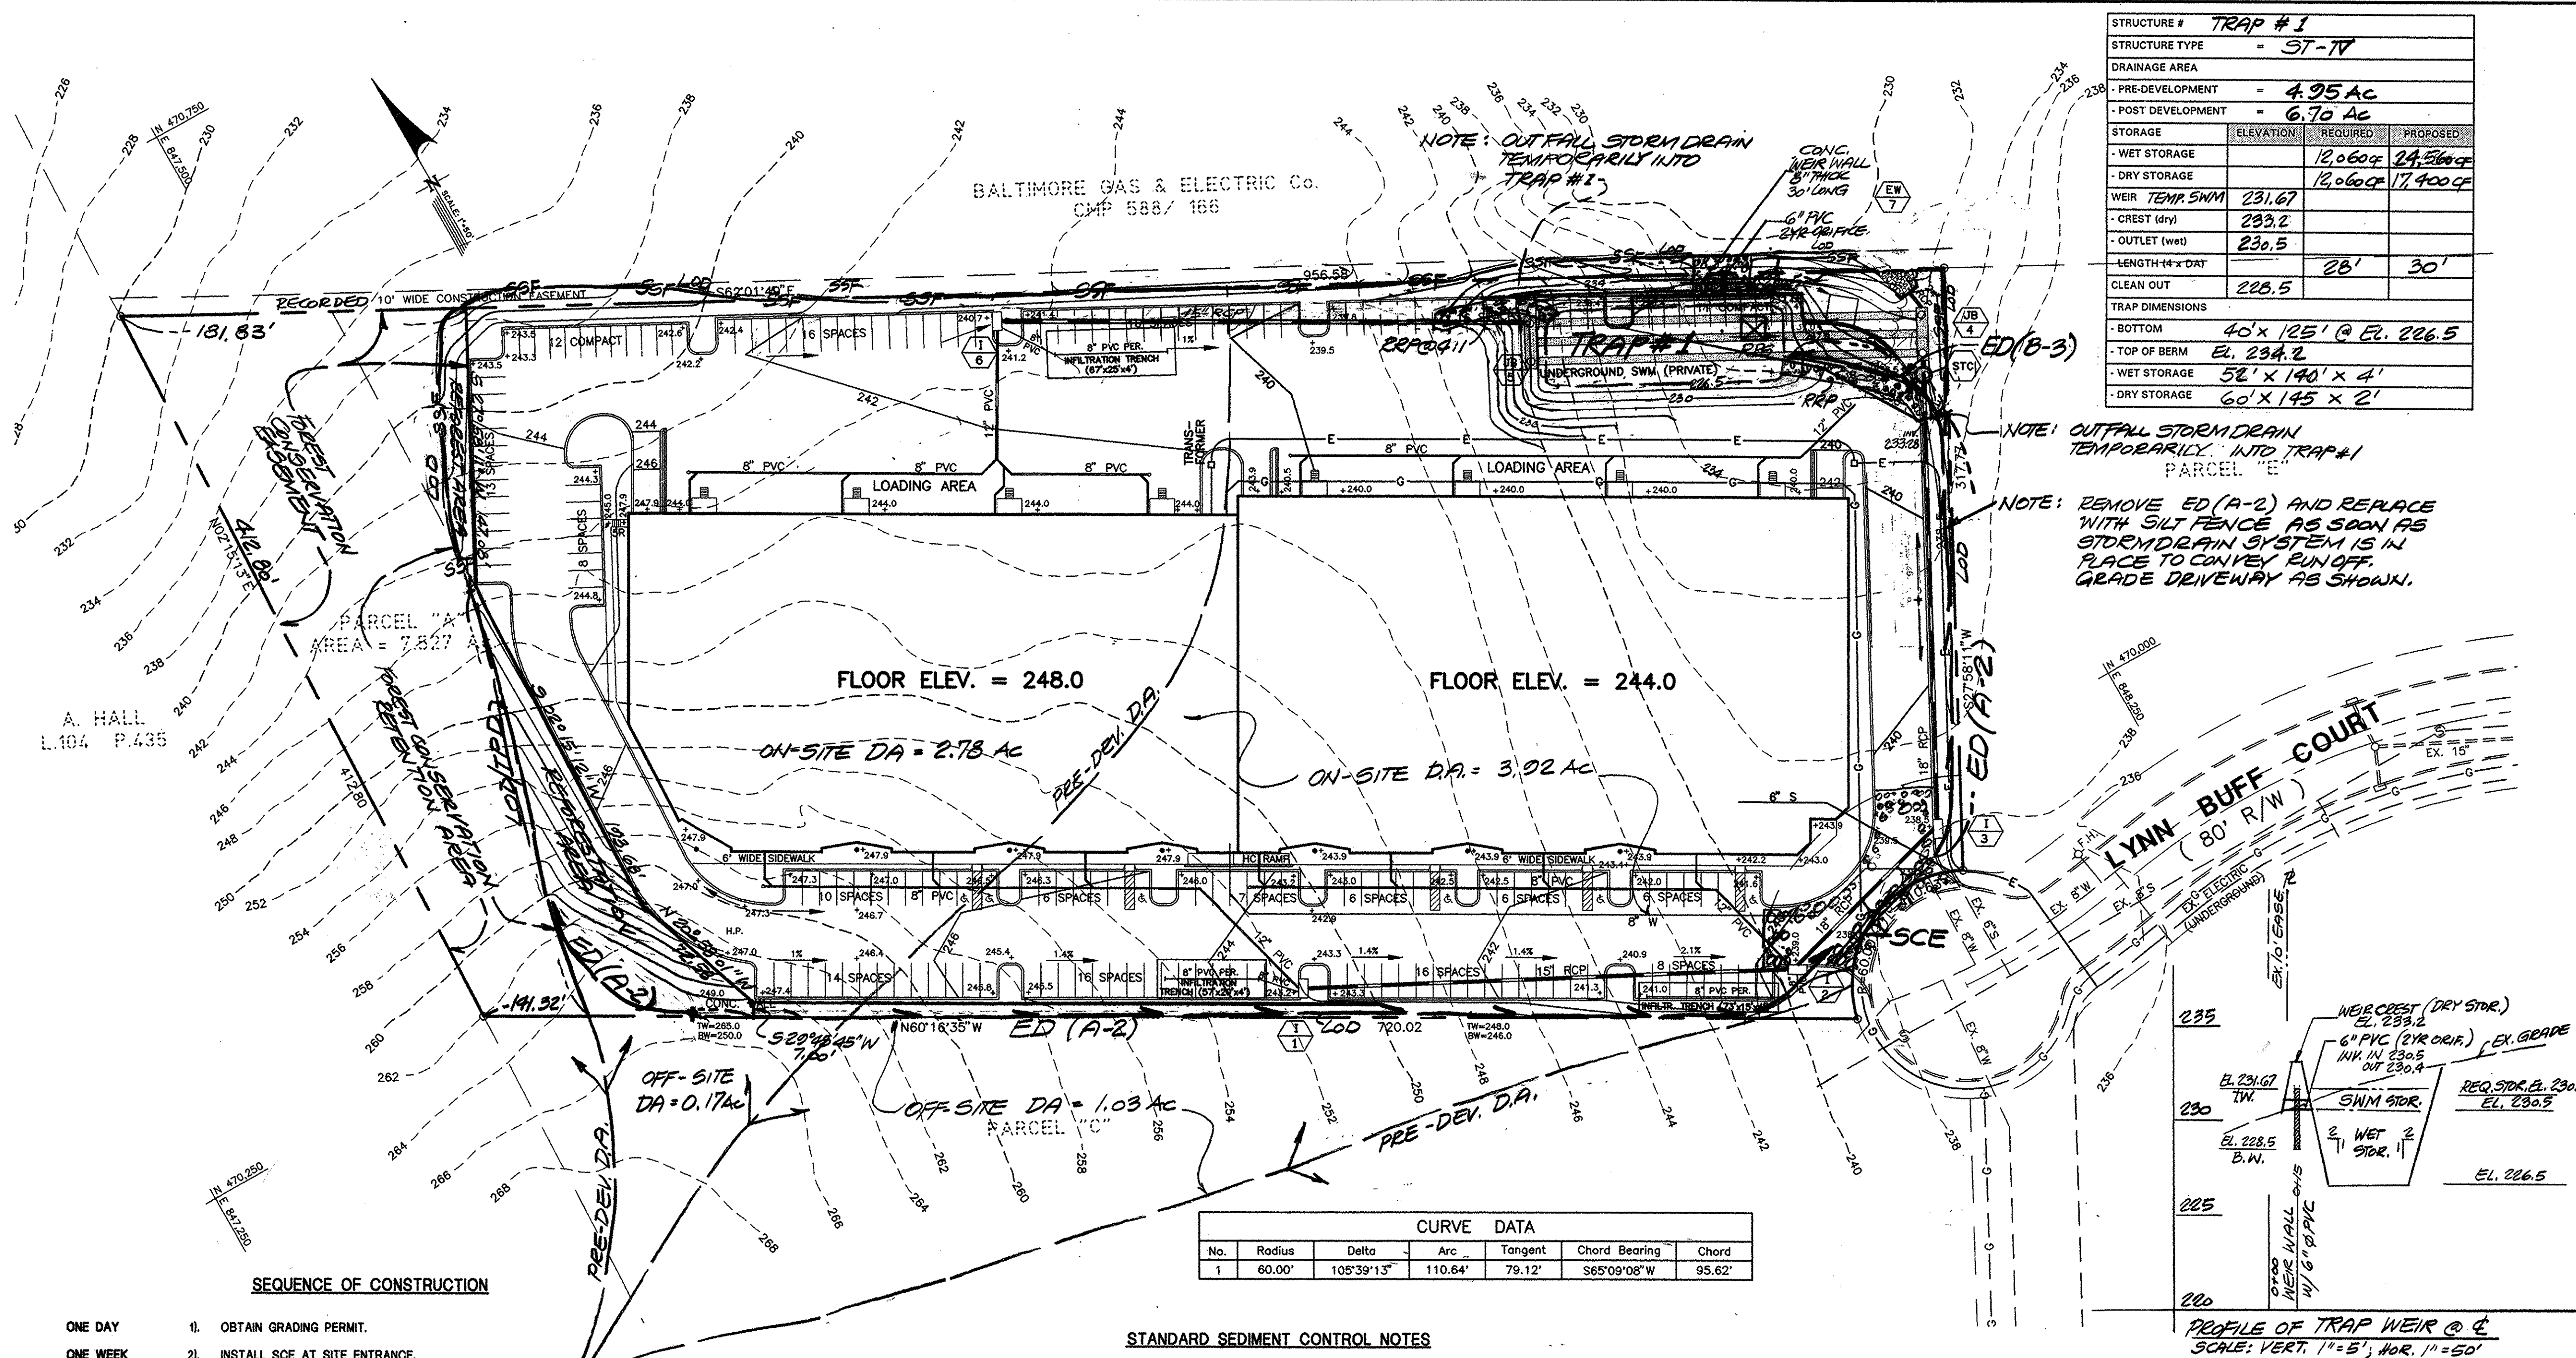

STRUCTURE #	TRAP #1
STRUCTURE TYPE	ST-17
DRAINAGE AREA	
- PRE-DEVELOPMENT	4.95 AC
- POST DEVELOPMENT	6.70 AC
STORAGE	
- WET STORAGE	12,060 CF 24,560 G
- DRY STORAGE	12,060 CF 17,400 G
WEIR	TEMP SWM 231.67
- CREST (dry)	233.2
- OUTLET (wet)	236.5
LENGTH (ft x DAY)	28' 30'
CLEAN OUT	228.5
TRAP DIMENSIONS	
- BOTTOM	40' x 125' @ EL. 226.5
- TOP OF BERM	EL. 234.2
- WET STORAGE	52' x 140' x 4'
- DRY STORAGE	60' x 145' x 2'

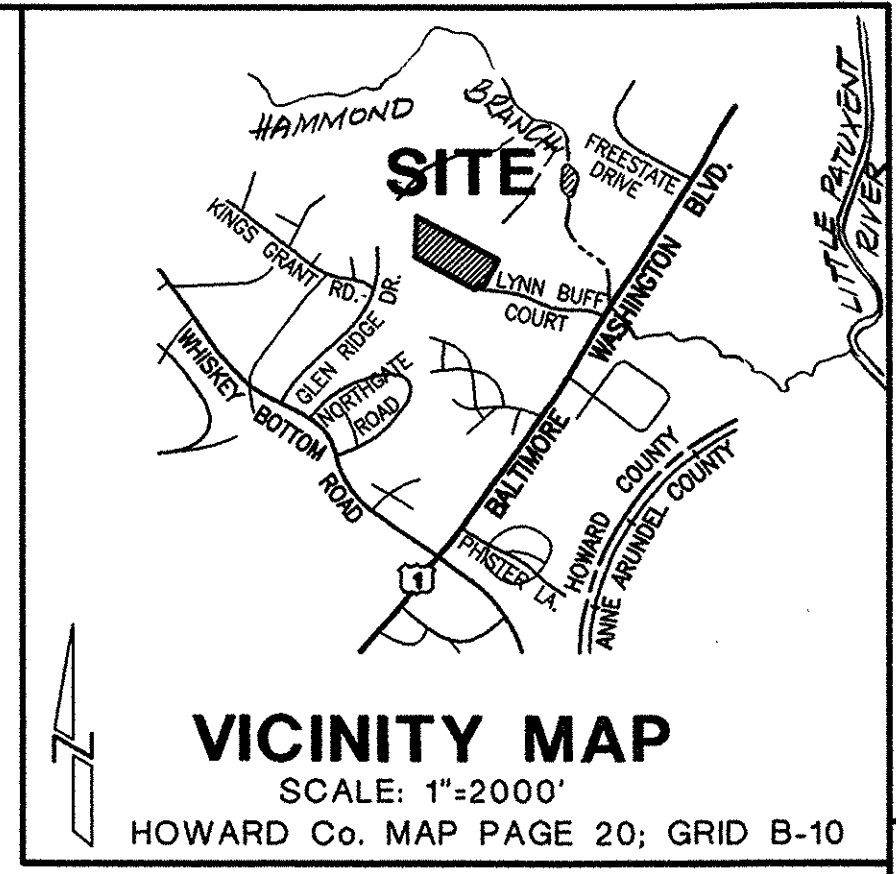

- SEQUENCE OF CONSTRUCTION**
- ONE DAY 1. OBTAIN GRADING PERMIT.
  - ONE WEEK 2. INSTALL SCE AT SITE ENTRANCE.
  - TWO WEEKS 3. CONSTRUCT SEDIMENT TRAP No. 1 AND INSTALL SILT FENCING BELOW AREAS OF EMBANKMENT AS SHOWN.
  - TWO DAYS 4. INSTALL DIVERSION UPSTREAM ALONG SOUTH AND WEST PROPERTY LINE TO PREVENT SURFACE RUN-OFF OVER OUT AREAS AND INSTALL TPD FENCING AS SHOWN ON PLAN & DETAIL (Sheet 2 of 3).
  - ONE WEEK 5. INSTALL ALL REMAINING SEDIMENT CONTROL MEASURES AS SHOWN ON PLANS AND NOTES, INCLUDING BUT NOT LIMITED TO TRAP No. 1, EARTH DIKES, SILT FENCES AND OUTLET STRUCTURES. INSTALL STORM DRAIN PIPE AND OUT-FALL STRUCTURES No. 1 THRU No. 3 TEMPORARILY INTO TRAP FOR CONVEYANCE OF SEDIMENT LADEN RUN-OFF.
  - SIX MONTHS 6. CONSTRUCT BUILDING PAD AND ROUGH GRADE SITE. INSTALLATION OF UNDERGROUND SWM PIPES SHALL BE DEFERRED UNTIL TRAP No. 1 CAN BE REMOVED.  
BUILDING CONSTRUCTION MAY START AS SOON AS THE BUILDING PAD IS ESTABLISHED. SEDIMENT CONTROL MEASURES INSTALLED FOR PAD CONSTRUCTION SHALL BE MAINTAINED AS SHOWN ON THE APPROVED SEDIMENT CONTROL PLAN.
  - TWO MONTHS 7. UPON APPROVAL BY INSPECTOR, FINAL GRADE SITE CONSTRUCT RETAINING WALLS AND STABILIZE ROADWAYS.
  - THREE MONTHS 8. INSTALL GAS AND ELECTRIC, SEWER, WATER & REMAINING STORM DRAIN AND INFILTRATION TRENCHES.
  - THREE WEEKS 9. CONSTRUCT CURB & GUTTER AND BASE COURSE IN ROADWAYS.
  - TWO WEEKS 10. PAVE ROADWAYS AND STABILIZE ANY REMAINING AREAS.  
ITEMS No. 8 & No. 9 MAY BE CARRIED OUT CONCURRENTLY.
  - FOUR WEEKS 11. UPON PERMANENT VEGETATIVE STABILIZATION OF SITE AND UPON APPROVAL BY INSPECTOR, TRAP IS TO BE CLEANED OUT AND SEDIMENT REMOVED. THE TEMPORARY STOCK PILE AREA MAY BE USED AS DISPOSAL SITE.  
THE STORM DRAIN SYSTEM SHALL BE FLUSHED AND ALL SEDIMENT REMOVED BEFORE THE SEDIMENT TRAP CAN BE FILLED IN AND UNDERGROUND SWM PIPES CAN BE INSTALLED. FLUSHING SHALL BE DONE AFTER ITEM No. 9 OF THE SEQUENCE OF CONSTRUCTION IS COMPLETED. SUPER SILT FENCE DOWNSTREAM FROM SWM FACILITY SHALL STAY IN PLACE UNTIL INSTALLATION OF SWM PIPES.
  - ONE WEEK 12. UPON APPROVAL OF INSPECTOR, REMOVE ALL REMAINING SEDIMENT CONTROL MEASURES.

- STANDARD SEDIMENT CONTROL NOTES**
- I (WE) CERTIFY THAT:
- A MINIMUM OF 48 HOURS NOTICE MUST BE GIVEN TO THE HOWARD COUNTY DEPARTMENT OF INSPECTIONS, LICENSES AND PERMITS, SEDIMENT CONTROL DIVISION PRIOR TO THE START OF ANY CONSTRUCTION (410-313-1855).
  - ALL VEGETATIVE AND STRUCTURAL PRACTICES ARE TO BE INSTALLED ACCORDING TO THE PROVISIONS OF THIS PLAN AND ARE TO BE IN CONFORMANCE WITH THE 1994 MARYLAND STANDARDS AND SPECIFICATIONS FOR SOIL EROSION AND SEDIMENT CONTROL AND REVISIONS THERETO.
  - FOLLOWING INITIAL SOIL DISTURBANCE OR RE-DISTURBANCE, PERMANENT OR TEMPORARY STABILIZATION SHALL BE COMPLETED WITHIN: A) 7 CALENDAR DAYS FOR ALL PERIMETER SEDIMENT CONTROL STRUCTURES, DIKES, PERIMETER SLOPES AND ALL SLOPES STEEPER THAN 3:1, B) 14 DAYS AS TO ALL OTHER DISTURBED OR GRADED AREAS ON THE PROJECT SITE.
  - ALL SEDIMENT TRAPS/BASINS SHOWN MUST BE FENCED AND WARNING SIGNS POSTED AROUND THEIR PERIMETER IN ACCORDANCE WITH VOL. 1, CHAPTER 7 OF THE HOWARD COUNTY DESIGN MANUAL, STORM DRAINAGE.
  - ALL DISTURBED AREAS MUST BE STABILIZED WITHIN THE TIME PERIOD SPECIFIED ABOVE IN ACCORDANCE WITH THE 1994 MARYLAND STANDARDS AND SPECIFICATIONS FOR SOIL EROSION AND SEDIMENT CONTROL FOR PERMANENT SEEDING, SOD, TEMPORARY SEEDING, AND MULCHING (SEC. G). TEMPORARY STABILIZATION WITH MULCH ALLOW SHALL ONLY BE DONE WHEN RECOMMENDED SEEDING DATES DO NOT ALLOW FOR PROPER GERMINATION AND ESTABLISHMENT OF GRASSES.
  - ALL SEDIMENT CONTROL STRUCTURES ARE TO REMAIN IN PLACE AND ARE TO BE MAINTAINED IN OPERATIVE CONDITION UNTIL PERMISSION FOR THEIR REMOVAL HAS BEEN OBTAINED FROM THE HOWARD COUNTY SEDIMENT CONTROL INSPECTOR.
  - SITE ANALYSIS:  
TOTAL AREA OF SITE = 7.527 AC.  
AREA DISTURBED (TOTAL) = 6.7 AC.  
AREA TO BE ROOFED OR PAVED = 5.4 AC.  
AREA TO VEGETATIVELY STABILIZED = 1.3 AC.  
TOTAL CUT = 26,000 CY  
TOTAL FILL = 10,000 CY  
OFFSITE WASTE AREA LOCATION = MARINUCCI TRACT, LAUREL, P.S. G, SC # 92-08; PERMIT # 8354-07-G
  - ANY SEDIMENT CONTROL PRACTICE WHICH DISTURBED BY GRADING ACTIVITY FOR PLACEMENT OF UTILITIES MUST BE REPAIRED ON THE SAME DAY OF DISTURBANCE.
  - ADDITIONAL SEDIMENT CONTROL MUST BE PROVIDED, IF DEEMED NECESSARY BY THE HOWARD COUNTY SEDIMENT CONTROL INSPECTOR.
  - ON ALL SITES WITH DISTURBED AREAS IN EXCESS OF 2 ACRES, APPROVAL OF THE INSPECTION AGENCY SHALL BE REQUESTED UPON COMPLETION OF INSTALLATION OF PERIMETER EROSION AND SEDIMENT CONTROLS, BUT BEFORE PROCEEDING WITH ANY OTHER EARTH DISTURBANCE OR GRADING. OTHER BUILDING OR GRADING INSPECTION APPROVALS MAY NOT BE AUTHORIZED UNTIL THIS INITIAL APPROVAL BY THE INSPECTION AGENCY IS MADE.
  - TRENCHES FOR THE CONSTRUCTION OF UTILITIES IS LIMITED TO THREE PIPE LENGTHS OR THAT WHICH SHALL BE BACK-FILLED AND STABILIZED WITHIN ONE WORKING DAY, WHICHEVER IS SHORTER.
  - ALL DEVELOPMENT AND CONSTRUCTION WILL BE DONE IN ACCORDANCE WITH THIS SEDIMENT AND EROSION CONTROL PLAN, AND FURTHER, AUTHORIZE THE RIGHT OF ENTRY FOR PERIODIC ON-SITE EVALUATION BY THE HOWARD COUNTY INSPECTION STAFF OR THEIR AUTHORIZED AGENTS.
  - ANY RESPONSIBLE PERSONNEL INVOLVED IN THE CONSTRUCTION PROJECT WILL HAVE A CERTIFICATE OF ATTENDANCE FROM THE MARYLAND DEPARTMENT OF THE ENVIRONMENT'S APPROVED TRAINING PROGRAM FOR THE CONTROL OF SEDIMENT AND EROSION BEFORE BEGINNING THE PROJECT. RESPONSIBLE PERSON ON SITE: AARON SMILEY.
  - THE DEVELOPER IS RESPONSIBLE FOR THE ACQUISITION OF ALL EASEMENTS, RIGHTS, RIGHT-OF-WAYS THAT MAY BE REQUIRED FOR THE SEDIMENT AND EROSION CONTROL PRACTICES, STORMWATER MANAGEMENT PRACTICES, AND THE DISCHARGE OF STORMWATER ONTO OR ACROSS ADJACENT OR DOWNSTREAM PROPERTIES INCLUDED IN THIS PLAN. HE IS ALSO RESPONSIBLE FOR THE ACQUISITION OF ALL EASEMENTS, RIGHTS, AND/OR RIGHT-OF-WAYS THAT MAY BE REQUIRED FOR GRADING AND/OR WORK ON ADJACENT PROPERTIES INCLUDED IN THIS PLAN.
  - THE SEDIMENT CONTROL APPROVALS ON THIS PLAN EXTEND ONLY TO AREAS AND PRACTICES IDENTIFIED AS PROPOSED WORK.
  - THE APPROVAL OF THIS PLAN FOR SEDIMENT AND EROSION CONTROL DOES NOT RELIEVE THE DEVELOPER/CONSULTANT FROM COMPLYING WITH ANY FEDERAL/STATE/COUNTY REQUIREMENTS APPURTENANT TO ENVIRONMENTAL ISSUES.

**LEGEND**

DESCRIPTION	EXISTING	PROPOSED
PROPERTY LINE	---	---
TREELINE	~~~~~	~~~~~
CONTOUR LINE	----- 250 -----	----- 250 -----
SPOT ELEVATION		+ 250
STORMDRAIN PIPE	=====	=====
LIMIT OF DISTURBANCE		L.O.D.
SILT FENCE		S.F.
HANDICAPPED SPACE		♿
FIRE HYDRANT	⦿ <sub>FH</sub>	⦿ <sub>FH</sub>
CURB & GUTTER	---	---
WHEELCHAIR RAMP		*
TOP OF WALL		T.W.
BOTTOM OF WALL		B.W.

BY THE DEVELOPER:

I/WE CERTIFY THAT ALL DEVELOPMENT AND/OR CONSTRUCTION WILL BE DONE IN ACCORDING TO THESE PLANS AND THAT ANY RESPONSIBLE PERSONNEL INVOLVED IN THE CONSTRUCTION PROJECT WILL HAVE A CERTIFICATE OF ATTENDANCE AT A DEPARTMENT OF THE ENVIRONMENT APPROVED TRAINING PROGRAM FOR THE CONTROL OF SEDIMENT AND EROSION BEFORE BEGINNING THE PROJECT. I/WE WILL PROVIDE THE HOWARD COUNTY CONSERVATION DISTRICT WITH AN "AS BUILT" PLAN OF THE PROJECT WITHIN 30 DAYS OF COMPLETION. I/WE ALSO AUTHORIZE PERIODIC ON-SITE INSPECTIONS BY THE HOWARD COUNTY CONSERVATION DISTRICT.

JOSEPH NAZARIO, OWNER  
NAZARIO DEVELOPMENT AND COMPANY  
2-6-98 DATE

BY THE ENGINEER:

I/WE CERTIFY THAT THIS PLAN FOR POND CONSTRUCTION, SOIL EROSION AND SEDIMENT CONTROL REPRESENTS A PRACTICAL AND WORKABLE PLAN BASED ON MY PERSONAL KNOWLEDGE OF THE SITE CONDITIONS. THIS PLAN WAS PREPARED IN ACCORDANCE WITH THE REQUIREMENTS OF THE HOWARD COUNTY CONSERVATION DISTRICT. I/WE HAVE ADVISED THE DEVELOPER THAT HE MUST SUBMIT THE HOWARD COUNTY CONSERVATION DISTRICT WITH AN "AS BUILT" PLAN OF THE PROJECT WITHIN 30 DAYS OF COMPLETION.

FRED L. SKELTON - MD. REGISTRATION No. 9070  
IPDS, LLC  
05-01-98 DATE

THESE PLANS HAVE BEEN REVIEWED FOR THE HOWARD COUNTY CONSERVATION DISTRICT AND MEET THE TECHNICAL REQUIREMENTS AND SMALL-POUND CONSTRUCTION, SOIL EROSION AND SEDIMENT CONTROL.

John R. Skelton 9/30/98 DATE  
NATURAL RESOURCES CONSERVATION SERVICE

THESE PLANS FOR SMALL-POUND CONSTRUCTION, SOIL EROSION AND SEDIMENT CONTROL MEET THE REQUIREMENTS OF THE HOWARD COUNTY CONSERVATION DISTRICT.

John R. Skelton 9/30/98 DATE  
HOWARD COUNTY CONSERVATION DISTRICT

APPROVED: FOR PUBLIC WATER AND PUBLIC SEWERAGE SYSTEMS,  
N/A HOWARD COUNTY HEALTH DEPARTMENT

COUNTY HEALTH OFFICER DATE

APPROVED: HOWARD COUNTY DEPARTMENT OF PLANNING AND ZONING

John R. Skelton 10/6/98 DATE  
DIRECTOR

Chris Hamilton 10/5/98 DATE  
CHIEF, DIVISION OF LAND DEVELOPMENT

John R. Skelton 10/1/98 DATE  
CHIEF, DEVELOPMENT ENGINEERING DIVISION

**AS BUILT CERTIFICATE**

FRED L. SKELTON - MD. REGISTRATION No. 9070  
IPDS, LLC DATE

**OWNER \ DEVELOPER**

Joseph Nazario  
Nazario Development and Company  
6500 Ammendale Road  
Beltsville, Maryland 20705  
(301) 937-4664



# DETAILS & SPECIFICATIONS - VEGETATIVE ESTABLISHMENT

FOLLOWING INITIAL SOIL DISTURBANCE OR REDISTURBANCE, PERMANENT OR TEMPORARY STABILIZATION SHALL BE COMPLETED WITHIN SEVEN CALENDAR DAYS FOR THE SURFACE OF ALL PERIMETER CONTROLS, DIKES, SWALES, DITCHES, PERIMETER SLOPES, AND ALL SLOPES GREATER THAN 3 HORIZONTAL TO 1 VERTICAL (3:1) AND FOURTEEN DAYS FOR ALL OTHER DISTURBED OR GRADED AREAS ON THE PROJECT SITE.

1. PERMANENT SEEDING:  
A. SOIL TESTS: LIME AND FERTILIZER WILL BE APPLIED PER SOIL TESTS RESULTS FOR SITES GREATER THAN 5 ACRES. SOIL TESTS WILL BE DONE AT COMPLETION OF ROUGH GRADING. RATES AND ANALYSES WILL BE PROVIDED TO THE GRADING INSPECTOR AS WELL AS THE CONTRACTOR.  
1. OCCURRENCE OF ADD SULFATE SOILS (GRAYISH BLACK COLOR) WILL REQUIRE COVERING WITH A MINIMUM OF 12 INCHES OF CLEAN SOIL WITH 8 INCHES MINIMUM CAPPING OF TOP SOIL. NO STOCKPILING OF MATERIAL IS ALLOWED. IF NEEDED, SOIL TESTS SHOULD BE DONE BEFORE AND AFTER A 6 WEEK INCUBATION PERIOD TO ALLOW OXIDATION OF SULFATES.

B. SEEDING PREPARATION: AREA TO BE SEEDING SHALL BE LOOSE AND FRAGILE TO A DEPTH OF AT LEAST 1 INCHES. THE TOP LAYER SHALL BE LOOSEEN BY RAKING, DISKING OR OTHER ACCEPTABLE MEANS BEFORE SEEDING OCCURS. FOR SITES LESS THAN 5 ACRES, APPLY 100 POUNDS OF DOLOMITIC LIMESTONE AND 21 POUNDS OF 10-20-20 FERTILIZER PER 1,000 SQUARE FEET. HARROW OR DISK LIME AND FERTILIZER INTO THE SOIL TO A DEPTH OF AT LEAST 3 INCHES ON SLOPES FLATTER THAN 3:1.

C. SEEDING: APPLY 5-8 POUNDS PER 1,000 SQUARE FEET OF TALL FESCUE BETWEEN FEBRUARY 1 AND APRIL 30 OR BETWEEN AUGUST 15 AND OCTOBER 31. APPLY SEED UNIFORMLY ON A MOST FIRM SEEDBED WITH A CYCLOPE SEEDER DRILL, CULTRIPACKER SEEDER OR HYDROSEEDER SLURRY INCLUDING SEEDS AND FERTILIZER, RECOMMENDED ON STEEP SLOPES ONLY. MAXIMUM SEED DEPTH SHOULD BE 1/4 INCH IN CLAYEY SOILS AND 1/2 INCH IN SANDY SOILS WHEN USING OTHER THAN THE HYDROSEEDER METHOD. BRIGADE IF SOIL MOISTURE IS DEFICIENT TO SUPPORT ADEQUATE GROWTH UNTIL VEGETATION IS FIRMLY ESTABLISHED. IF OTHER SEED MIXES ARE TO BE USED, SELECT FROM TABLE 26, ENTITLED "PERMANENT SEEDING FOR LOW MAINTENANCE AREAS" FROM THE 1994 STANDARDS AND SPECIFICATIONS FOR SOIL EROSION AND SEDIMENT CONTROL. MIXES SUITABLE FOR THIS AREA ARE 1:3 AND 5:7. MIXES 5:7 ARE SUITABLE IN NON-AVAILABLE SITUATIONS.

D. MULCHING: MULCH SHALL BE APPLIED TO ALL SEED AREAS IMMEDIATELY AFTER SEEDING DURING THE TIME PERIODS WHEN SEEDING IS NOT PERMITTED. MULCH SHALL BE APPLIED IMMEDIATELY AFTER GRADING. MULCH SHALL BE UNROTTED, UNCHOPPED, SMALL GRAIN STRAW APPLIED AT A RATE OF 2 TONS PER ACRE OR 90 POUNDS PER 1,000 SQUARE FEET (2 BALES). IF A MULCH ANCHORING TOOL IS USED, APPLY 2.5 TONS PER ACRE. MULCH MATERIALS SHALL BE RELATIVELY FREE OF ALL KINDS OF WEEDS AND SHALL BE FREE OF PROHIBITED NOXIOUS WEEDS. SPREAD MULCH UNIFORMLY, MECHANICALLY OR BY HAND, TO A DEPTH OF 1-2 INCHES.

E. SECURING STRAW MULCH: STRAW MULCH SHALL BE SECURED IMMEDIATELY FOLLOWING MULCH APPLICATION TO MINIMIZE MOVEMENT BY THE WIND OR THE WATER. THE FOLLOWING METHODS ARE PERMITTED:

1. USE A MULCH ANCHORING TOOL WHICH IS DESIGNED TO PUNCH AND ANCHOR MULCH INTO THE SOIL SURFACE TO A MINIMUM DEPTH OF 2 INCHES. THIS IS THE MOST EFFECTIVE METHOD FOR SECURING MULCH, HOWEVER, IT IS LIMITED TO RELATIVELY FLAT AREAS WHERE EQUIPMENT CAN OPERATE SAFELY.  
2. WOOD CELLULOSE FIBER MAY BE USED FOR ANCHORING STRAW. APPLY THE FIBER BINDER AT A NET DRY WEIGHT OF 750 POUNDS PER ACRE. IF MIXED WITH WATER, USE 10 POUNDS OF WOOD CELLULOSE FIBER PER 100 GALLONS OF WATER.  
3. LIQUID BINDERS MAY BE USED AND APPLIED HEAVIER AT THE EDGES WHERE WIND CATCHES MULCH, SUCH AS IN VALLEYS AND ON CRESTS OF SLOPES. THE REMAINDER OF THE AREA SHOULD APPEAR UNIFORM AFTER BINDER APPLICATION. BINDERS LISTED IN THE 1994 STANDARDS AND SPECIFICATIONS FOR SOIL EROSION AND SEDIMENT CONTROL OR APPROVED EQUIVALENT SHALL BE APPLIED AT RATES RECOMMENDED BY THE MANUFACTURER.  
4. LIGHTWEIGHT PLASTIC NETTING MAY BE USED TO SECURE MULCH. THE NETTING WILL BE STAPLED TO THE GROUND ACCORDING TO MANUFACTURER'S RECOMMENDATIONS.

2. TEMPORARY SEEDING:  
LIME: 100 POUNDS OF DOLOMITIC LIMESTONE PER 1,000 SQUARE FEET  
FERTILIZER: 15 POUNDS OF 10-10-10 PER 1,000 SQUARE FEET  
SEED: PERENNIAL RYE - 0.92 POUNDS PER 1,000 SQUARE FEET (FEBRUARY 1 THROUGH APRIL 30 OR AUGUST 15 THROUGH NOVEMBER 1) MILLET - 0.92 POUNDS PER 1,000 SQUARE FEET (MAY 1 THROUGH AUGUST 15)  
MULCH: SAME AS 1 D AND E ABOVE.

3. NO FILLS MAY BE PLACED ON FROZEN GROUND. ALL FILL TO BE PLACED IN APPROXIMATELY HORIZONTAL LAYERS, EACH LAYER HAVING A LOOSE THICKNESS OF NOT MORE THAN 8 INCHES. ALL FILL IN ROADWAYS AND PARKING AREAS IS TO BE CLASSIFIED TYPE 2 AND COMPACTED TO 90% DENSITY; COMPACTION TO BE DETERMINED BY ASTM D-697-86 MODIFIED PROCTOR. ANY FILL WITHIN THE BUILDING FOOTPRINT SHALL BE COMPACTED TO A MINIMUM OF 95% AS DETERMINED BY METHODS PREVIOUSLY MENTIONED. FILLS FOR POND EMBANKMENTS SHALL BE COMPACTED AS PER MD-378 CONSTRUCTION SPECIFICATIONS. ALL OTHER FILLS SHALL BE COMPACTED SUFFICIENTLY SO AS TO BE STABLE AND PREVENT EROSION AND SLIPPAGE.

4. PERMANENT SOIL:  
INSTALLATION OF SOD SHOULD FOLLOW PERMANENT SEEDING DETAILS. PERMANENT SOD IS TO BE TALL FESCUE, STATE APPROVED SOIL; LIME AND FERTILIZER PER PERMANENT SEEDING SPECIFICATIONS AND LIGHTLY BRIGADE SOIL PRIOR TO LAYING SOD. SOD IS TO BE LAD ON THE TOP OF THE CONTOUR WITH ALL ENDS TIGHTLY BUTTING. JOINTS ARE TO BE STAGGERED BETWEEN ROWS. WATER AND ROLL OR TAMP SOD TO INSURE POSITIVE ROOT CONTACT WITH THE SOIL. ALL SLOPES STEEPER THAN 3:1, AS SHOWN, ARE TO BE PERMANENTLY SODDED OR PROTECTED WITH AN APPROVED EROSION CONTROL NETTING. ADDITIONAL WATERING FOR ESTABLISHMENT MAY BE REQUIRED. SOD IS NOT TO BE APPLIED ON FROZEN GROUND. SOD SHALL NOT BE HARVESTED WHEN MOISTURE REMAINS IN THE SOIL. DRY (OR WET) AND/OR EXTREME TEMPERATURE MAY ADVERSELY AFFECT ITS SURVIVAL. IN THE ABSENCE OF ADEQUATE RAINFALL, IRRIGATION SHOULD BE PERFORMED TO INSURE ESTABLISHED SOD.


5. TOPSOIL:  
A. TOPSOIL SALVAGED FROM THE EXISTING SITE MAY BE USED PROVIDED THAT IT MEETS THE STANDARDS AS SET FORTH IN THESE SPECIFICATIONS. TYPICALLY, THE DEPTH OF TOPSOIL TO BE SALVAGED FOR A GIVEN SOIL TYPE CAN BE FOUND IN THE REPRESENTATIVE SOIL PROFILE SECTION IN THE SOIL SURVEY PUBLISHED BY USDA-SCS. TOPSOIL SHALL NOT BE USED IN AGRICULTURAL EXPERIMENTAL STATION.  
B. TOPSOIL SPECIFICATION - SOIL TO BE USED AS TOPSOIL MUST MEET THE FOLLOWING:  
TOPSOIL SHALL BE A LOAM, SANDY LOAM, CLAY LOAM, SILT LOAM, SANDY CLAY LOAM, AND LOAMY SAND. OTHER SOILS MAY BE USED IF RECOMMENDED BY AN AGRONOMIST OR SOIL SCIENTIST AND APPROVED BY THE APPROPRIATE APPROVAL AUTHORITY. REGARDLESS, TOPSOIL SHALL NOT BE A MIXTURE OF CONTRASTING TEXTURED SUBSOILS AND SHALL CONTAIN LESS THAN 5% BY VOLUME OF CEMENTS, STONES, SLAG, COARSE FRAGMENTS, GRAVEL, STICKS, ROOTS, TRASH, OR OTHER MATERIALS LARGER THAN 1 1/2" IN DIAMETER.

2. TOPSOIL MUST BE FREE OF PLANTS OR PLANT PARTS SUCH AS BERMUDA GRASS, QUACKGRASS, JOHNSONGRASS, NUTSEDGE, POISON IVY, THISTLE, OR OTHERS AS SPECIFIED.  
3. WHERE THE SUBSOIL IS EITHER HIGHLY ACIDIC OR COMPOSED OF HEAVY CLAYS, GROUND LIME SHALL BE SPREAD AT THE RATE OF 4-8 TONS/ACRE (500-400 POUNDS PER 1,000 SQUARE FEET) PRIOR TO THE PLACEMENT OF TOPSOIL. LIME SHALL BE DISTRIBUTED UNIFORMLY OVER DESIGNATED AREAS AND WORKED INTO THE SOIL IN CONJUNCTION WITH TILLAGE OPERATIONS AS DESCRIBED IN THE FOLLOWING PROCEDURES.  
C. FOR SITES HAVING DISTURBED AREAS UNDER 5 ACRES:

1. PLACE TOPSOIL (IF REQUIRED) AND APPLY SOIL AMENDMENTS AS SPECIFIED IN 2.0 VEGETATIVE STABILIZATION - SECTION I.  
VEGETATIVE STABILIZATION METHODS AND MATERIALS:  
NOTE: USE OF THIS INFORMATION DOES NOT PRECLUDE MEETING ALL OF THE REQUIREMENTS OF THE 1994 MARYLAND STANDARDS AND SPECIFICATIONS FOR SOIL EROSION AND SEDIMENT CONTROL.  
D. TOPSOIL APPLICATION:  
1. WHEN TOPSOILING, MAINTAIN NEEDED EROSION AND SEDIMENT CONTROL PRACTICES SUCH AS DIVERSIONS, GRADE STABILIZATION STRUCTURES, EARTH DIKES, SLOPE SILT FENCE, AND SEDIMENT TRAPS, AND BASINS.  
2. GRADES ON THE AREAS TO BE TOPSOILED, WHICH HAVE BEEN PREVIOUSLY ESTABLISHED, SHALL BE MAINTAINED, ALBERT 4"-8" HIGHER IN ELEVATION.  
3. TOPSOIL SHALL BE UNIFORMLY DISTRIBUTED IN A 4"-8" LAYER AND LIGHTLY COMPACTED TO A MINIMUM THICKNESS OF 4". SPREADING SHALL BE PERFORMED IN SUCH A MANNER THAT SOIL COMPACTION OR SEEDING CAN PROCEED WITH A MINIMUM OF ADDITIONAL SOIL PREPARATION AND TILLAGE. ANY IRREGULARITIES IN THE SURFACE RESULTING FROM TOPSOILING OR OTHER OPERATIONS SHALL BE CORRECTED IN ORDER TO PREVENT THE FORMATION OF DEPRESSIONS OR WATER POCKETS.

4. TOPSOIL SHALL NOT BE PLACED WHILE THE TOPSOIL OR SUBSOIL IS IN A FRAZEN OR MUDDY CONDITION, WHEN THE SUBSOIL IS EXCESSIVELY WET OR IN A CONDITION THAT MAY PROVE BE DETRIMENTAL TO PROPER GRADING AND SEEDING PREPARATION.

## DETAIL 1 - EARTH DIKE

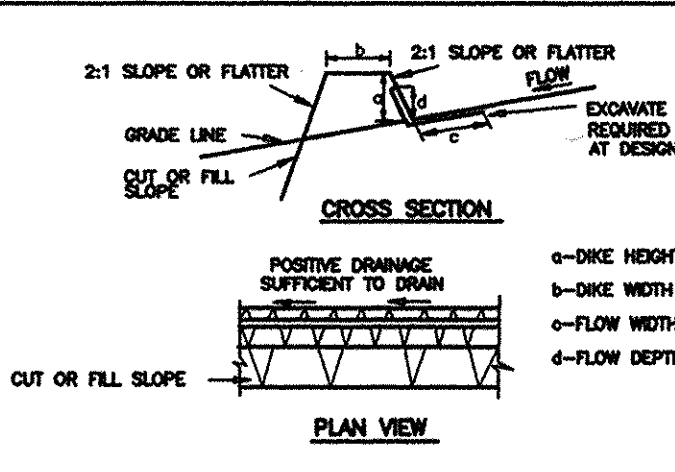

1. Seed and cover with straw mulch.  
2. Seed and cover with Erosion Control Matting or line with sod.  
3. 4" - 7" stone or recycled concrete equivalent pressed into the soil 7" minimum.

CONSTRUCTION SPECIFICATIONS  
1. All temporary work dikes shall have uninterrupted positive grade to an outlet. Spot elevations may be necessary for grades less than 1%.

2. Runoff diverted from a disturbed area shall be conveyed to a sediment trapping device.  
3. Runoff diverted from an undisturbed area shall outlet directly into an undisturbed, stabilized area of a non-erosive velocity.

4. All trees, brush, stumps, obstructions, and other objectionable material shall be removed and disposed of so as not to interfere with the proper functioning of the dike.  
5. The dike shall be excavated or shaped to firm, grade and cross section as required to meet the criteria specified herein and be free of bank projections or other irregularities which will impede normal flow.  
6. Fill shall be compacted by earth moving equipment.

7. All earth removed and not needed for construction shall be placed so that it will not interfere with the functioning of the dike.  
8. Inspection and maintenance must be provided periodically and after each rain event.

U.S. DEPARTMENT OF AGRICULTURE, SOIL CONSERVATION SERVICE, PAGE A-1 - 6, MARYLAND DEPARTMENT OF ENVIRONMENT, WATER MANAGEMENT ADMINISTRATION

## DET. 10A - STONE/RIP-RAP OUTLET SEDIMENT TRAP - ST IV

1. USE A MULCH ANCHORING TOOL WHICH IS DESIGNED TO PUNCH AND ANCHOR MULCH INTO THE SOIL SURFACE TO A MINIMUM DEPTH OF 2 INCHES. THIS IS THE MOST EFFECTIVE METHOD FOR SECURING MULCH, HOWEVER, IT IS LIMITED TO RELATIVELY FLAT AREAS WHERE EQUIPMENT CAN OPERATE SAFELY.

2. WOOD CELLULOSE FIBER MAY BE USED FOR ANCHORING STRAW. APPLY THE FIBER BINDER AT A NET DRY WEIGHT OF 750 POUNDS PER ACRE. IF MIXED WITH WATER, USE 10 POUNDS OF WOOD CELLULOSE FIBER PER 100 GALLONS OF WATER.  
3. LIQUID BINDERS MAY BE USED AND APPLIED HEAVIER AT THE EDGES WHERE WIND CATCHES MULCH, SUCH AS IN VALLEYS AND ON CRESTS OF SLOPES. THE REMAINDER OF THE AREA SHOULD APPEAR UNIFORM AFTER BINDER APPLICATION. BINDERS LISTED IN THE 1994 STANDARDS AND SPECIFICATIONS FOR SOIL EROSION AND SEDIMENT CONTROL OR APPROVED EQUIVALENT SHALL BE APPLIED AT RATES RECOMMENDED BY THE MANUFACTURER.  
4. LIGHTWEIGHT PLASTIC NETTING MAY BE USED TO SECURE MULCH. THE NETTING WILL BE STAPLED TO THE GROUND ACCORDING TO MANUFACTURER'S RECOMMENDATIONS.

2. TEMPORARY SEEDING:  
LIME: 100 POUNDS OF DOLOMITIC LIMESTONE PER 1,000 SQUARE FEET  
FERTILIZER: 15 POUNDS OF 10-10-10 PER 1,000 SQUARE FEET  
SEED: PERENNIAL RYE - 0.92 POUNDS PER 1,000 SQUARE FEET (FEBRUARY 1 THROUGH APRIL 30 OR AUGUST 15 THROUGH NOVEMBER 1) MILLET - 0.92 POUNDS PER 1,000 SQUARE FEET (MAY 1 THROUGH AUGUST 15)  
MULCH: SAME AS 1 D AND E ABOVE.

3. NO FILLS MAY BE PLACED ON FROZEN GROUND. ALL FILL TO BE PLACED IN APPROXIMATELY HORIZONTAL LAYERS, EACH LAYER HAVING A LOOSE THICKNESS OF NOT MORE THAN 8 INCHES. ALL FILL IN ROADWAYS AND PARKING AREAS IS TO BE CLASSIFIED TYPE 2 AND COMPACTED TO 90% DENSITY; COMPACTION TO BE DETERMINED BY ASTM D-697-86 MODIFIED PROCTOR. ANY FILL WITHIN THE BUILDING FOOTPRINT SHALL BE COMPACTED TO A MINIMUM OF 95% AS DETERMINED BY METHODS PREVIOUSLY MENTIONED. FILLS FOR POND EMBANKMENTS SHALL BE COMPACTED AS PER MD-378 CONSTRUCTION SPECIFICATIONS. ALL OTHER FILLS SHALL BE COMPACTED SUFFICIENTLY SO AS TO BE STABLE AND PREVENT EROSION AND SLIPPAGE.

4. PERMANENT SOIL:  
INSTALLATION OF SOD SHOULD FOLLOW PERMANENT SEEDING DETAILS. PERMANENT SOD IS TO BE TALL FESCUE, STATE APPROVED SOIL; LIME AND FERTILIZER PER PERMANENT SEEDING SPECIFICATIONS AND LIGHTLY BRIGADE SOIL PRIOR TO LAYING SOD. SOD IS TO BE LAD ON THE TOP OF THE CONTOUR WITH ALL ENDS TIGHTLY BUTTING. JOINTS ARE TO BE STAGGERED BETWEEN ROWS. WATER AND ROLL OR TAMP SOD TO INSURE POSITIVE ROOT CONTACT WITH THE SOIL. ALL SLOPES STEEPER THAN 3:1, AS SHOWN, ARE TO BE PERMANENTLY SODDED OR PROTECTED WITH AN APPROVED EROSION CONTROL NETTING. ADDITIONAL WATERING FOR ESTABLISHMENT MAY BE REQUIRED. SOD IS NOT TO BE APPLIED ON FROZEN GROUND. SOD SHALL NOT BE HARVESTED WHEN MOISTURE REMAINS IN THE SOIL. DRY (OR WET) AND/OR EXTREME TEMPERATURE MAY ADVERSELY AFFECT ITS SURVIVAL. IN THE ABSENCE OF ADEQUATE RAINFALL, IRRIGATION SHOULD BE PERFORMED TO INSURE ESTABLISHED SOD.

5. TOPSOIL:  
A. TOPSOIL SALVAGED FROM THE EXISTING SITE MAY BE USED PROVIDED THAT IT MEETS THE STANDARDS AS SET FORTH IN THESE SPECIFICATIONS. TYPICALLY, THE DEPTH OF TOPSOIL TO BE SALVAGED FOR A GIVEN SOIL TYPE CAN BE FOUND IN THE REPRESENTATIVE SOIL PROFILE SECTION IN THE SOIL SURVEY PUBLISHED BY USDA-SCS. TOPSOIL SHALL NOT BE USED IN AGRICULTURAL EXPERIMENTAL STATION.  
B. TOPSOIL SPECIFICATION - SOIL TO BE USED AS TOPSOIL MUST MEET THE FOLLOWING:  
TOPSOIL SHALL BE A LOAM, SANDY LOAM, CLAY LOAM, SILT LOAM, SANDY CLAY LOAM, AND LOAMY SAND. OTHER SOILS MAY BE USED IF RECOMMENDED BY AN AGRONOMIST OR SOIL SCIENTIST AND APPROVED BY THE APPROPRIATE APPROVAL AUTHORITY. REGARDLESS, TOPSOIL SHALL NOT BE A MIXTURE OF CONTRASTING TEXTURED SUBSOILS AND SHALL CONTAIN LESS THAN 5% BY VOLUME OF CEMENTS, STONES, SLAG, COARSE FRAGMENTS, GRAVEL, STICKS, ROOTS, TRASH, OR OTHER MATERIALS LARGER THAN 1 1/2" IN DIAMETER.


2. TOPSOIL MUST BE FREE OF PLANTS OR PLANT PARTS SUCH AS BERMUDA GRASS, QUACKGRASS, JOHNSONGRASS, NUTSEDGE, POISON IVY, THISTLE, OR OTHERS AS SPECIFIED.  
3. WHERE THE SUBSOIL IS EITHER HIGHLY ACIDIC OR COMPOSED OF HEAVY CLAYS, GROUND LIME SHALL BE SPREAD AT THE RATE OF 4-8 TONS/ACRE (500-400 POUNDS PER 1,000 SQUARE FEET) PRIOR TO THE PLACEMENT OF TOPSOIL. LIME SHALL BE DISTRIBUTED UNIFORMLY OVER DESIGNATED AREAS AND WORKED INTO THE SOIL IN CONJUNCTION WITH TILLAGE OPERATIONS AS DESCRIBED IN THE FOLLOWING PROCEDURES.  
C. FOR SITES HAVING DISTURBED AREAS UNDER 5 ACRES:

1. PLACE TOPSOIL (IF REQUIRED) AND APPLY SOIL AMENDMENTS AS SPECIFIED IN 2.0 VEGETATIVE STABILIZATION - SECTION I.  
VEGETATIVE STABILIZATION METHODS AND MATERIALS:  
NOTE: USE OF THIS INFORMATION DOES NOT PRECLUDE MEETING ALL OF THE REQUIREMENTS OF THE 1994 MARYLAND STANDARDS AND SPECIFICATIONS FOR SOIL EROSION AND SEDIMENT CONTROL.  
D. TOPSOIL APPLICATION:  
1. WHEN TOPSOILING, MAINTAIN NEEDED EROSION AND SEDIMENT CONTROL PRACTICES SUCH AS DIVERSIONS, GRADE STABILIZATION STRUCTURES, EARTH DIKES, SLOPE SILT FENCE, AND SEDIMENT TRAPS, AND BASINS.  
2. GRADES ON THE AREAS TO BE TOPSOILED, WHICH HAVE BEEN PREVIOUSLY ESTABLISHED, SHALL BE MAINTAINED, ALBERT 4"-8" HIGHER IN ELEVATION.  
3. TOPSOIL SHALL BE UNIFORMLY DISTRIBUTED IN A 4"-8" LAYER AND LIGHTLY COMPACTED TO A MINIMUM THICKNESS OF 4". SPREADING SHALL BE PERFORMED IN SUCH A MANNER THAT SOIL COMPACTION OR SEEDING CAN PROCEED WITH A MINIMUM OF ADDITIONAL SOIL PREPARATION AND TILLAGE. ANY IRREGULARITIES IN THE SURFACE RESULTING FROM TOPSOILING OR OTHER OPERATIONS SHALL BE CORRECTED IN ORDER TO PREVENT THE FORMATION OF DEPRESSIONS OR WATER POCKETS.

4. TOPSOIL SHALL NOT BE PLACED WHILE THE TOPSOIL OR SUBSOIL IS IN A FRAZEN OR MUDDY CONDITION, WHEN THE SUBSOIL IS EXCESSIVELY WET OR IN A CONDITION THAT MAY PROVE BE DETRIMENTAL TO PROPER GRADING AND SEEDING PREPARATION.

U.S. DEPARTMENT OF AGRICULTURE, SOIL CONSERVATION SERVICE, PAGE C-9 - 16, MARYLAND DEPARTMENT OF ENVIRONMENT, WATER MANAGEMENT ADMINISTRATION


## DETAIL 24 - STABILIZED CONSTRUCTION ENTRANCE

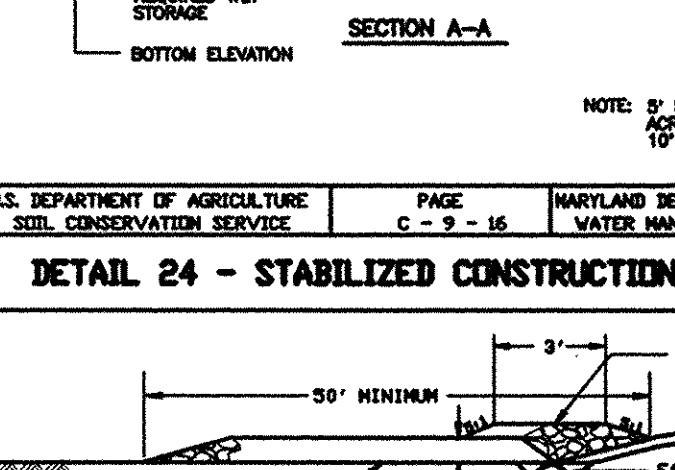

1. Length - minimum of 50' (<30' for single residence lot).  
2. Width - 10' minimum, should be flared at the existing road to provide a turning radius.  
3. Geotextile fabric (filter cloth) shall be placed over the existing ground prior to placing stone. The plan approval authority may not require single family residences to use geotextile.  
4. Stone - crushed aggregate (2" to 3") or reclaimed or recycled concrete equivalent shall be placed at least 6" deep over the length and width of the entrance.  
5. Surface Water - all surface water flowing to or diverted toward construction entrances shall be piped through the entrance, maintaining positive drainage. Pipe installed through the stabilized construction entrance shall be protected with a non-erodible term with 5:1 slopes and a minimum of 6" of stone over the pipe. Pipe has to be sized according to the drainage. When the SCE is located at a high spot and has no drainage to convey a pipe will not be necessary. Pipe should be sized according to the amount of runoff to be conveyed. A 6" minimum will be required.  
6. Location - A stabilized construction entrance shall be located at every point where construction traffic enters or leaves a construction site. Vehicles leaving the site must travel over the entire length of the stabilized construction entrance.

U.S. DEPARTMENT OF AGRICULTURE, SOIL CONSERVATION SERVICE, PAGE F-17 - 3, MARYLAND DEPARTMENT OF ENVIRONMENT, WATER MANAGEMENT ADMINISTRATION

## DETAIL 5 - RIP-RAP INFLOW PROTECTION

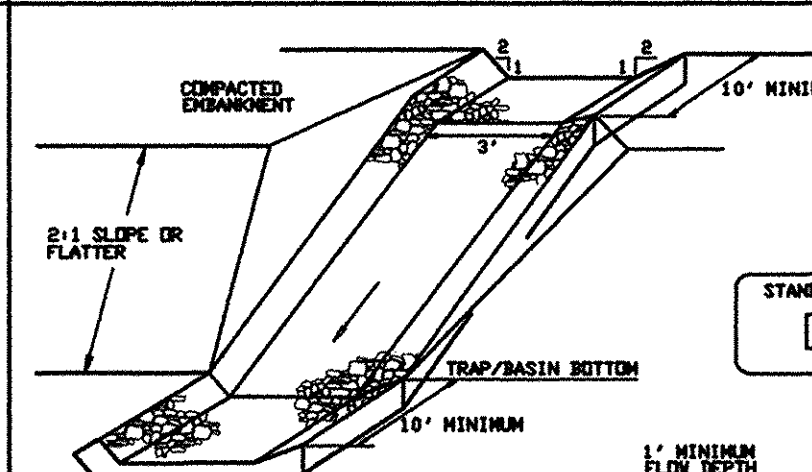

1. Seed and cover with straw mulch.  
2. Seed and cover with Erosion Control Matting or line with sod.  
3. 4" - 7" stone or recycled concrete equivalent pressed into the soil 7" minimum.

CONSTRUCTION SPECIFICATIONS  
1. All temporary work dikes shall have uninterrupted positive grade to an outlet. Spot elevations may be necessary for grades less than 1%.

2. Runoff diverted from a disturbed area shall be conveyed to a sediment trapping device.  
3. Runoff diverted from an undisturbed area shall outlet directly into an undisturbed, stabilized area of a non-erosive velocity.

4. All trees, brush, stumps, obstructions, and other objectionable material shall be removed and disposed of so as not to interfere with the proper functioning of the dike.  
5. The dike shall be excavated or shaped to firm, grade and cross section as required to meet the criteria specified herein and be free of bank projections or other irregularities which will impede normal flow.  
6. Fill shall be compacted by earth moving equipment.

7. All earth removed and not needed for construction shall be placed so that it will not interfere with the functioning of the dike.  
8. Inspection and maintenance must be provided periodically and after each rain event.

U.S. DEPARTMENT OF AGRICULTURE, SOIL CONSERVATION SERVICE, PAGE B-6 - 8, MARYLAND DEPARTMENT OF ENVIRONMENT, WATER MANAGEMENT ADMINISTRATION

## STONE RIP-RAP OUTLET SEDIMENT TRAP - ST IV

1. USE A MULCH ANCHORING TOOL WHICH IS DESIGNED TO PUNCH AND ANCHOR MULCH INTO THE SOIL SURFACE TO A MINIMUM DEPTH OF 2 INCHES. THIS IS THE MOST EFFECTIVE METHOD FOR SECURING MULCH, HOWEVER, IT IS LIMITED TO RELATIVELY FLAT AREAS WHERE EQUIPMENT CAN OPERATE SAFELY.

2. WOOD CELLULOSE FIBER MAY BE USED FOR ANCHORING STRAW. APPLY THE FIBER BINDER AT A NET DRY WEIGHT OF 750 POUNDS PER ACRE. IF MIXED WITH WATER, USE 10 POUNDS OF WOOD CELLULOSE FIBER PER 100 GALLONS OF WATER.  
3. LIQUID BINDERS MAY BE USED AND APPLIED HEAVIER AT THE EDGES WHERE WIND CATCHES MULCH, SUCH AS IN VALLEYS AND ON CRESTS OF SLOPES. THE REMAINDER OF THE AREA SHOULD APPEAR UNIFORM AFTER BINDER APPLICATION. BINDERS LISTED IN THE 1994 STANDARDS AND SPECIFICATIONS FOR SOIL EROSION AND SEDIMENT CONTROL OR APPROVED EQUIVALENT SHALL BE APPLIED AT RATES RECOMMENDED BY THE MANUFACTURER.  
4. LIGHTWEIGHT PLASTIC NETTING MAY BE USED TO SECURE MULCH. THE NETTING WILL BE STAPLED TO THE GROUND ACCORDING TO MANUFACTURER'S RECOMMENDATIONS.

2. TEMPORARY SEEDING:  
LIME: 100 POUNDS OF DOLOMITIC LIMESTONE PER 1,000 SQUARE FEET  
FERTILIZER: 15 POUNDS OF 10-10-10 PER 1,000 SQUARE FEET  
SEED: PERENNIAL RYE - 0.92 POUNDS PER 1,000 SQUARE FEET (FEBRUARY 1 THROUGH APRIL 30 OR AUGUST 15 THROUGH NOVEMBER 1) MILLET - 0.92 POUNDS PER 1,000 SQUARE FEET (MAY 1 THROUGH AUGUST 15)  
MULCH: SAME AS 1 D AND E ABOVE.

3. NO FILLS MAY BE PLACED ON FROZEN GROUND. ALL FILL TO BE PLACED IN APPROXIMATELY HORIZONTAL LAYERS, EACH LAYER HAVING A LOOSE THICKNESS OF NOT MORE THAN 8 INCHES. ALL FILL IN ROADWAYS AND PARKING AREAS IS TO BE CLASSIFIED TYPE 2 AND COMPACTED TO 90% DENSITY; COMPACTION TO BE DETERMINED BY ASTM D-697-86 MODIFIED PROCTOR. ANY FILL WITHIN THE BUILDING FOOTPRINT SHALL BE COMPACTED TO A MINIMUM OF 95% AS DETERMINED BY METHODS PREVIOUSLY MENTIONED. FILLS FOR POND EMBANKMENTS SHALL BE COMPACTED AS PER MD-378 CONSTRUCTION SPECIFICATIONS. ALL OTHER FILLS SHALL BE COMPACTED SUFFICIENTLY SO AS TO BE STABLE AND PREVENT EROSION AND SLIPPAGE.

4. PERMANENT SOIL:  
INSTALLATION OF SOD SHOULD FOLLOW PERMANENT SEEDING DETAILS. PERMANENT SOD IS TO BE TALL FESCUE, STATE APPROVED SOIL; LIME AND FERTILIZER PER PERMANENT SEEDING SPECIFICATIONS AND LIGHTLY BRIGADE SOIL PRIOR TO LAYING SOD. SOD IS TO BE LAD ON THE TOP OF THE CONTOUR WITH ALL ENDS TIGHTLY BUTTING. JOINTS ARE TO BE STAGGERED BETWEEN ROWS. WATER AND ROLL OR TAMP SOD TO INSURE POSITIVE ROOT CONTACT WITH THE SOIL. ALL SLOPES STEEPER THAN 3:1, AS SHOWN, ARE TO BE PERMANENTLY SODDED OR PROTECTED WITH AN APPROVED EROSION CONTROL NETTING. ADDITIONAL WATERING FOR ESTABLISHMENT MAY BE REQUIRED. SOD IS NOT TO BE APPLIED ON FROZEN GROUND. SOD SHALL NOT BE HARVESTED WHEN MOISTURE REMAINS IN THE SOIL. DRY (OR WET) AND/OR EXTREME TEMPERATURE MAY ADVERSELY AFFECT ITS SURVIVAL. IN THE ABSENCE OF ADEQUATE RAINFALL, IRRIGATION SHOULD BE PERFORMED TO INSURE ESTABLISHED SOD.

5. TOPSOIL:  
A. TOPSOIL SALVAGED FROM THE EXISTING SITE MAY BE USED PROVIDED THAT IT MEETS THE STANDARDS AS SET FORTH IN THESE SPECIFICATIONS. TYPICALLY, THE DEPTH OF TOPSOIL TO BE SALVAGED FOR A GIVEN SOIL TYPE CAN BE FOUND IN THE REPRESENTATIVE SOIL PROFILE SECTION IN THE SOIL SURVEY PUBLISHED BY USDA-SCS. TOPSOIL SHALL NOT BE USED IN AGRICULTURAL EXPERIMENTAL STATION.  
B. TOPSOIL SPECIFICATION - SOIL TO BE USED AS TOPSOIL MUST MEET THE FOLLOWING:  
TOPSOIL SHALL BE A LOAM, SANDY LOAM, CLAY LOAM, SILT LOAM, SANDY CLAY LOAM, AND LOAMY SAND. OTHER SOILS MAY BE USED IF RECOMMENDED BY AN AGRONOMIST OR SOIL SCIENTIST AND APPROVED BY THE APPROPRIATE APPROVAL AUTHORITY. REGARDLESS, TOPSOIL SHALL NOT BE A MIXTURE OF CONTRASTING TEXTURED SUBSOILS AND SHALL CONTAIN LESS THAN 5% BY VOLUME OF CEMENTS, STONES, SLAG, COARSE FRAGMENTS, GRAVEL, STICKS, ROOTS, TRASH, OR OTHER MATERIALS LARGER THAN 1 1/2" IN DIAMETER.


2. TOPSOIL MUST BE FREE OF PLANTS OR PLANT PARTS SUCH AS BERMUDA GRASS, QUACKGRASS, JOHNSONGRASS, NUTSEDGE, POISON IVY, THISTLE, OR OTHERS AS SPECIFIED.  
3. WHERE THE SUBSOIL IS EITHER HIGHLY ACIDIC OR COMPOSED OF HEAVY CLAYS, GROUND LIME SHALL BE SPREAD AT THE RATE OF 4-8 TONS/ACRE (500-400 POUNDS PER 1,000 SQUARE FEET) PRIOR TO THE PLACEMENT OF TOPSOIL. LIME SHALL BE DISTRIBUTED UNIFORMLY OVER DESIGNATED AREAS AND WORKED INTO THE SOIL IN CONJUNCTION WITH TILLAGE OPERATIONS AS DESCRIBED IN THE FOLLOWING PROCEDURES.  
C. FOR SITES HAVING DISTURBED AREAS UNDER 5 ACRES:

1. PLACE TOPSOIL (IF REQUIRED) AND APPLY SOIL AMENDMENTS AS SPECIFIED IN 2.0 VEGETATIVE STABILIZATION - SECTION I.  
VEGETATIVE STABILIZATION METHODS AND MATERIALS:  
NOTE: USE OF THIS INFORMATION DOES NOT PRECLUDE MEETING ALL OF THE REQUIREMENTS OF THE 1994 MARYLAND STANDARDS AND SPECIFICATIONS FOR SOIL EROSION AND SEDIMENT CONTROL.  
D. TOPSOIL APPLICATION:  
1. WHEN TOPSOILING, MAINTAIN NEEDED EROSION AND SEDIMENT CONTROL PRACTICES SUCH AS DIVERSIONS, GRADE STABILIZATION STRUCTURES, EARTH DIKES, SLOPE SILT FENCE, AND SEDIMENT TRAPS, AND BASINS.  
2. GRADES ON THE AREAS TO BE TOPSOILED, WHICH HAVE BEEN PREVIOUSLY ESTABLISHED, SHALL BE MAINTAINED, ALBERT 4"-8" HIGHER IN ELEVATION.  
3. TOPSOIL SHALL BE UNIFORMLY DISTRIBUTED IN A 4"-8" LAYER AND LIGHTLY COMPACTED TO A MINIMUM THICKNESS OF 4". SPREADING SHALL BE PERFORMED IN SUCH A MANNER THAT SOIL COMPACTION OR SEEDING CAN PROCEED WITH A MINIMUM OF ADDITIONAL SOIL PREPARATION AND TILLAGE. ANY IRREGULARITIES IN THE SURFACE RESULTING FROM TOPSOILING OR OTHER OPERATIONS SHALL BE CORRECTED IN ORDER TO PREVENT THE FORMATION OF DEPRESSIONS OR WATER POCKETS.

4. TOPSOIL SHALL NOT BE PLACED WHILE THE TOPSOIL OR SUBSOIL IS IN A FRAZEN OR MUDDY CONDITION, WHEN THE SUBSOIL IS EXCESSIVELY WET OR IN A CONDITION THAT MAY PROVE BE DETRIMENTAL TO PROPER GRADING AND SEEDING PREPARATION.

U.S. DEPARTMENT OF AGRICULTURE, SOIL CONSERVATION SERVICE, PAGE C-9 - 16A, MARYLAND DEPARTMENT OF ENVIRONMENT, WATER MANAGEMENT ADMINISTRATION


## STABILIZED CONSTRUCTION ENTRANCE

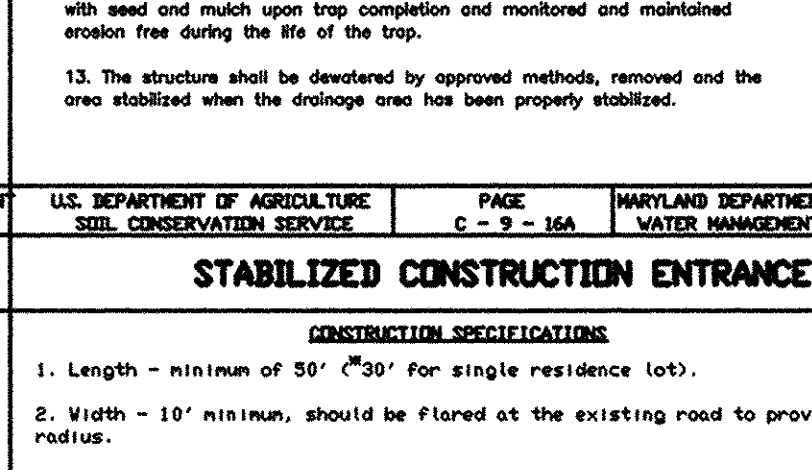

1. Length - minimum of 50' (<30' for single residence lot).  
2. Width - 10' minimum, should be flared at the existing road to provide a turning radius.  
3. Geotextile fabric (filter cloth) shall be placed over the existing ground prior to placing stone. The plan approval authority may not require single family residences to use geotextile.  
4. Stone - crushed aggregate (2" to 3") or reclaimed or recycled concrete equivalent shall be placed at least 6" deep over the length and width of the entrance.  
5. Surface Water - all surface water flowing to or diverted toward construction entrances shall be piped through the entrance, maintaining positive drainage. Pipe installed through the stabilized construction entrance shall be protected with a non-erodible term with 5:1 slopes and a minimum of 6" of stone over the pipe. Pipe has to be sized according to the drainage. When the SCE is located at a high spot and has no drainage to convey a pipe will not be necessary. Pipe should be sized according to the amount of runoff to be conveyed. A 6" minimum will be required.  
6. Location - A stabilized construction entrance shall be located at every point where construction traffic enters or leaves a construction site. Vehicles leaving the site must travel over the entire length of the stabilized construction entrance.

U.S. DEPARTMENT OF AGRICULTURE, SOIL CONSERVATION SERVICE, PAGE F-17 - 3a, MARYLAND DEPARTMENT OF ENVIRONMENT, WATER MANAGEMENT ADMINISTRATION


## SUPER SILT FENCE

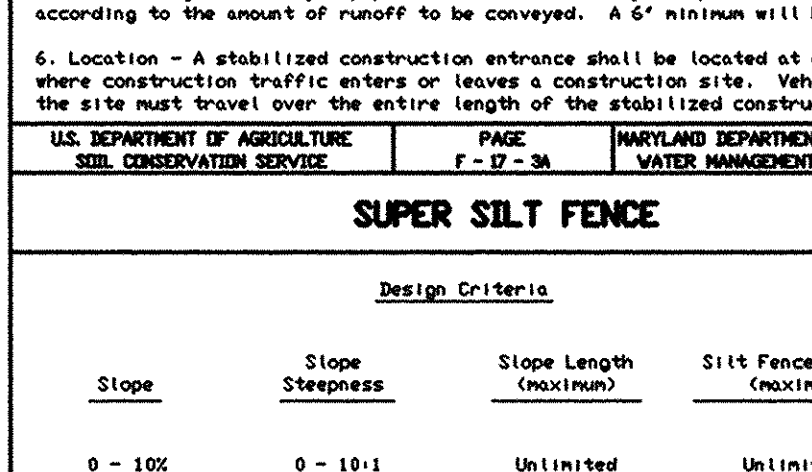

1. Length - minimum of 50' (<30' for single residence lot).  
2. Width - 10' minimum, should be flared at the existing road to provide a turning radius.  
3. Geotextile fabric (filter cloth) shall be placed over the existing ground prior to placing stone. The plan approval authority may not require single family residences to use geotextile.  
4. Stone - crushed aggregate (2" to 3") or reclaimed or recycled concrete equivalent shall be placed at least 6" deep over the length and width of the entrance.  
5. Surface Water - all surface water flowing to or diverted toward construction entrances shall be piped through the entrance, maintaining positive drainage. Pipe installed through the stabilized construction entrance shall be protected with a non-erodible term with 5:1 slopes and a minimum of 6" of stone over the pipe. Pipe has to be sized according to the drainage. When the SCE is located at a high spot and has no drainage to convey a pipe will not be necessary. Pipe should be sized according to the amount of runoff to be conveyed. A 6" minimum will be required.  
6. Location - A stabilized construction entrance shall be located at every point where construction traffic enters or leaves a construction site. Vehicles leaving the site must travel over the entire length of the stabilized construction entrance.

U.S. DEPARTMENT OF AGRICULTURE, SOIL CONSERVATION SERVICE, PAGE H-26 - 3a, MARYLAND DEPARTMENT OF ENVIRONMENT, WATER MANAGEMENT ADMINISTRATION

## DETAIL 27 - ROCK OUTLET PROTECTION III

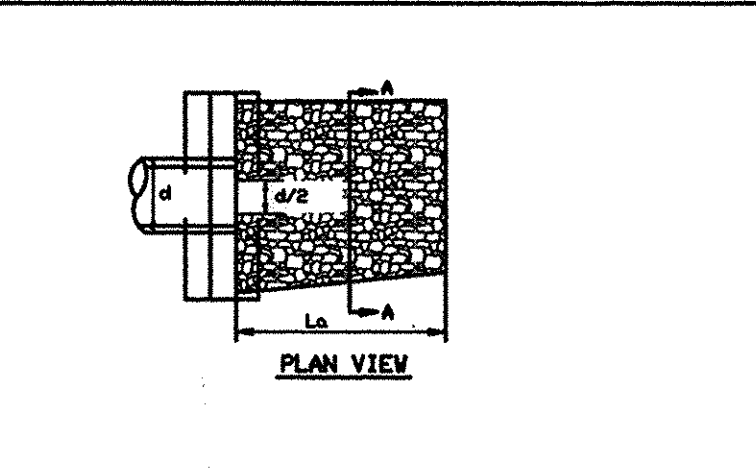

1. Seed and cover with straw mulch.  
2. Seed and cover with Erosion Control Matting or line with sod.  
3. 4" - 7" stone or recycled concrete equivalent pressed into the soil 7" minimum.

CONSTRUCTION SPECIFICATIONS  
1. All temporary work dikes shall have uninterrupted positive grade to an outlet. Spot elevations may be necessary for grades less than 1%.


2. Runoff diverted from a disturbed area shall be conveyed to a sediment trapping device.  
3. Runoff diverted from an undisturbed area shall outlet directly into an undisturbed, stabilized area of a non-erosive velocity.

4. All trees, brush, stumps, obstructions, and other objectionable material shall be removed and disposed of so as not to interfere with the proper functioning of the dike.  
5. The dike shall be excavated or shaped to firm, grade and cross section as required to meet the criteria specified herein and be free of bank projections or other irregularities which will impede normal flow.  
6. Fill shall be compacted by earth moving equipment.

7. All earth removed and not needed for construction shall be placed so that it will not interfere with the functioning of the dike.  
8. Inspection and maintenance must be provided periodically and after each rain event.


U.S. DEPARTMENT OF AGRICULTURE, SOIL CONSERVATION SERVICE, PAGE F-18 - 3, MARYLAND DEPARTMENT OF ENVIRONMENT, WATER MANAGEMENT ADMINISTRATION

## DETAIL 22 - SILT FENCE

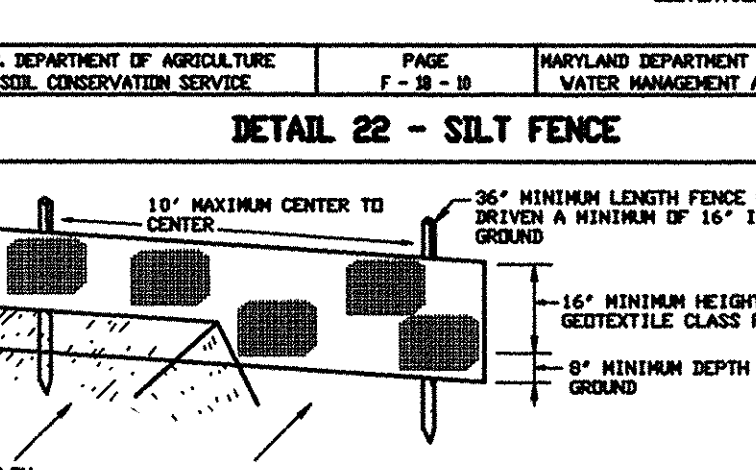


1. Length - minimum of 50' (<30' for single residence lot).  
2. Width - 10' minimum, should be flared at the existing road to provide a turning radius.  
3. Geotextile fabric (filter cloth) shall be placed over the existing ground prior to placing stone. The plan approval authority may not require single family residences to use geotextile.  
4. Stone - crushed aggregate (2" to 3") or reclaimed or recycled concrete equivalent shall be placed at least 6" deep over the length and width of the entrance.  
5. Surface Water - all surface water flowing to or diverted toward construction entrances shall be piped through the entrance, maintaining positive drainage. Pipe installed through the stabilized construction entrance shall be protected with a non-erodible term with 5:1 slopes and a minimum of 6" of stone over the pipe. Pipe has to be sized according to the drainage. When the SCE is located at a high spot and has no drainage to convey a pipe will not be necessary. Pipe should be sized according to the amount of runoff to be conveyed. A 6" minimum will be



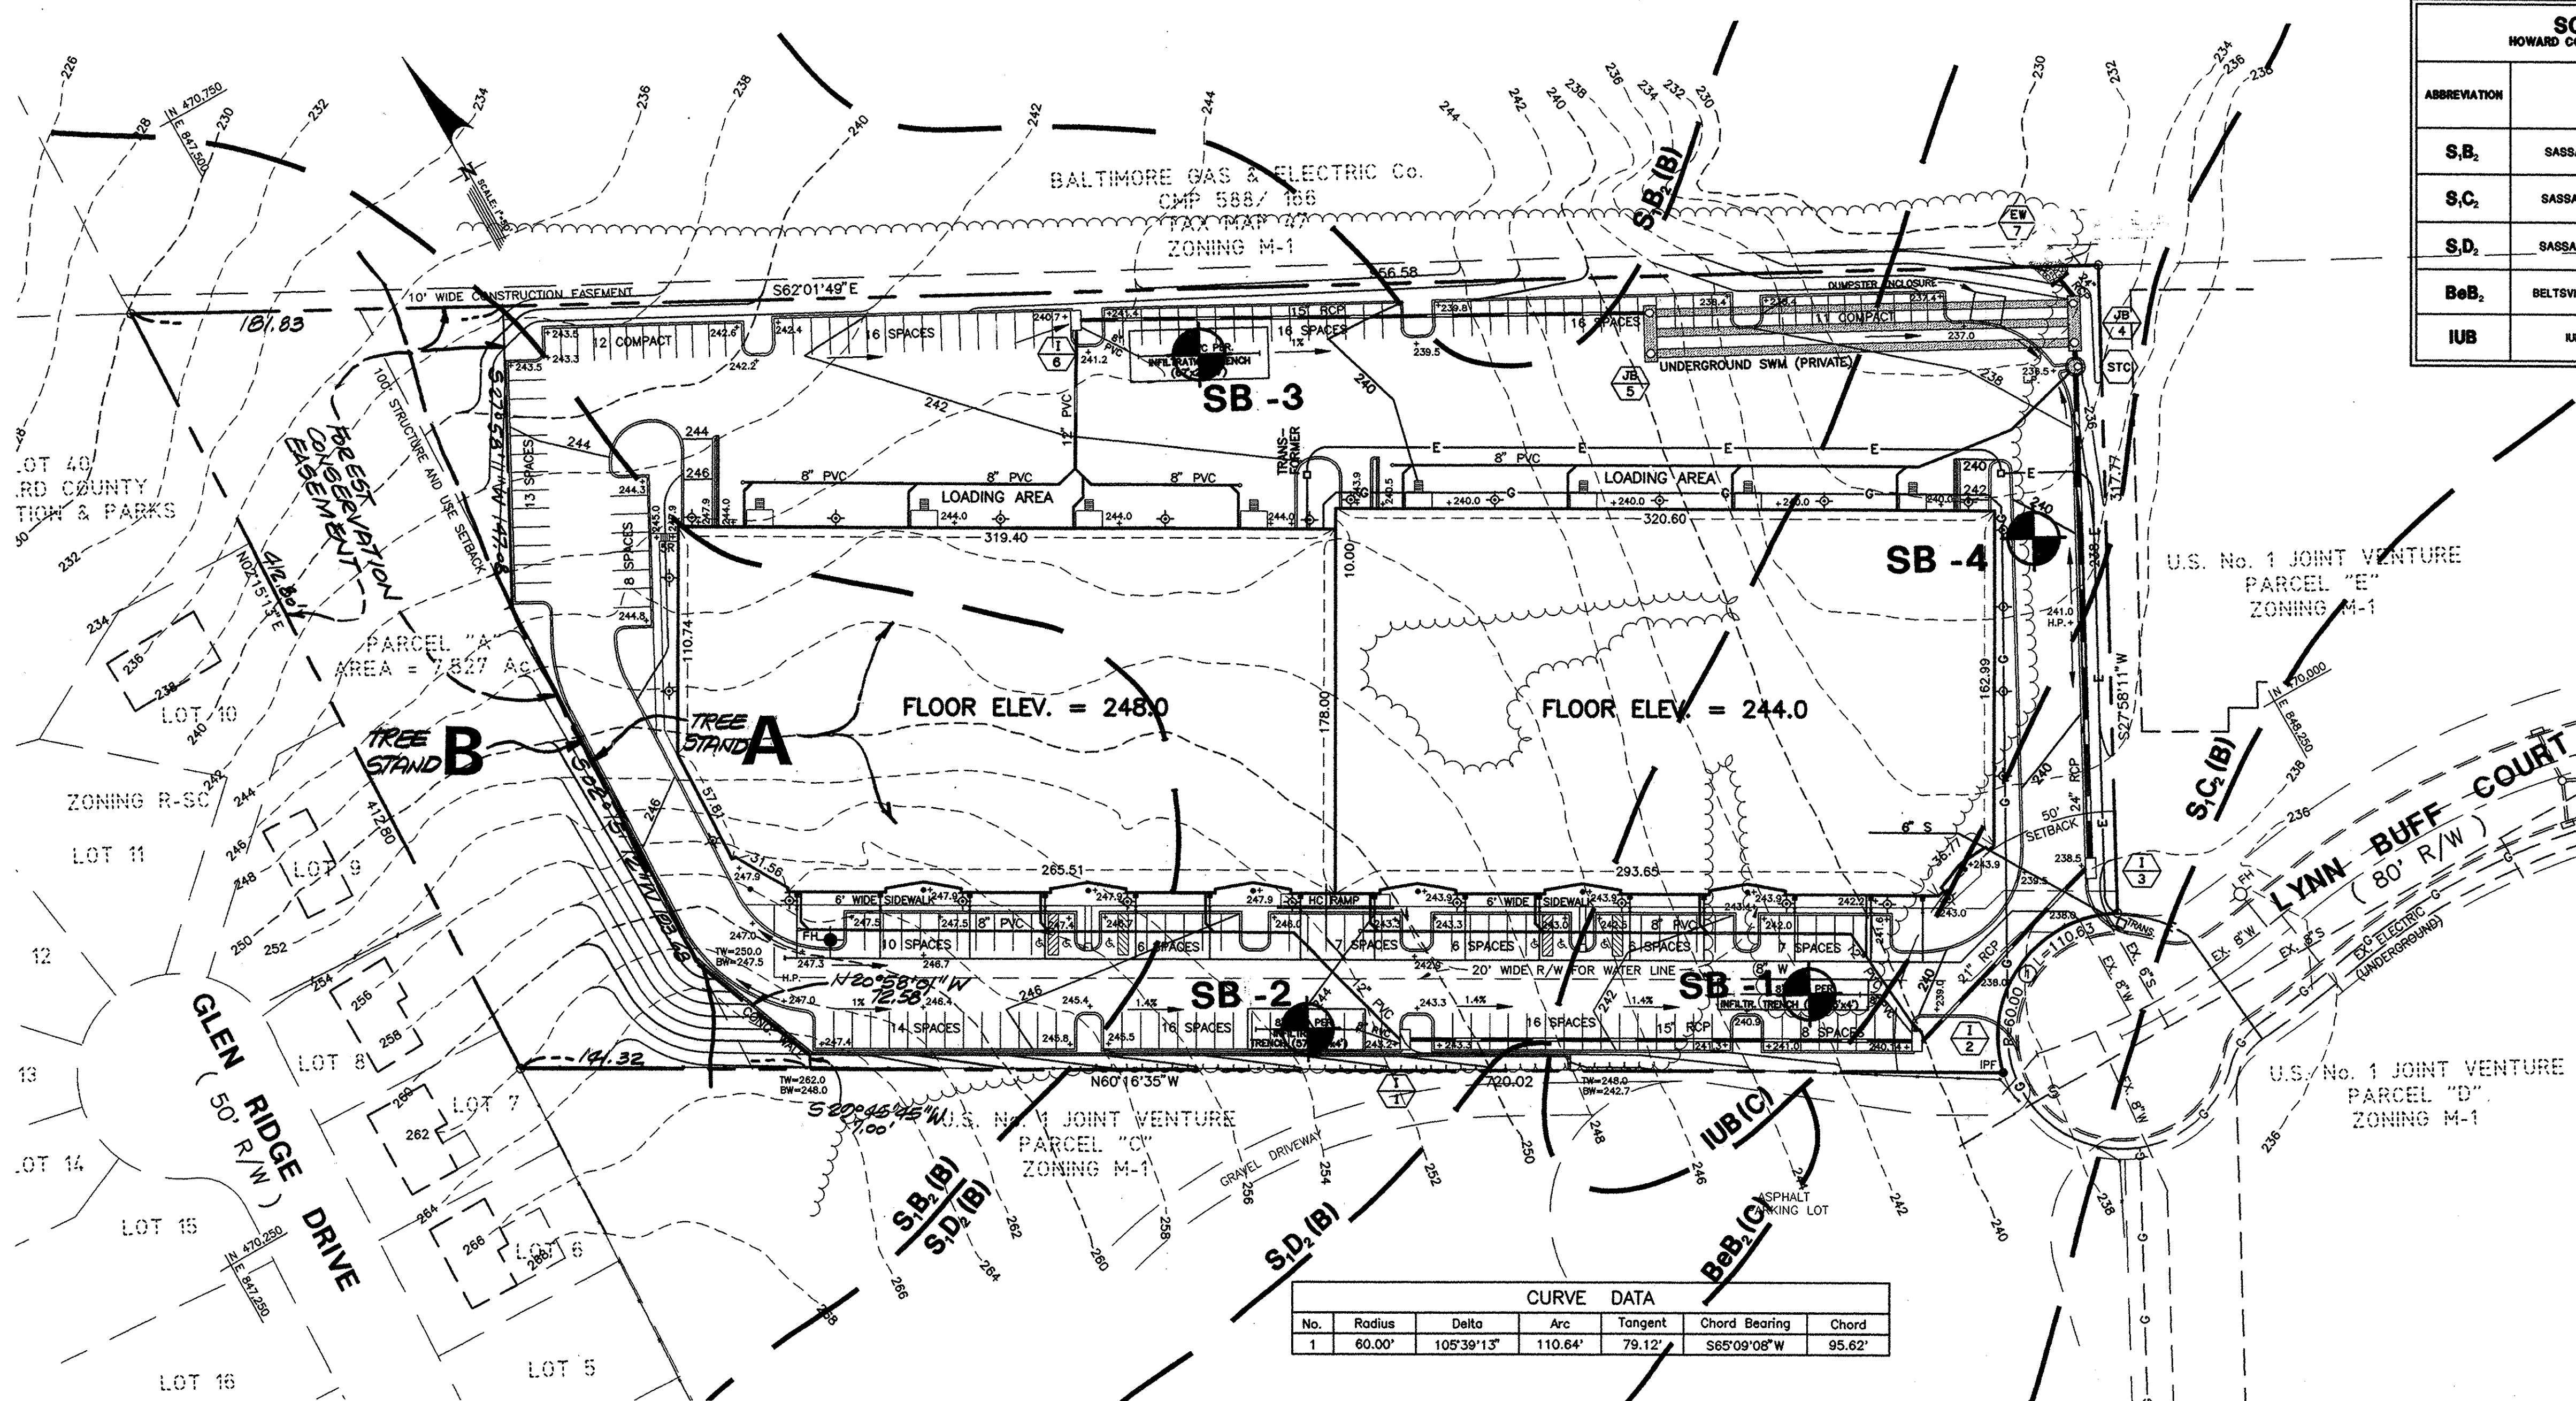

SOIL TYPES		
HOWARD COUNTY SOILS MAP No. 34		
ABBREVIATION	NAME	SCD SOIL CLASSIFICATION
S <sub>B</sub>	SASSAFRAS LOAM 1-5%	B
S <sub>C</sub>	SASSAFRAS LOAM 5-10%	B
S <sub>D</sub>	SASSAFRAS LOAM 10-15%	B
B <sub>e</sub> S <sub>2</sub>	BELTSVILLE SILT LOAM 1-5%	C
IUB	IRKA LOAM 1-5%	C

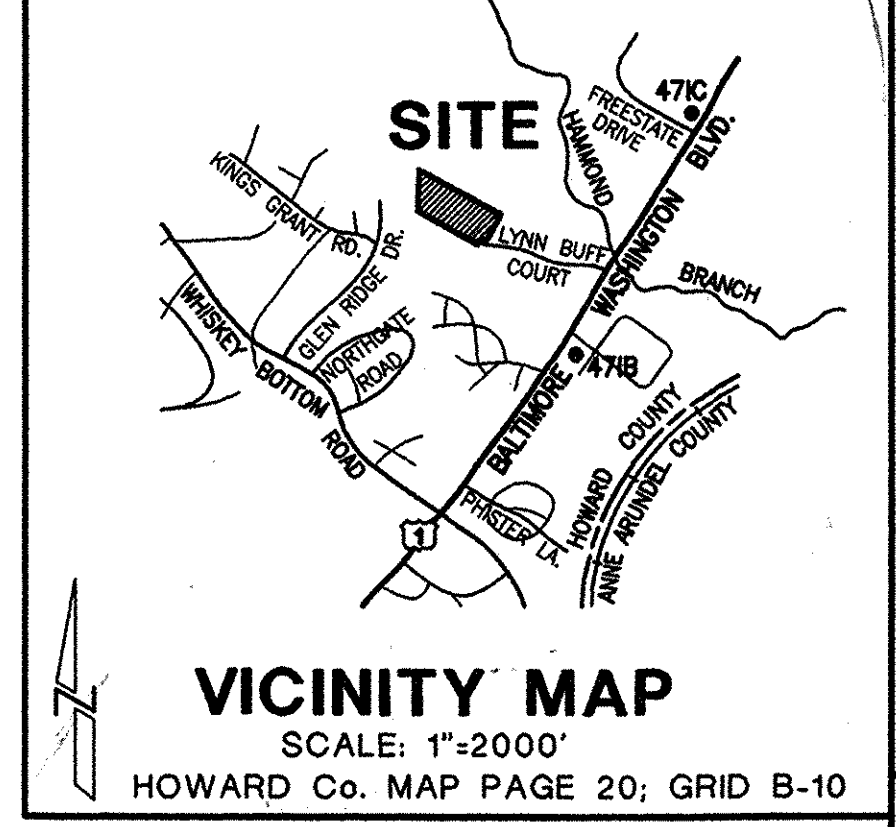

SITE LOCATION

METHODOLOGY

STAND CONDITION

Stand A

Stand B

APPROVED: HOWARD COUNTY DEPARTMENT OF PLANNING AND ZONING

10/6/98

10/5/98

10/1/98

AS BUILT CERTIFICATE

FRED L. SKELTON - MD. REGISTRATION No. 9070

DATE

OWNER / DEVELOPER

Joseph Nazario

Nazario Development and Company

6500 Amundale Road

Beltsville, Maryland 20705

(301) 937-4664

May 6, 1998

Howard County, Maryland

Soil Conservation District

9025 Chevrolet Drive

Suite 1

Ellicott City, Maryland 21042

RE: NAZARIO - LYNN BUFF COURT

US #1 Joint Venture

SDP# 98-88

This is to certify that the investigation was conducted on the above referenced project regarding wetlands. Based on criteria for delineation of wetlands contained in the Federal Manual for Identifying and Delineation Jurisdictional Wetland none of the areas could be considered wetlands.

Wetlands, however, could be found off-site on the B & E right of way. This development is not expected to impact these areas adversely.

10/1/98

Stephen W. Teichler

Reg. #230



ARCHITECTURAL & URBAN DESIGN • LANDSCAPE ARCHITECTURE • SITE PLANNING & ENGINEERING • COMPREHENSIVE PLANNING

COMMUNITY & NEW TOWN PLANNING • URBAN / RURAL RENOVATION • SOCIO-ECONOMIC ANALYSIS • LAND SURVEYING

MAFI ASSOCIATES, INC.

RECORD OF SOIL EXPLORATION

Sample #	SOIL DESCRIPTION	DEPTH	COOR	SCALE	LEGEND
1-1	Wet, clayey sandy silt with trace of organic (S <sub>1</sub> )	0'-2'	24.0	HAB	.....
2-1	Moist, light brown, fine clayey sandy silt (S <sub>1</sub> )	2'-2'	24.0	HAB	.....
3-1	Same as S <sub>1</sub> , moisture content - 20.8%	3'-2'	24.0	HAB	.....
4-1	Light yellowish brown silty sand, trace of gravel, moist, medium dense, moisture content 21.4%, "S <sub>1</sub> "	4'-2'	24.0	HAB	.....
5-1	Same as S <sub>1</sub> , moisture content - 20.8%	5'-2'	24.0	HAB	.....

MAFI ASSOCIATES, INC.

RECORD OF SOIL EXPLORATION

Sample #	SOIL DESCRIPTION	DEPTH	COOR	SCALE	LEGEND
1-1	Moist, light brown fine silty sand, presence of roots (S <sub>1</sub> ) moisture content - 17.2%	0'-2'	24.0	HAB	.....
2-1	Same as S <sub>1</sub> , moisture content - 17.2%	2'-2'	24.0	HAB	.....
3-1	Moist, light brown coarse grained sand, trace of clay (S <sub>1</sub> ) moisture content - 17.4%	3'-2'	24.0	HAB	.....
4-1	Same as S <sub>1</sub> , moisture content - 15.2%	4'-2'	24.0	HAB	.....
5-1	Same as S <sub>1</sub> , moisture content - 12.4%	5'-2'	24.0	HAB	.....

MAFI ASSOCIATES, INC.

RECORD OF SOIL EXPLORATION

Sample #	SOIL DESCRIPTION	DEPTH	COOR	SCALE	LEGEND
1-1	Moist, light brown silty sand (S <sub>1</sub> )	0'-2'	24.0	HAB	.....
2-1	Same as S <sub>1</sub> , moisture content - 15.7%	2'-2'	24.0	HAB	.....
3-1	Light grayish brown silty sand with trace of clay (S <sub>1</sub> ) moisture content - 15.5%	3'-2'	24.0	HAB	.....
4-1	Moist, fine light gray sandy silt (S <sub>1</sub> )	4'-2'	24.0	HAB	.....
5-1	Moist, pink coarse grained sand, trace of clay (S <sub>1</sub> )	5'-2'	24.0	HAB	.....

MAFI ASSOCIATES, INC.

RECORD OF SOIL EXPLORATION

Sample #	SOIL DESCRIPTION	DEPTH	COOR	SCALE	LEGEND
1-1	Moist, grayish brown sandy silt with some gravel and trace of clay, some roots observed (S <sub>1</sub> )	0'-2'	24.0	HAB	.....
2-1	Moist, yellowish brown silty sand with sand (S <sub>1</sub> )	2'-2'	24.0	HAB	.....
3-1	Moist, yellowish brown silty sand with sand (S <sub>1</sub> )	3'-2'	24.0	HAB	.....
4-1	Moist, pink coarse grained sand, trace of clay (S <sub>1</sub> )	4'-2'	24.0	HAB	.....
5-1	Moist, light yellowish brown coarse grained sand (S <sub>1</sub> )	5'-2'	24.0	HAB	.....

802 Sligo Avenue  
Silver Spring, Maryland 20910  
(301) 585-5676

IPDS

The Interprofessional  
PLANNING & DESIGN STUDIO, LLC  
Engineers • Architects • Surveyors  
Planners & Landscape Architects

SOILS AND ENVIRONMENTAL ANALYSIS

U.S. No. 1 JOINT VENTURE

PARCEL "A", PLAT CMP No. 3592, WAREHOUSE

GUILFORD ELECTION DISTRICT No. 6

HOWARD COUNTY, MARYLAND

CENSUS TRACT 6089.02, TAX MAP 47, BLOCK 22/23

WATER CODE C04, SEWER CODE 7220000





CERTIFICATE

I hereby certify that to the best of my knowledge that this "As-Built" truly represents existing field conditions including, but not limited to sizes, diameters, line and grade, and elevations.


*Fred L. Skelton* (SEAL)  
Fred L. Skelton, P.E.  
MD Reg. No. 9070

03-14-01

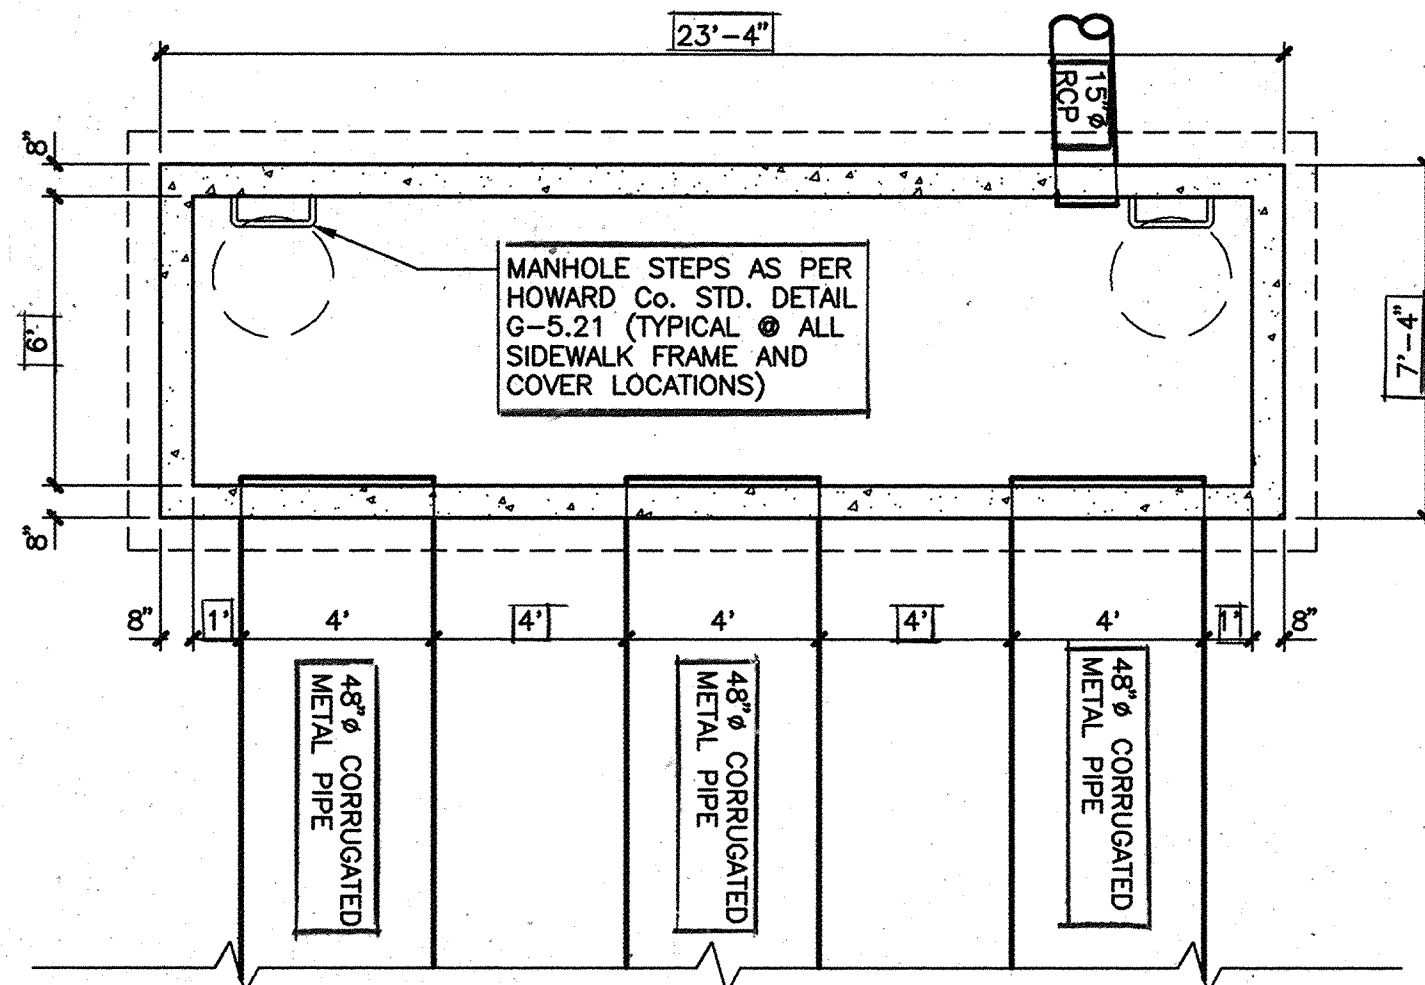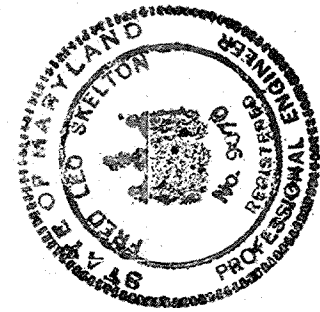

**JUNCTION BOX No. 5 - PLAN VIEW**

SCALE: 1/4"=1'-0"

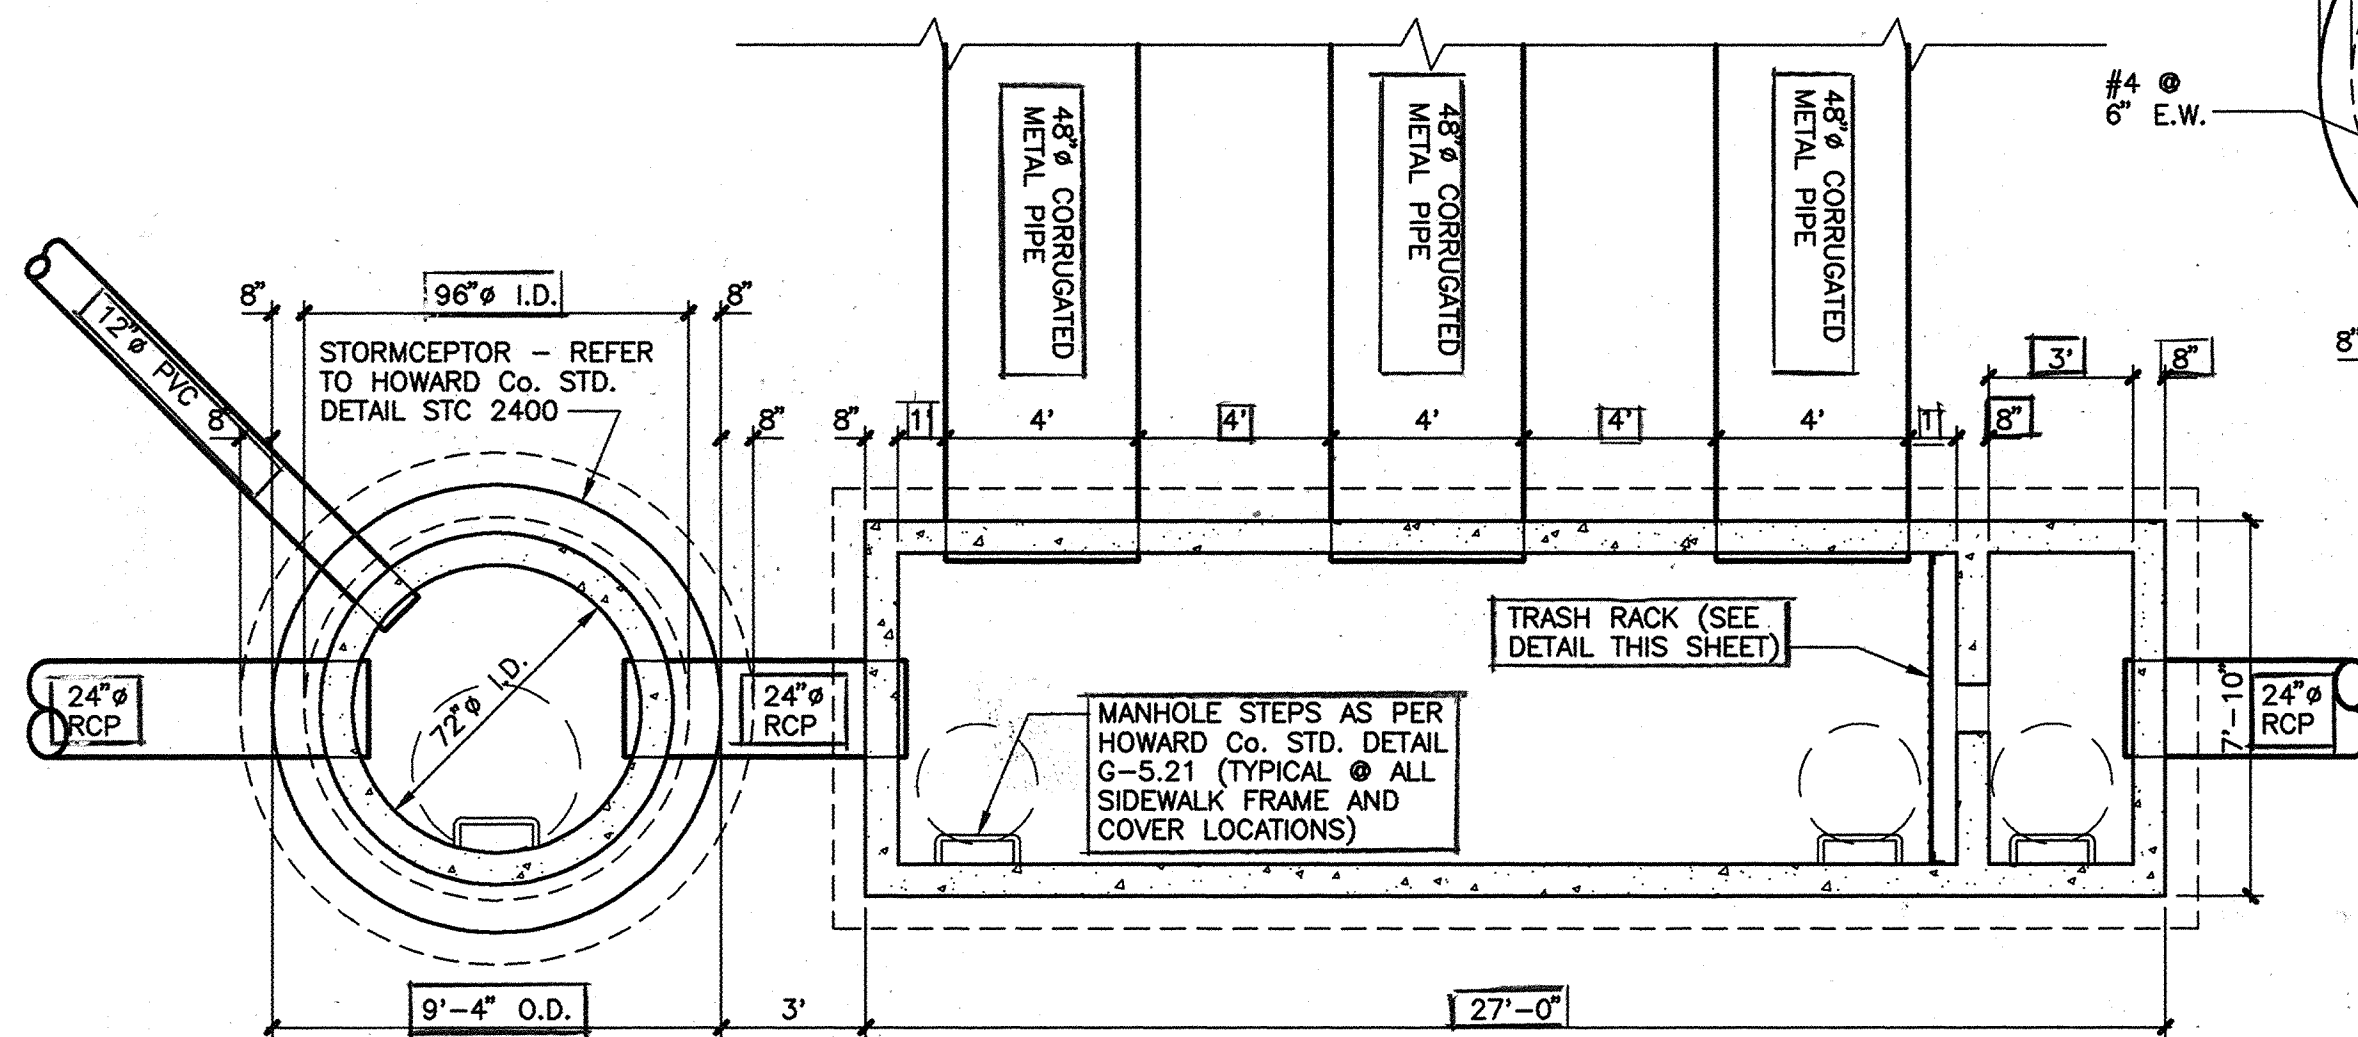


**JUNCTION BOX No. 4 - PLAN VIEW**

SCALE: 1/4"=1'-0"


**GENERAL NOTES:**

1. CONCRETE STRENGTH SHALL BE  $f_c' = 5000$  PSI @ 28 DAYS.
2. ALL REINFORCING STEEL TO BE ASTM A615 GRADE 60.
3. PROVIDE MINIMUM 3" CONCRETE COVER ON ALL BELOW GRADE REINFORCING STEEL, UNLESS OTHERWISE SPECIFIED. PROVIDE MINIMUM 2" CONCRETE COVER ON ALL ABOVE GRADE REINFORCING STEEL, UNLESS OTHERWISE SPECIFIED.
4. FOR INFORMATION NOT SHOWN REFER TO DER STD. DTL. SD/10.0 AND SD/10.1.
5. ALL LAP REINFORCEMENT TO BE 32 TIMES REBAR DIAMETER (MIN.).
6. FOR PRECAST STRUCTURE SUBMIT SHOP DRAWINGS TO PERMITS AND REVIEW DIVISION FOR APPROVAL.
7. PROVIDE WATERTIGHT JOINTS AT ALL WALL PENETRATIONS.

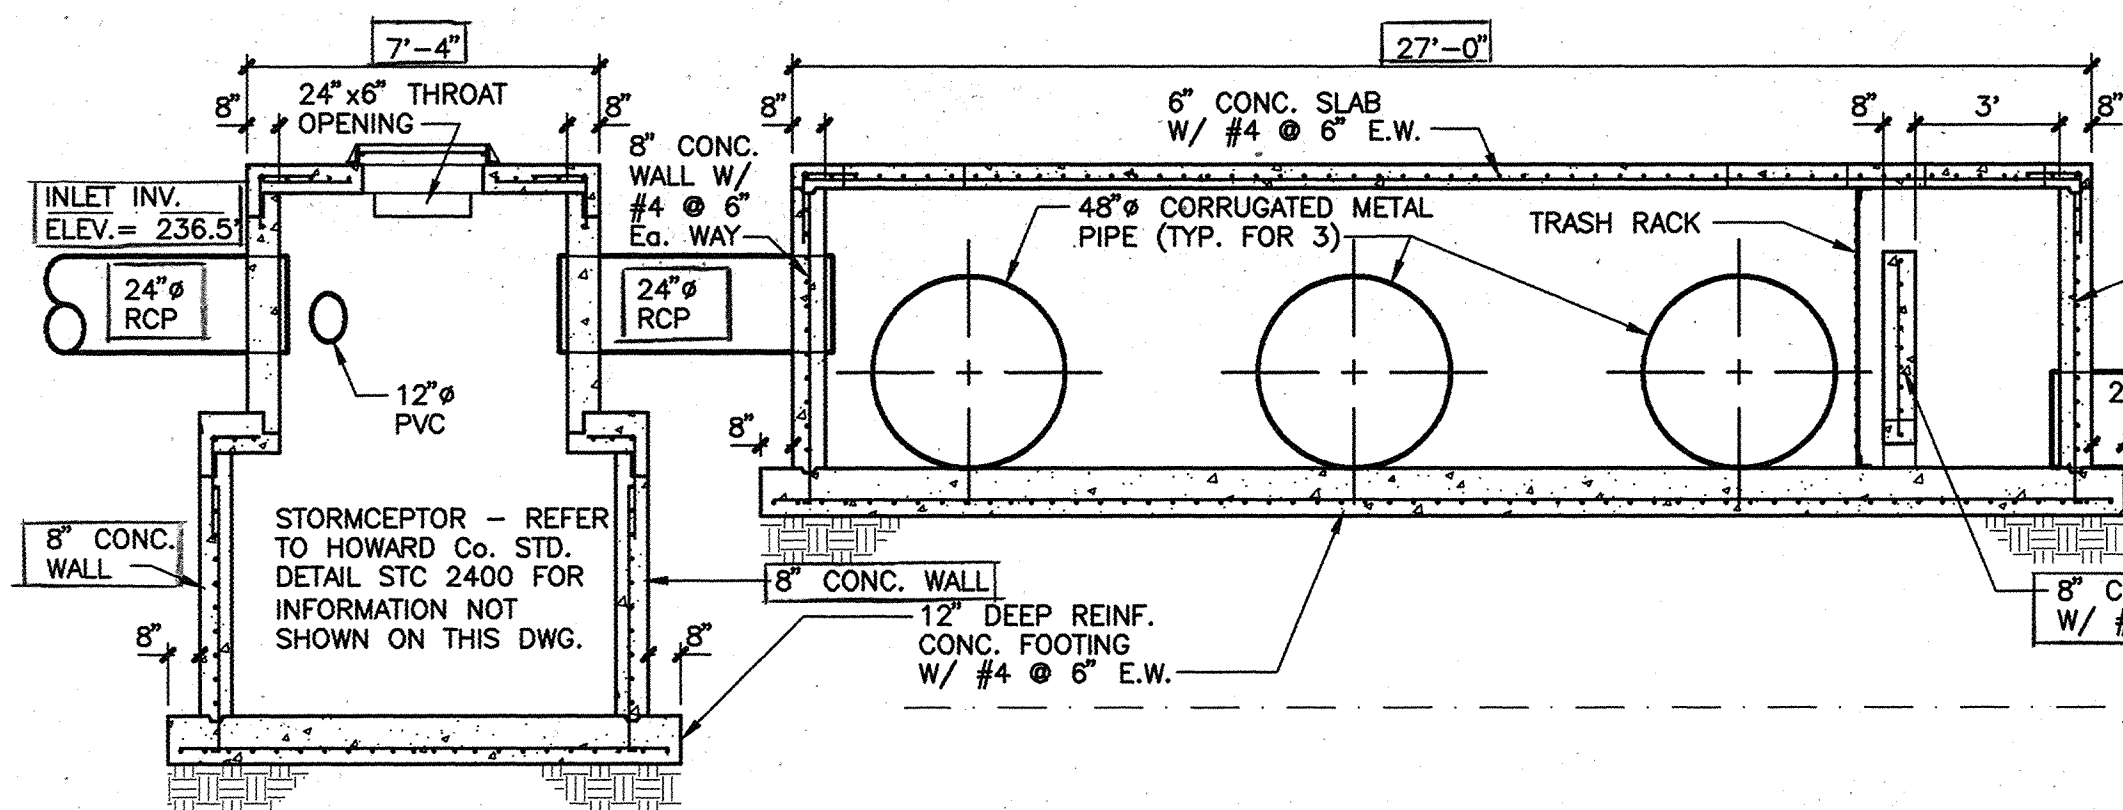


**JUNCTION BOX No. 4 - LONGITUDINAL SECTION**

SCALE: 1/4"=1'-0"

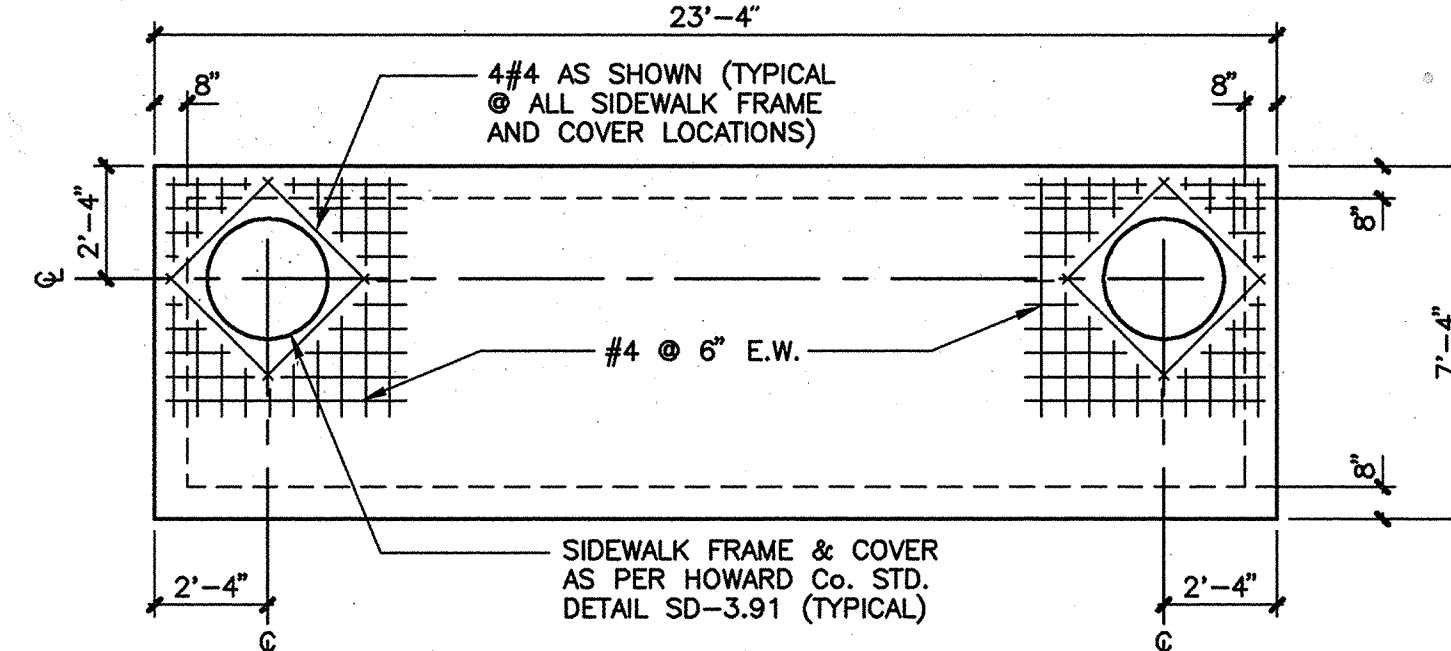

**JUNCTION BOX No. 5 - TOP SLAB DETAIL**

SCALE: 1/4"=1'-0"

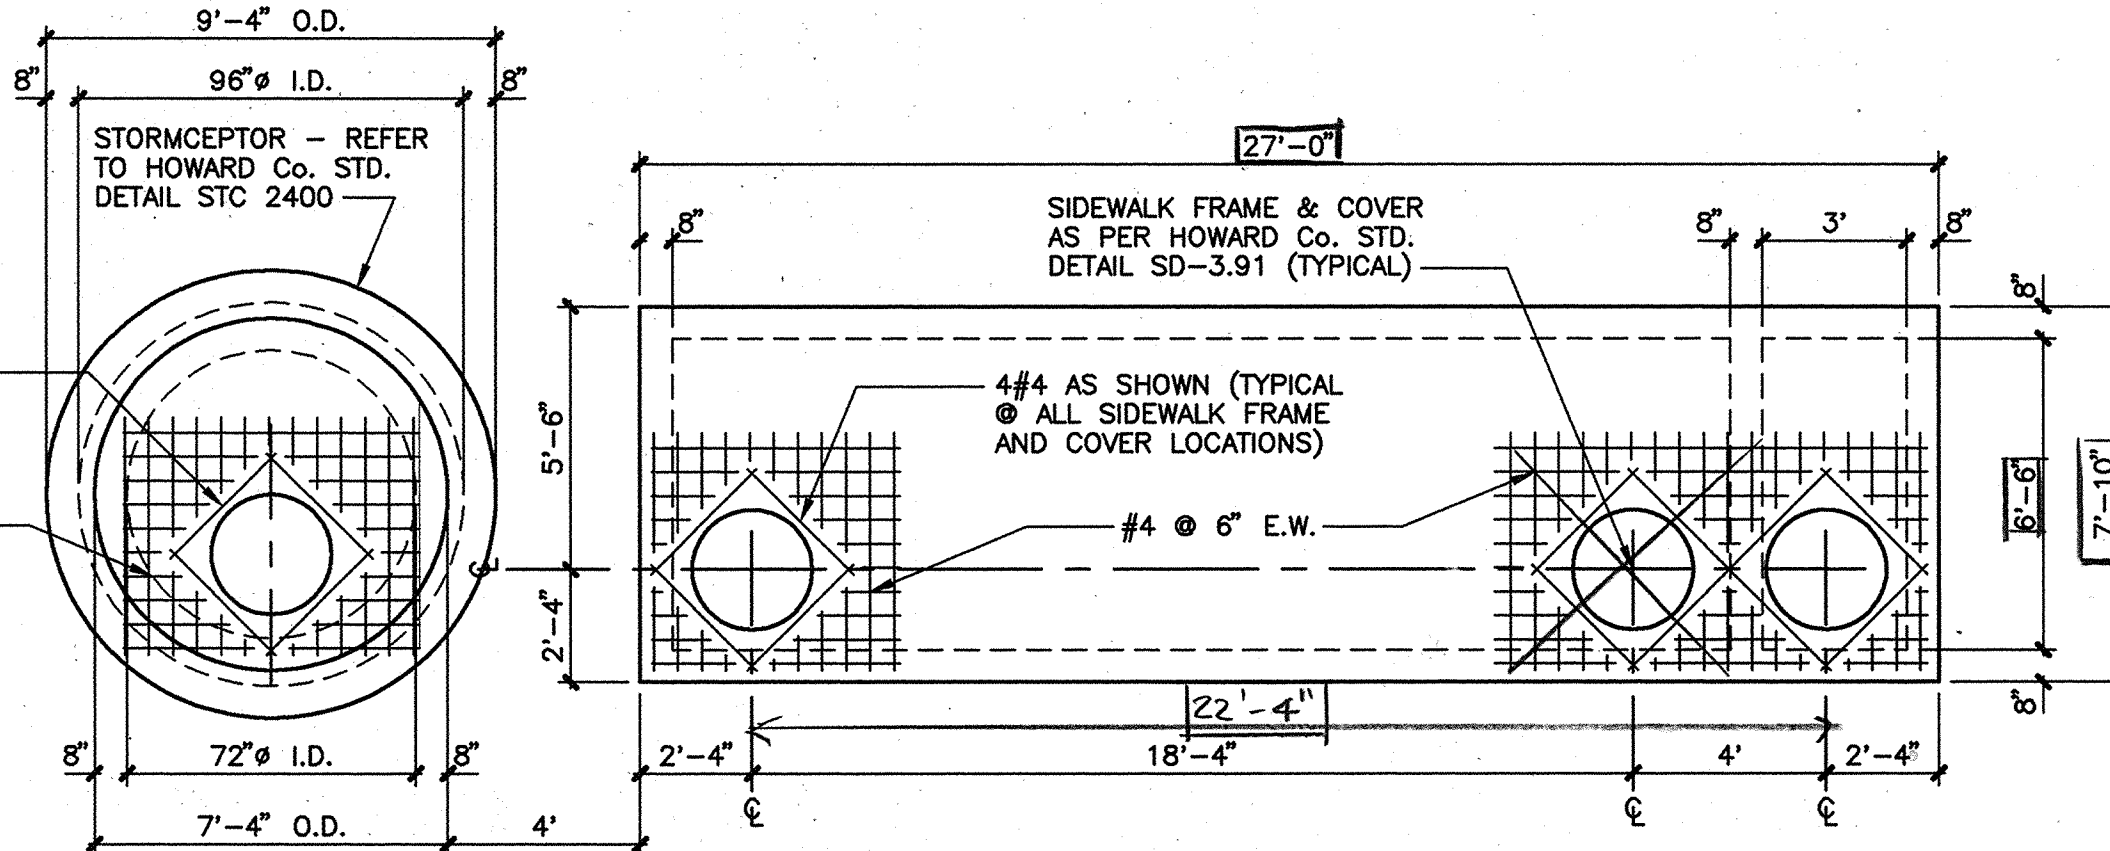

**JUNCTION BOX No. 4 - TOP SLAB DETAIL**

SCALE: 1/4"=1'-0"


**UNDERGROUND PIPE STORAGE (PRIVATE)**

**SPECIFICATIONS FOR CONSTRUCTION**

1. CONTRACTOR SHALL SUBMIT SHOP DRAWINGS TO ENGINEER AND HOWARD COUNTY FOR APPROVAL PRIOR TO COMMENCING WORK.
2. ALL WORK SHALL BE PLACED ON UNDISTURBED SUBGRADE. ANY OVER-EXCAVATION SHALL BE BACKFILLED WITH CR-6 CRUSHED RUN AND COMPACTED TO 95% ASHTO UNDER DIRECTION OF ENGINEER. NO CONSTRUCTION SHALL BE PLACED ON WET OR FROZEN GROUND.
3. ALL WELDING SHALL BE DONE BY MANUFACTURER'S WELDER. WELDS SHALL BE WATERPROOFED PRIOR TO BACKFILLING AND FINAL INSPECTION.
4. ALL STEEL USED FOR STORAGE STRUCTURE SHALL BE CORRUGATED STEEL ALUMINIZED PIPE, 12 GAUGE.
5. THE CONTRACTOR SHALL GUARANTEE TOTAL RUST-PROOFING OF THE STEEL PIPE.
6. PIPES SHALL BE BEDDED IN 12" OF SAND.
7. MINIMUM COVER SHALL BE 18".


**NOTES**

1. REFER TO ARMCO, INC. METAL PRODUCTS DIVISION (OR EQUAL AND APPROVED) FOR LOCATIONS OF WELDED CONNECTIONS.
2. SHOP DRAWINGS TO BE SUBMITTED TO HOWARD COUNTY AND THE ENGINEER PRIOR TO CONSTRUCTION.

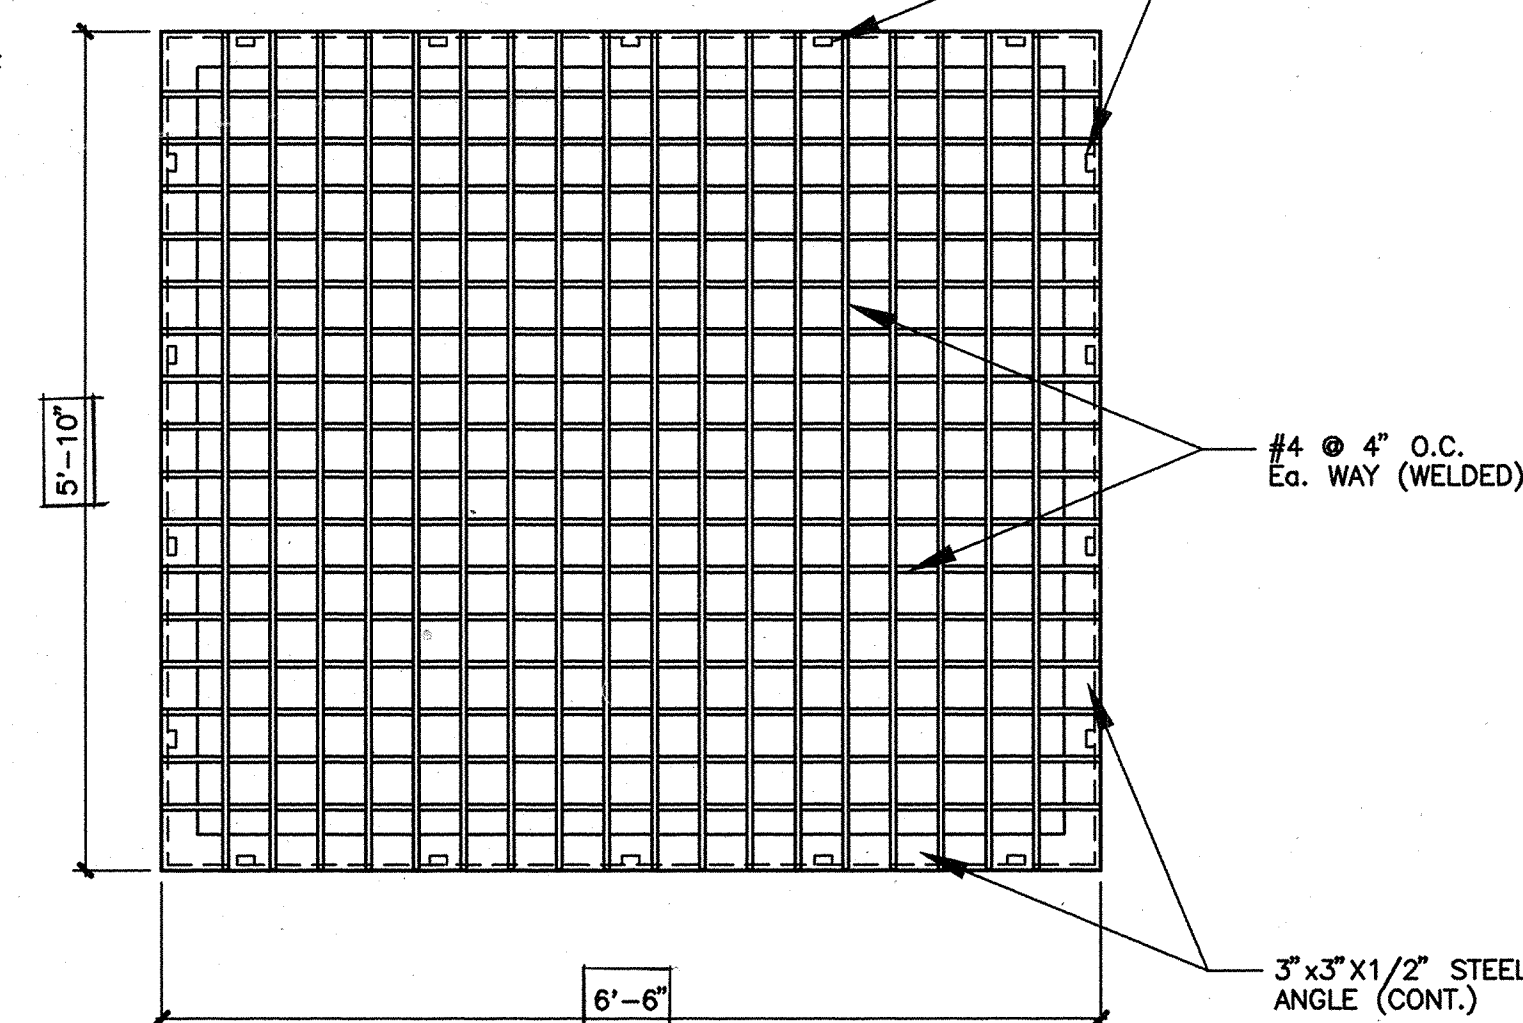


**ELEVATION - TRASH RACK**

SCALE: 3/4"=1'-0"

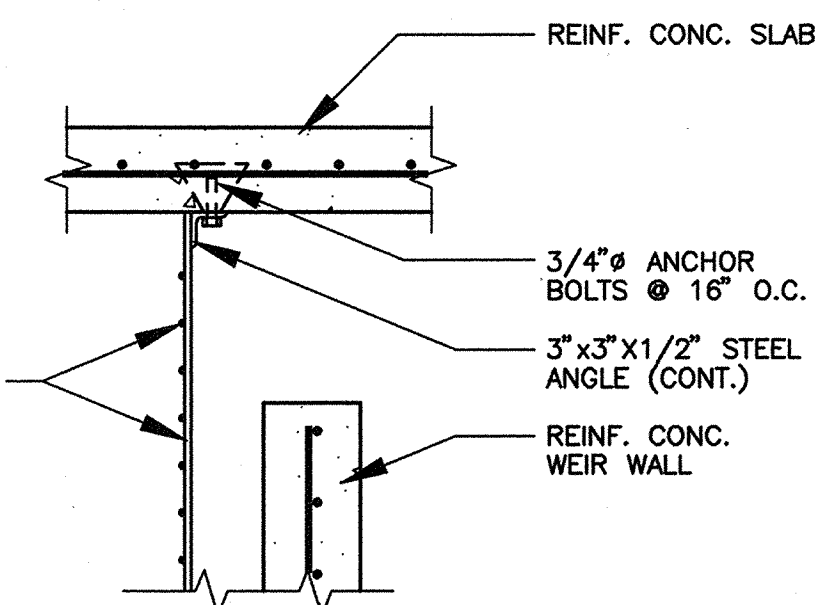

**DETAIL - TRASH RACK**

SCALE: 3/4"=1'-0"

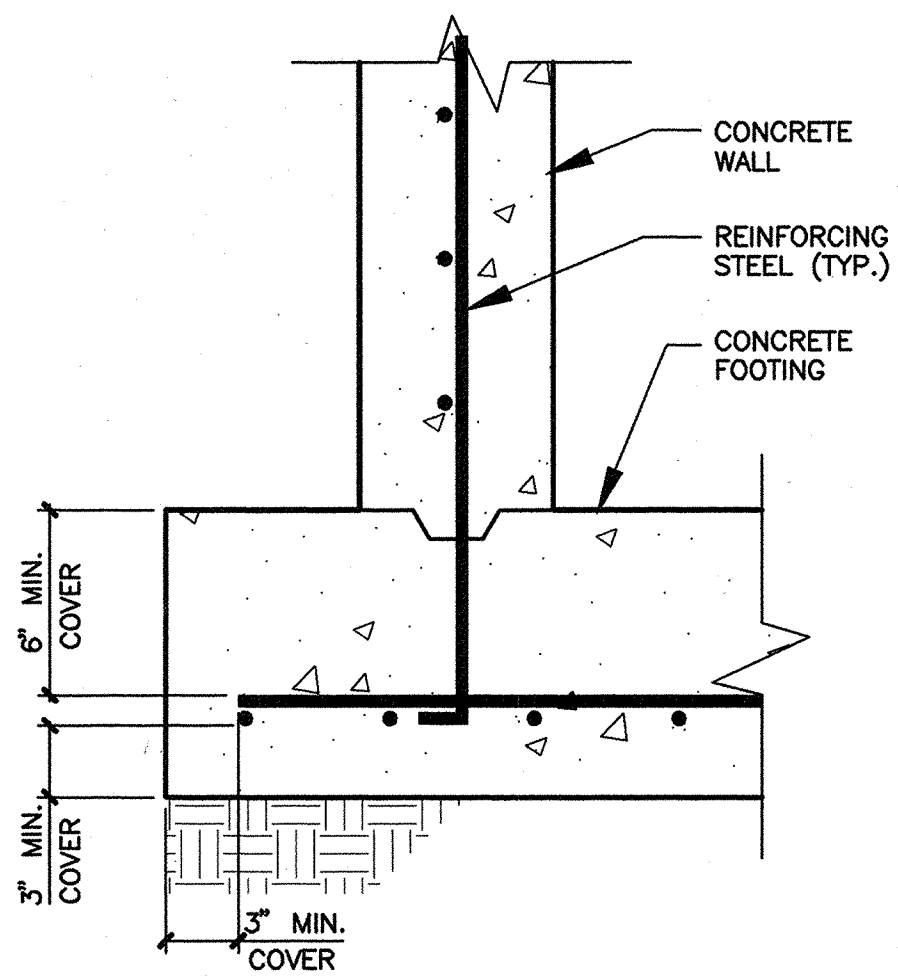

**TYPICAL FOOTING DETAIL**

NO SCALE

BY THE DEVELOPER:

I/WE CERTIFY THAT ALL DEVELOPMENT AND/OR CONSTRUCTION WILL BE DONE IN ACCORDANCE WITH THESE PLANS AND THAT ANY RESPONSIBLE PERSONNEL INVOLVED IN THE CONSTRUCTION PROJECT WILL HAVE A CERTIFICATE OF ATTENDANCE AT A DEPARTMENT OF THE ENVIRONMENT APPROVED TRAINING PROGRAM FOR THE CONTROL OF SEDIMENT AND EROSION BEFORE BEGINNING THE PROJECT. I/WE WILL PROVIDE THE HOWARD SOIL CONSERVATION DISTRICT WITH AN "AS-BUILT" PLAN OF THE PROJECT WITHIN 30 DAYS OF COMPLETION. I/WE ALSO AUTHORIZE PERIODIC ON-SITE INSPECTIONS BY THE HOWARD SOIL CONSERVATION DISTRICT.

*Joseph Nazario*  
JOSEPH NAZARIO  
NAZARIO DEVELOPMENT AND COMPANY

5-1-98  
DATE

BY THE ENGINEER:

I/WE CERTIFY THAT THIS PLAN FOR POND CONSTRUCTION, SOIL EROSION AND SEDIMENT CONTROL REPRESENTS A PRACTICAL AND WORKABLE PLAN BASED ON MY PERSONAL KNOWLEDGE OF THE SITE CONDITIONS. THIS PLAN WAS PREPARED IN ACCORDANCE WITH THE REQUIREMENTS OF THE HOWARD SOIL CONSERVATION DISTRICT. I HAVE ADVISED THE DEVELOPER THAT HE MUST PROVIDE THE HOWARD SOIL CONSERVATION DISTRICT WITH AN "AS-BUILT" PLAN OF THE PROJECT WITHIN 30 DAYS OF COMPLETION.

*Fred L. Skelton*  
FRED L. SKELTON - MD. REGISTRATION No. 9070  
IPDS, LLC

6/6/98  
DATE

THESE PLANS HAVE BEEN REVIEWED FOR THE HOWARD SOIL CONSERVATION DISTRICT AND MEET THE TECHNICAL REQUIREMENTS FOR SOIL EROSION AND SEDIMENT CONTROL.

*Paul Simmons*  
U.S. SOIL CONSERVATION SERVICE  
DATE: 9/30/98

THESE PLANS FOR SOIL EROSION AND SEDIMENT CONTROL MEET THE REQUIREMENTS OF THE HOWARD SOIL CONSERVATION DISTRICT.

*John R. Peterson*  
HOWARD SOIL CONSERVATION DISTRICT  
DATE: 9/30/98

APPROVED: HOWARD COUNTY DEPARTMENT OF PLANNING AND ZONING

*David Smith*  
DIRECTOR  
DATE: 11/6/98

*Cindy Hamilton*  
CHIEF, DIVISION OF LAND DEVELOPMENT  
DATE: 10/5/98

*Mike Dammann*  
CHIEF, DEVELOPMENT ENGINEERING DIVISION  
DATE: 10/1/99

APPROVED: FOR PUBLIC WATER AND PUBLIC SEWERAGE, STORM DRAINAGE SYSTEMS AND PUBLIC ROADS.

*NA*  
DIRECTOR  
DATE:   
CHIEF, BUREAU OF ENGINEERING  
DATE:



AS BUILT CERTIFICATE

*Fred L. Skelton*  
FRED L. SKELTON - MD. REGISTRATION No. 9070  
IPDS, LLC

03-14-01  
DATE

**OWNER \ DEVELOPER**

Joseph Nazario  
Nazario Development and Company  
6500 Ammendale Road  
Beltsville, Maryland 20705  
(301) 937-4664

802 Silgo Avenue  
Silver Spring,  
Maryland, 20910  
(301) 585-5676  
IPDS  
The Interprofessional  
PLANNING & DESIGN STUDIO, LLC  
Engineers • Architects • Surveyors  
Planners & Landscape Architects

**STORMWATER MANAGEMENT  
DETAILS**

U.S. No. 1 JOINT VENTURE  
PARCEL "A", PLAT CMP No. 3592, WAREHOUSE  
GUILFORD ELECTION DISTRICT No. 6  
HOWARD COUNTY, MARYLAND  
CENSUS TRACT 8088.02, TAX MAP 47, BLOCK 22/23  
WATER CODE C04, SEWER CODE 7220000

**AS NOTED**

SCALE:

06-18-98

REVISIONS:

01-18-98

DATE:

JOB NUMBER:




CERTIFICATE

I hereby certify that to the best of my knowledge that this "As-Built" truly represents existing field conditions including, but not limited to sizes, diameters, line and grade, and elevations.


*Fred L. Skelton* (SEAL)  
Fred L. Skelton, P.E.  
MD Reg. No. 9070

03-14-01

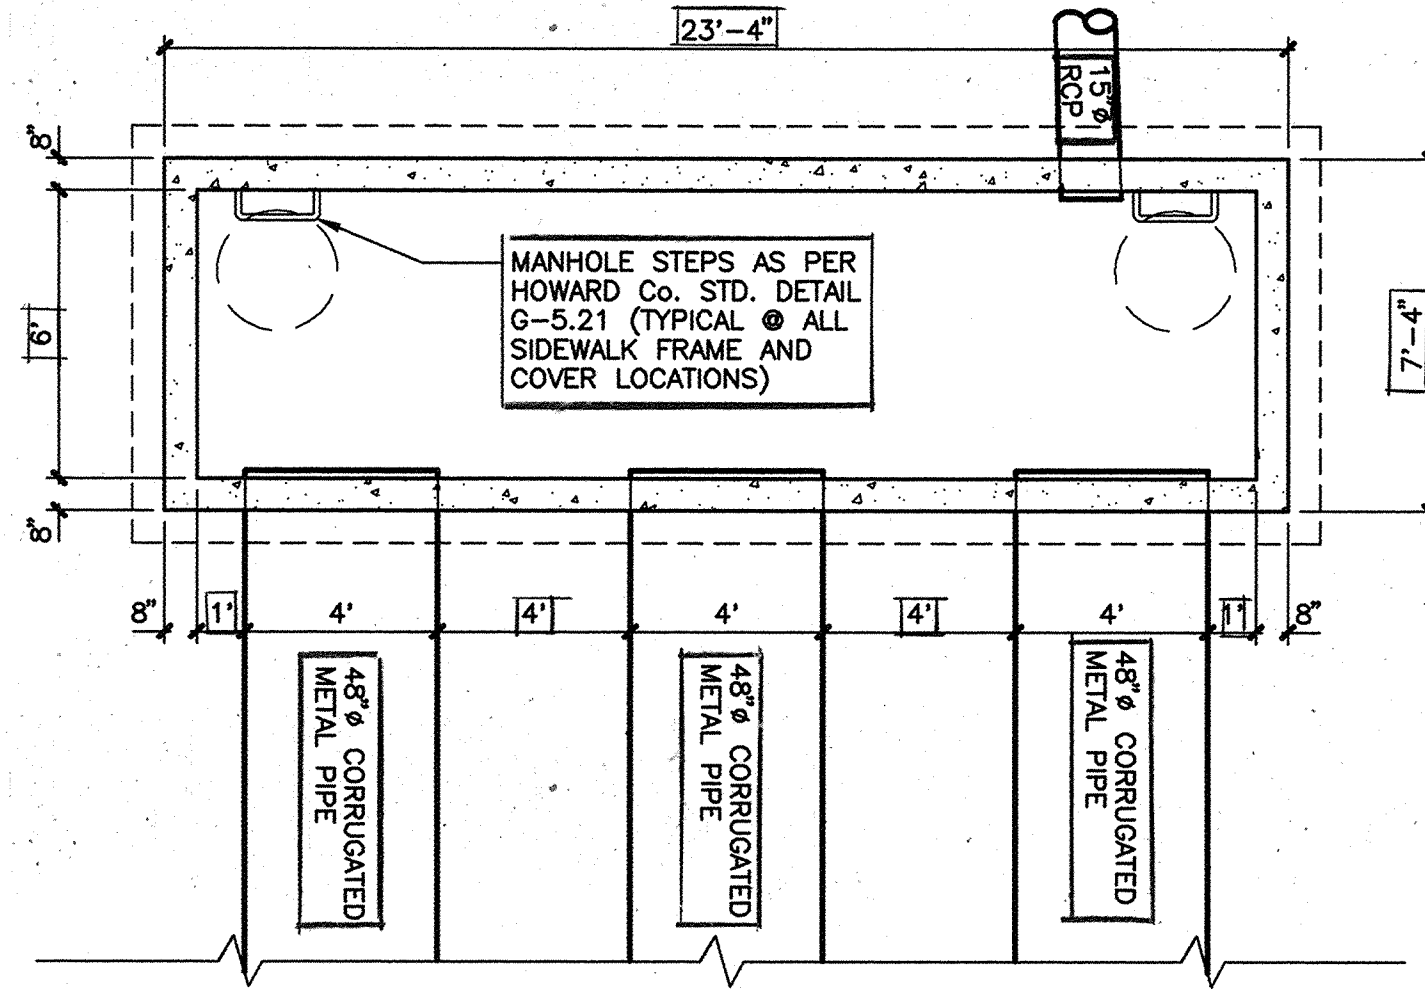

**JUNCTION BOX No. 5 - PLAN VIEW**

SCALE: 1/4"=1'-0"

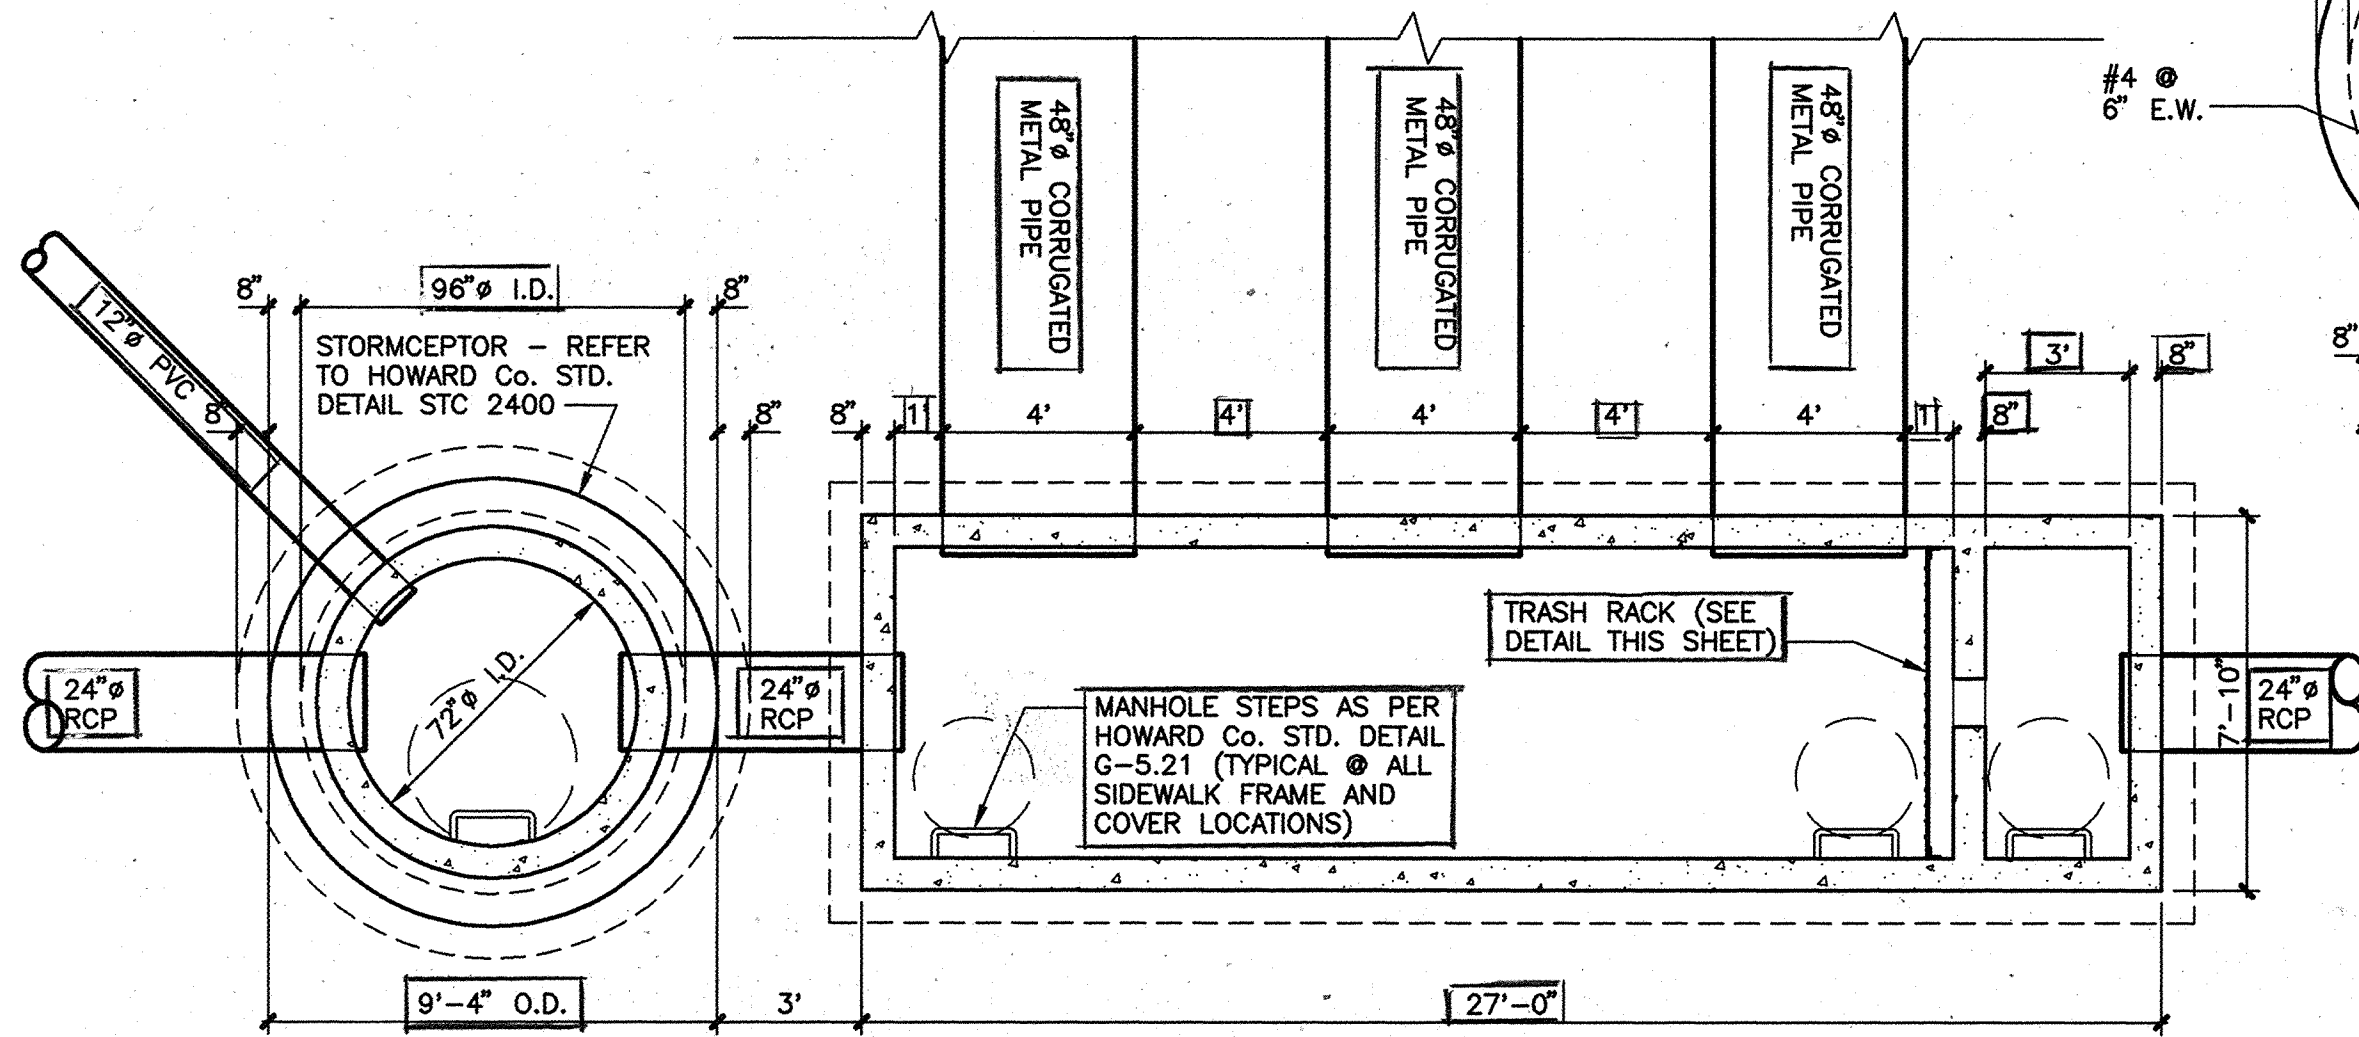


**JUNCTION BOX No. 4 - PLAN VIEW**

SCALE: 1/4"=1'-0"


**GENERAL NOTES:**

1. CONCRETE STRENGTH SHALL BE  $f_c' = 5000$  PSI @ 28 DAYS.
2. ALL REINFORCING STEEL TO BE ASTM A615 GRADE 60.
3. PROVIDE MINIMUM 3" CONCRETE COVER ON ALL BELOW GRADE REINFORCING STEEL, UNLESS OTHERWISE SPECIFIED. PROVIDE MINIMUM 2" CONCRETE COVER ON ALL ABOVE GRADE REINFORCING STEEL, UNLESS OTHERWISE SPECIFIED.
4. FOR INFORMATION NOT SHOWN REFER TO DER STD. DTL. SD/10.0 AND SD/10.1.
5. ALL LAP REINFORCEMENT TO BE 32 TIMES REBAR DIAMETER (MIN.).
6. FOR PRECAST STRUCTURE SUBMIT SHOP DRAWINGS TO PERMITS AND REVIEW DIVISION FOR APPROVAL.
7. PROVIDE WATERTIGHT JOINTS AT ALL WALL PENETRATIONS.

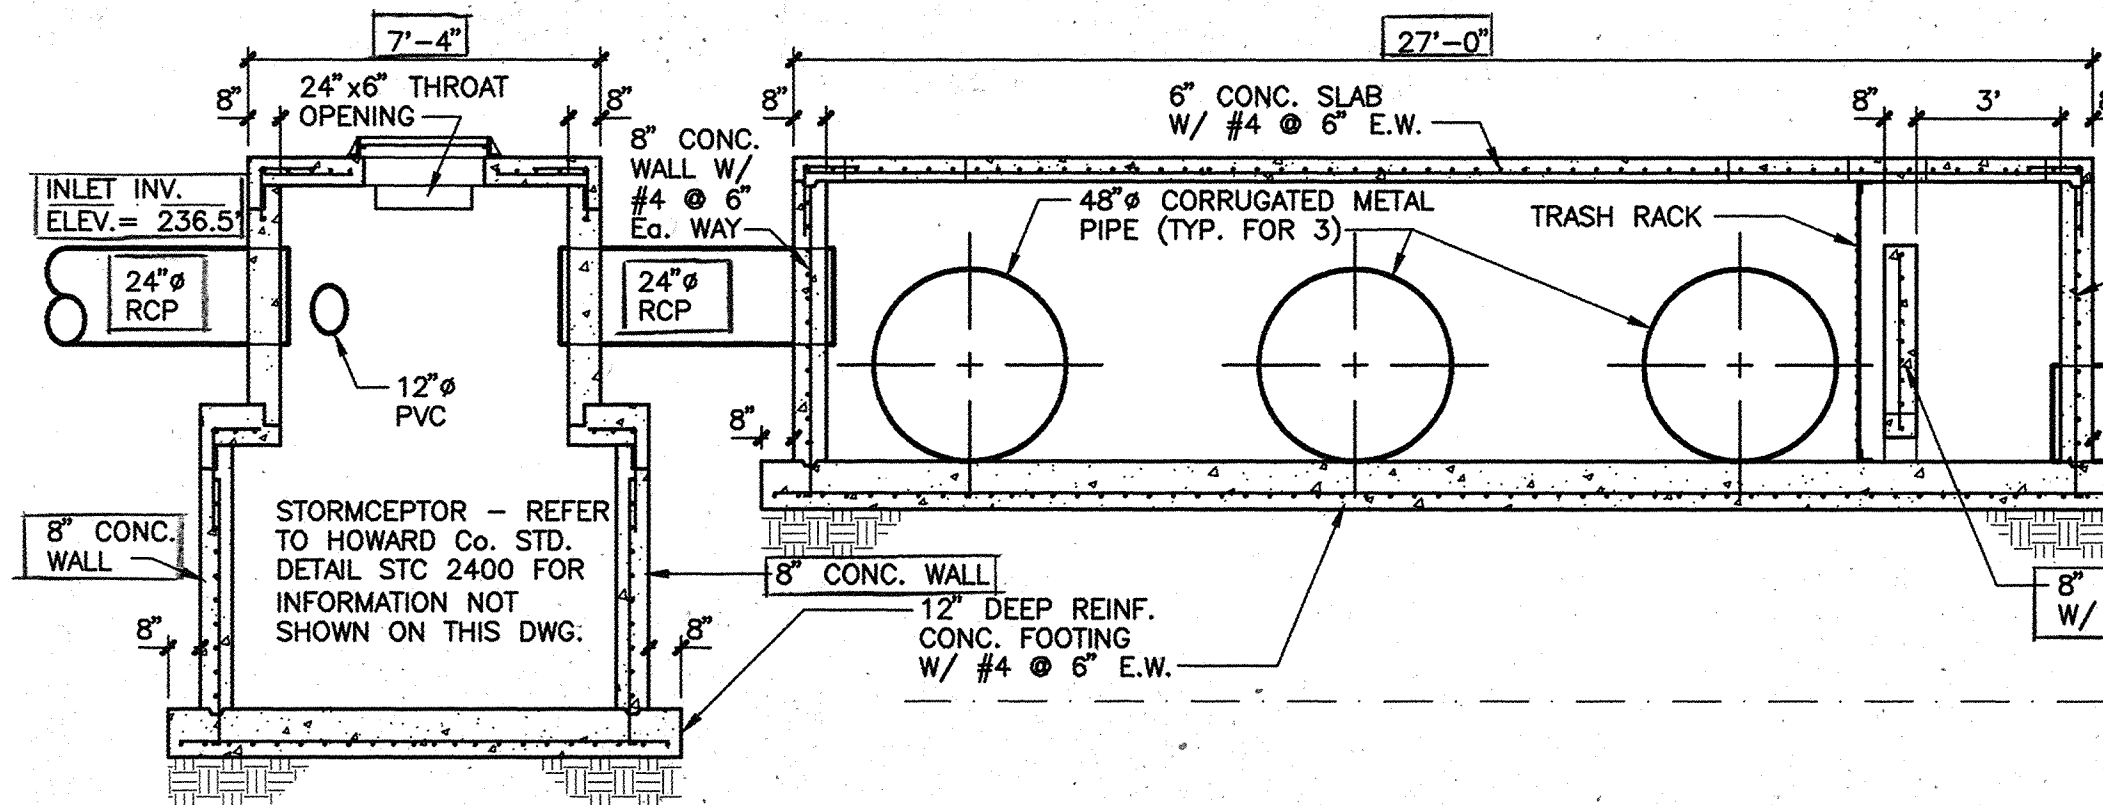


**JUNCTION BOX No. 4 - LONGITUDINAL SECTION**

SCALE: 1/4"=1'-0"

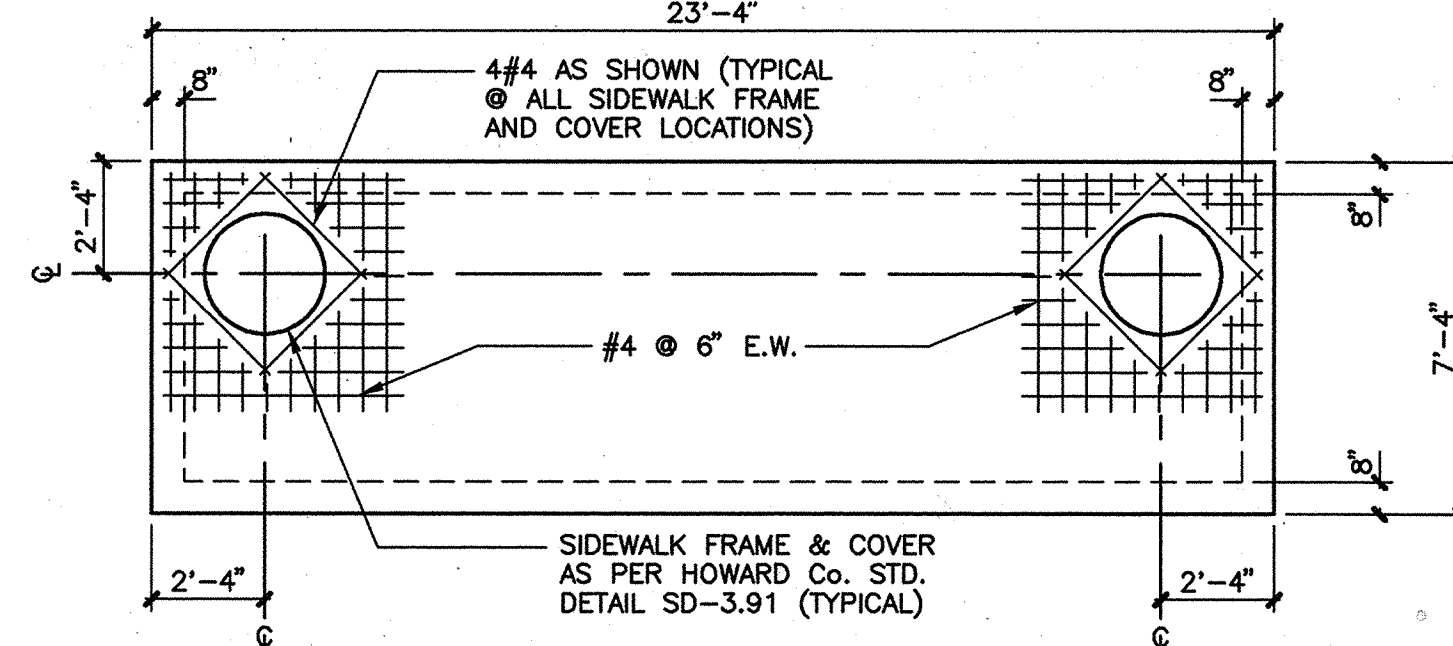

**JUNCTION BOX No. 5 - TOP SLAB DETAIL**

SCALE: 1/4"=1'-0"

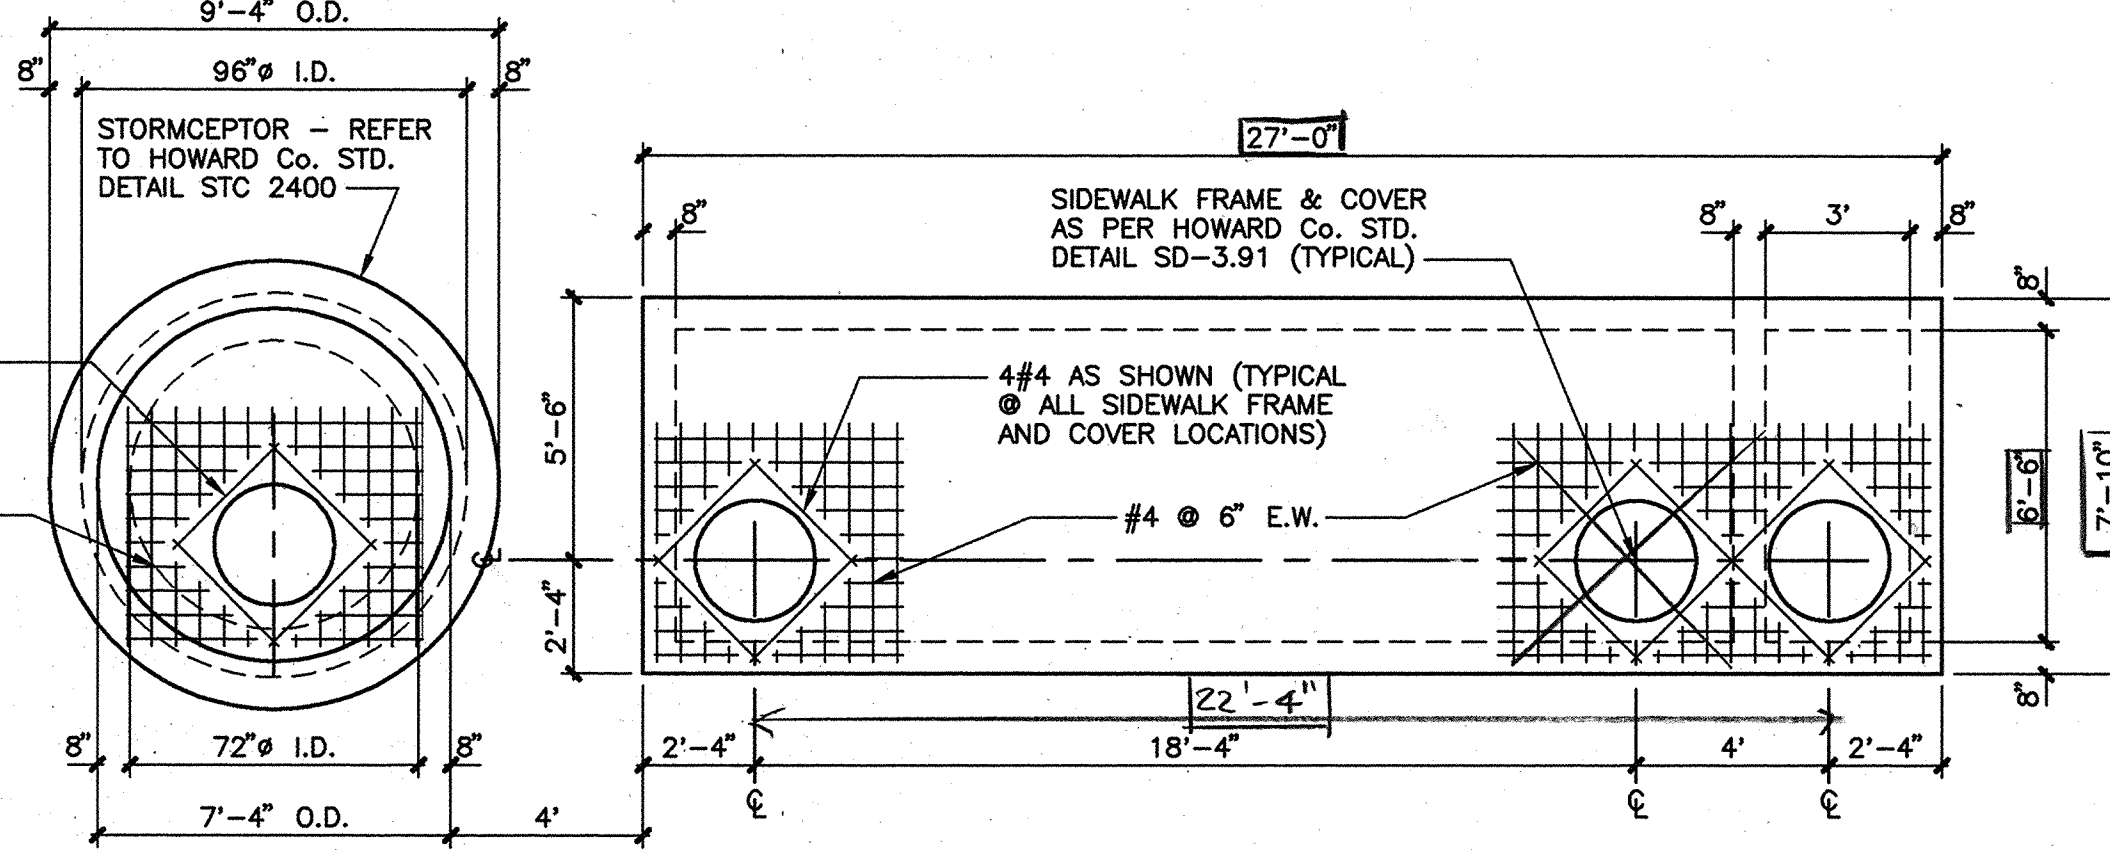

**JUNCTION BOX No. 4 - TOP SLAB DETAIL**

SCALE: 1/4"=1'-0"


**UNDERGROUND PIPE STORAGE (PRIVATE)**

**SPECIFICATIONS FOR CONSTRUCTION**

1. CONTRACTOR SHALL SUBMIT SHOP DRAWINGS TO ENGINEER AND HOWARD COUNTY FOR APPROVAL PRIOR TO COMMENCING WORK.
2. ALL WORK SHALL BE PLACED ON UNDISTURBED SUBGRADE. ANY OVER-EXCAVATION SHALL BE BACKFILLED WITH CR-6 CRUSHED RUN AND COMPACTED TO 95% AASHTO UNDER DIRECTION OF ENGINEER. NO CONSTRUCTION SHALL BE PLACED ON WET OR FROZEN GROUND.
3. ALL WELDING SHALL BE DONE BY MANUFACTURER'S WELDER. WELDS SHALL BE WATERPROOFED PRIOR TO BACKFILLING AND FINAL INSPECTION.
4. ALL STEEL USED FOR STORAGE STRUCTURE SHALL BE CORRUGATED STEEL ALUMINIZED PIPE, 12 GAUGE.
5. THE CONTRACTOR SHALL GUARANTEE TOTAL RUST-PROOFING OF THE STEEL PIPE.
6. PIPES SHALL BE BEDDED IN 12" OF SAND.
7. MINIMUM COVER SHALL BE 18".


**NOTES**

1. REFER TO ARMCO, INC. METAL PRODUCTS DIVISION (OR EQUAL AND APPROVED) FOR LOCATIONS OF WELDED CONNECTIONS.
2. SHOP DRAWINGS TO BE SUBMITTED TO HOWARD COUNTY AND THE ENGINEER PRIOR TO CONSTRUCTION.

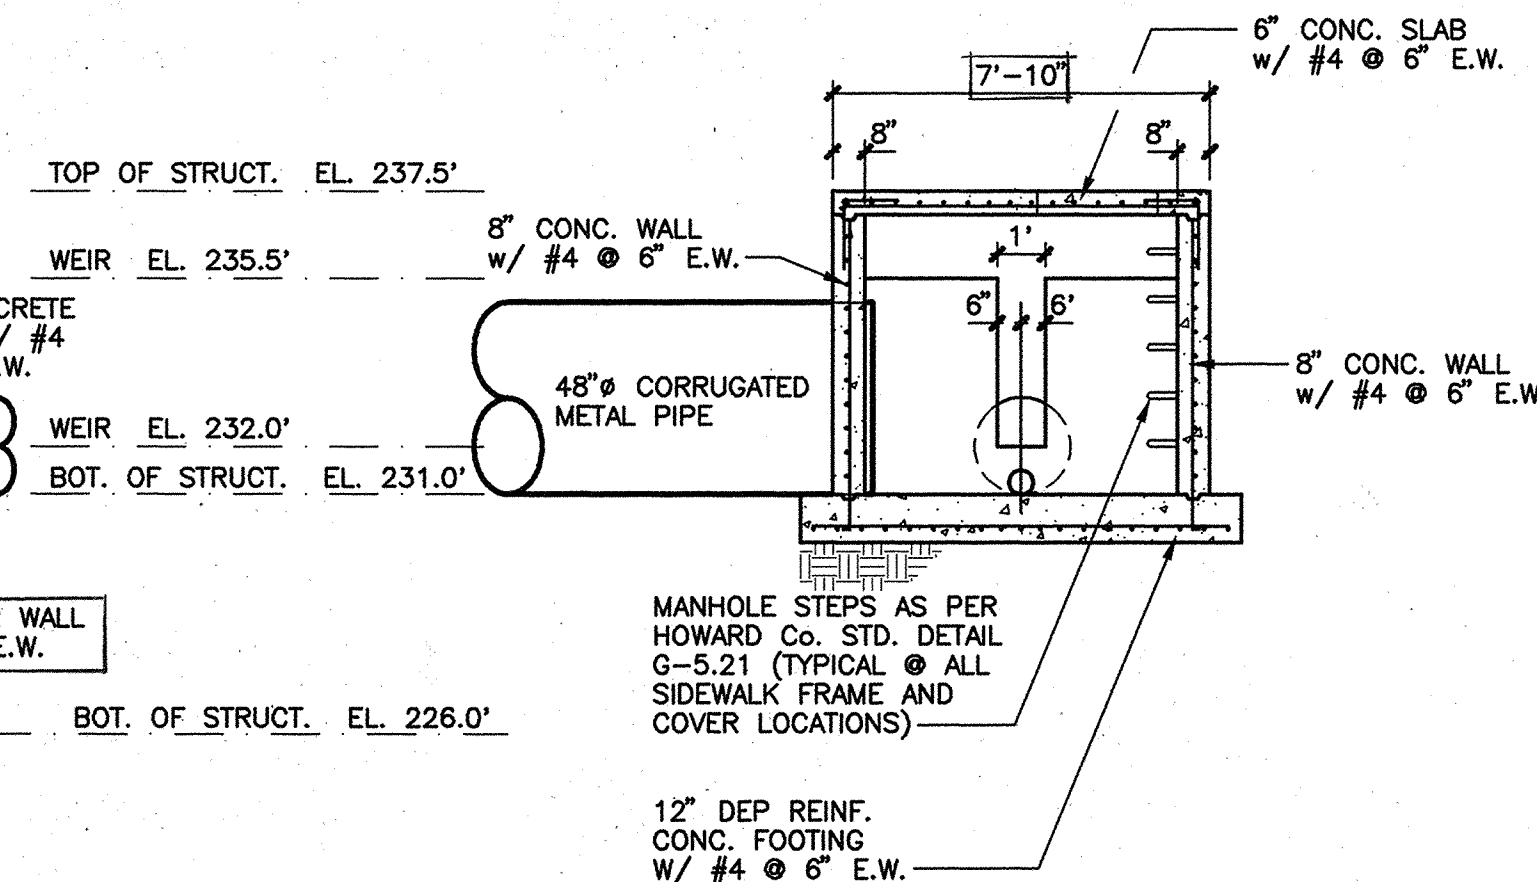


**JUNCTION BOX No. 4 - CROSS SECTION**

SCALE: 1/4"=1'-0"

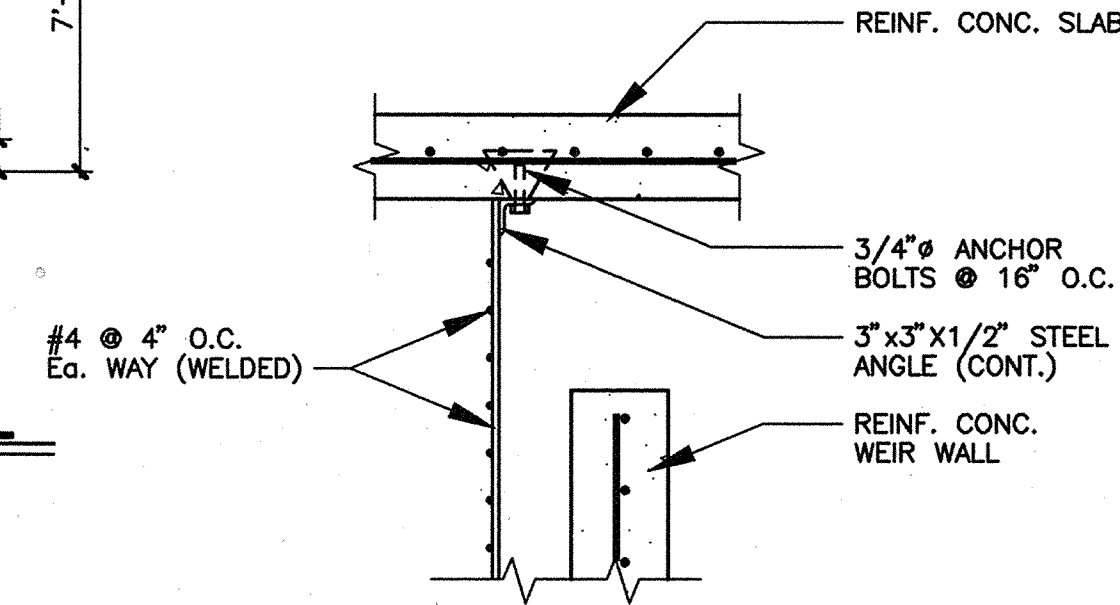


**DETAIL - TRASH RACK**

SCALE: 3/4"=1'-0"

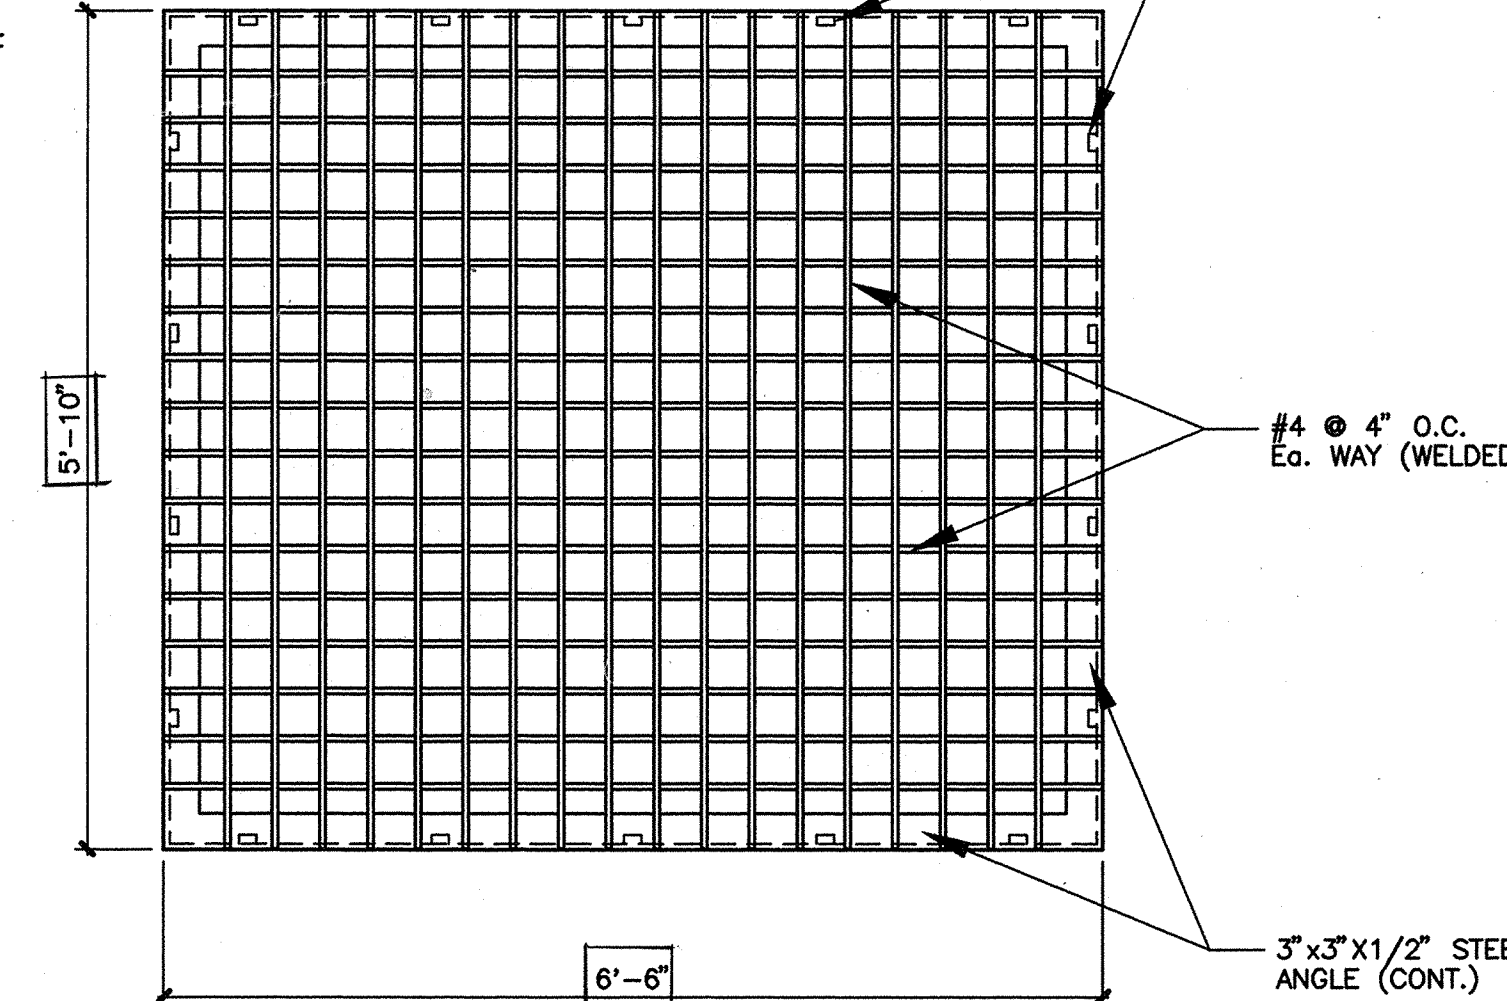

**ELEVATION - TRASH RACK**

SCALE: 3/4"=1'-0"

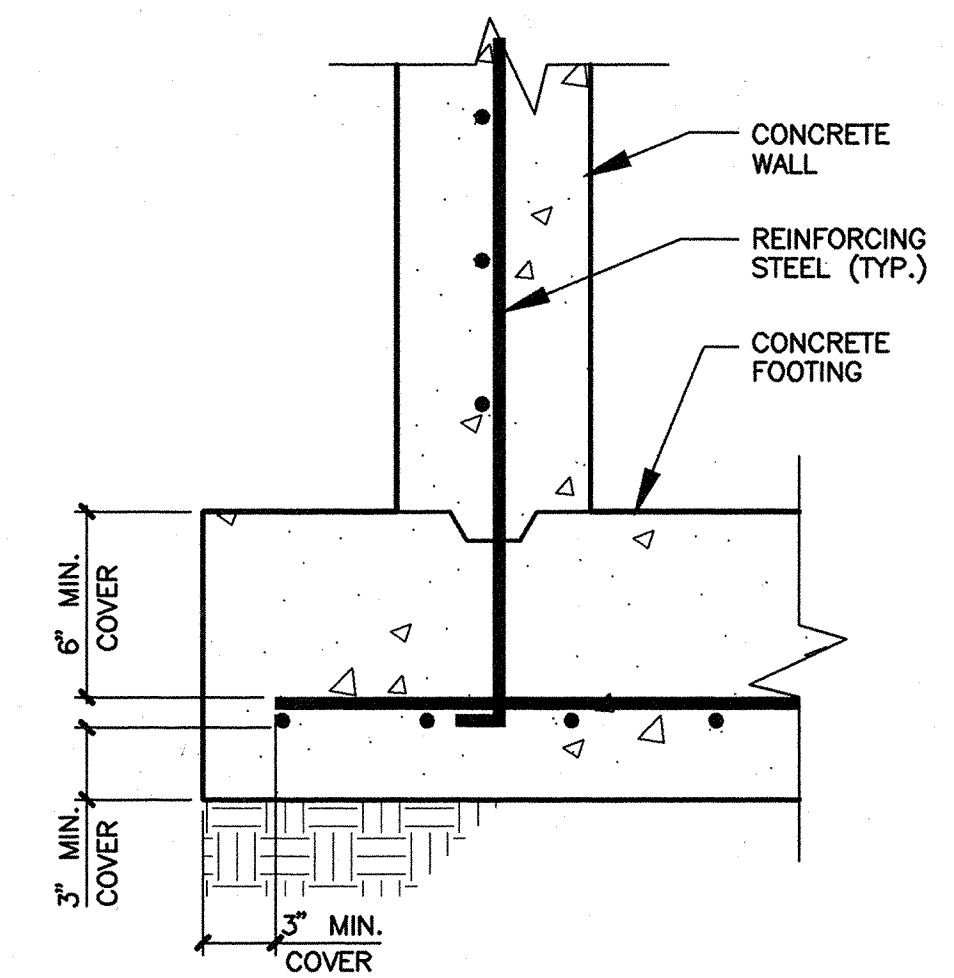

**TYPICAL FOOTING DETAIL**

NO SCALE

**BY THE DEVELOPER:**

I/WE CERTIFY THAT ALL DEVELOPMENT AND/OR CONSTRUCTION WILL BE DONE IN ACCORDANCE TO THESE PLANS AND THAT ANY RESPONSIBLE PERSONNEL INVOLVED IN THE CONSTRUCTION PROJECT WILL HAVE A CERTIFICATE OF ATTENDANCE AT A DEPARTMENT OF THE ENVIRONMENT APPROVED TRAINING PROGRAM FOR THE CONTROL OF SEDIMENT AND EROSION BEFORE BEGINNING THE PROJECT. I/WE WILL PROVIDE THE HOWARD COUNTY CONSERVATION DISTRICT WITH AN "AS-BUILT" PLAN OF THE PROJECT WITHIN 30 DAYS OF COMPLETION. I/WE ALSO AUTHORIZE PERIODIC ON-SITE INSPECTIONS BY THE HOWARD COUNTY CONSERVATION DISTRICT.

*Joseph Nazario*  
JOSEPH NAZARIO OWNER  
NAZARIO DEVELOPMENT AND COMPANY

5-1-98  
DATE

**BY THE ENGINEER:**

I/WE CERTIFY THAT THIS PLAN FOR POND CONSTRUCTION, SOIL EROSION AND SEDIMENT CONTROL REPRESENTS A PRACTICAL AND WORKABLE PLAN BASED ON MY PERSONAL KNOWLEDGE OF THE SITE CONDITIONS. THIS PLAN WAS PREPARED IN ACCORDANCE WITH THE REQUIREMENTS OF THE HOWARD COUNTY CONSERVATION DISTRICT. I HAVE ADVISED THE DEVELOPER THAT HE MUST PROVIDE THE HOWARD COUNTY CONSERVATION DISTRICT WITH AN "AS-BUILT" PLAN OF THE PROJECT WITHIN 30 DAYS OF COMPLETION.

*Fred L. Skelton*  
FRED L. SKELTON - MD. REGISTRATION No. 9070  
IPDS, LLC

6/6/98  
DATE

THESE PLANS HAVE BEEN REVIEWED FOR THE HOWARD COUNTY CONSERVATION DISTRICT AND MEET THE TECHNICAL REQUIREMENTS FOR SOIL EROSION AND SEDIMENT CONTROL.

*Carol Simmons* 9/30/98  
U.S. SOIL CONSERVATION SERVICE  
DATE

THESE PLANS FOR SOIL EROSION AND SEDIMENT CONTROL MEET THE REQUIREMENTS OF THE HOWARD COUNTY CONSERVATION DISTRICT.

*John R. Skelton* 9/30/98  
HOWARD COUNTY CONSERVATION DISTRICT  
DATE

APPROVED: HOWARD COUNTY DEPARTMENT OF PLANNING AND ZONING

*David Smith* 11/6/98  
DIRECTOR  
DATE

*Cindy Hamilton* 10/5/98  
CHIEF, DIVISION OF LAND-DEVELOPMENT  
DATE

*Mike D'Amico* 10/1/99  
CHIEF, DEVELOPMENT ENGINEERING DIVISION  
DATE

APPROVED: FOR PUBLIC WATER AND PUBLIC SEWERAGE, STORM DRAINAGE SYSTEMS AND PUBLIC ROADS.

*John R. Skelton*  
DIRECTOR  
DATE

CHIEF, BUREAU OF ENGINEERING  
DATE



**AS-BUILT CERTIFICATE**

*Fred L. Skelton*  
FRED L. SKELTON - MD. REGISTRATION No. 9070  
IPDS, LLC

03-14-01  
DATE

**OWNER \ DEVELOPER**

Joseph Nazario  
Nazario Development and Company  
6500 Ammendale Road  
Beltsville, Maryland 20705  
(301) 937-4664

802 Silgo Avenue  
Silver Spring,  
Maryland, 20910  
(301) 585-5676

**IPDS**

**STORMWATER MANAGEMENT  
DETAILS**

**U.S. No.1 JOINT VENTURE**  
PARCEL "A", PLAT CMP No. 3592, WAREHOUSE  
GUILFORD ELECTION DISTRICT No. 6  
HOWARD COUNTY, MARYLAND  
CENSUS TRACT 8089.02, TAX MAP 47, BLOCK 22/23  
WATER CODE C04, SEWER CODE 7220000

AS NOTED

SCALE:

06-18-98

REVISIONS:

01-18-98

DATE:

JOB NUMBER:

SHEET 10 OF 13

**SWM-3**

SDP-98-135


SDP-98-135







ADJACENT PROPERTY OWNERS	
PROPERTY	OWNER
KINGS WOODS SECTION 1, AREA 1 LOT 6	GARY KUYKENDALL 9536 GLEN RIDGE DR. LAUREL, MARYLAND 20723
KINGS WOODS SECTION 1, AREA 1 LOT 7	MELANIE MCKNIGHT 9540 GLEN RIDGE DR. LAUREL, MARYLAND 20723
KINGS WOODS SECTION 1, AREA 1 LOT 8	THEREY BREANT 9544 GLEN RIDGE DR. LAUREL, MARYLAND 20723
KINGS WOODS SECTION 1, AREA 1 LOT 9	HEN V. ONG 9548 GLEN RIDGE DR. LAUREL, MARYLAND 20723
KINGS WOODS SECTION 1, AREA 1 LOT 10	ROBERT MARTINEZ 9552 GLEN RIDGE DR. LAUREL, MARYLAND 20723
KINGS WOODS SECTION 1, AREA 1 LOT 40	HOWARD COUNTY DEPARTMENT OF RECREATION AND PARKS
CMP 588/166 TAX MAP 47	BALTIMORE GAS & ELECTRIC Co. P.O. BOX 1475 BALTIMORE, MARYLAND 21203-1475
U.S. No. 1 JOINT VENTURE PARCEL "E"	LYNN BUFF LIMITED PARTNERS 9550 LYNN BUFF CT. LAUREL, MARYLAND 20723-6324
U.S. No. 1 JOINT VENTURE PARCEL "C"	STEFINTRACO A. SWISS CORPORATION c/o GREGORY PNEIL 8401 CONNECTICUT AVE. CHEVY CHASE, MARYLAND 20815

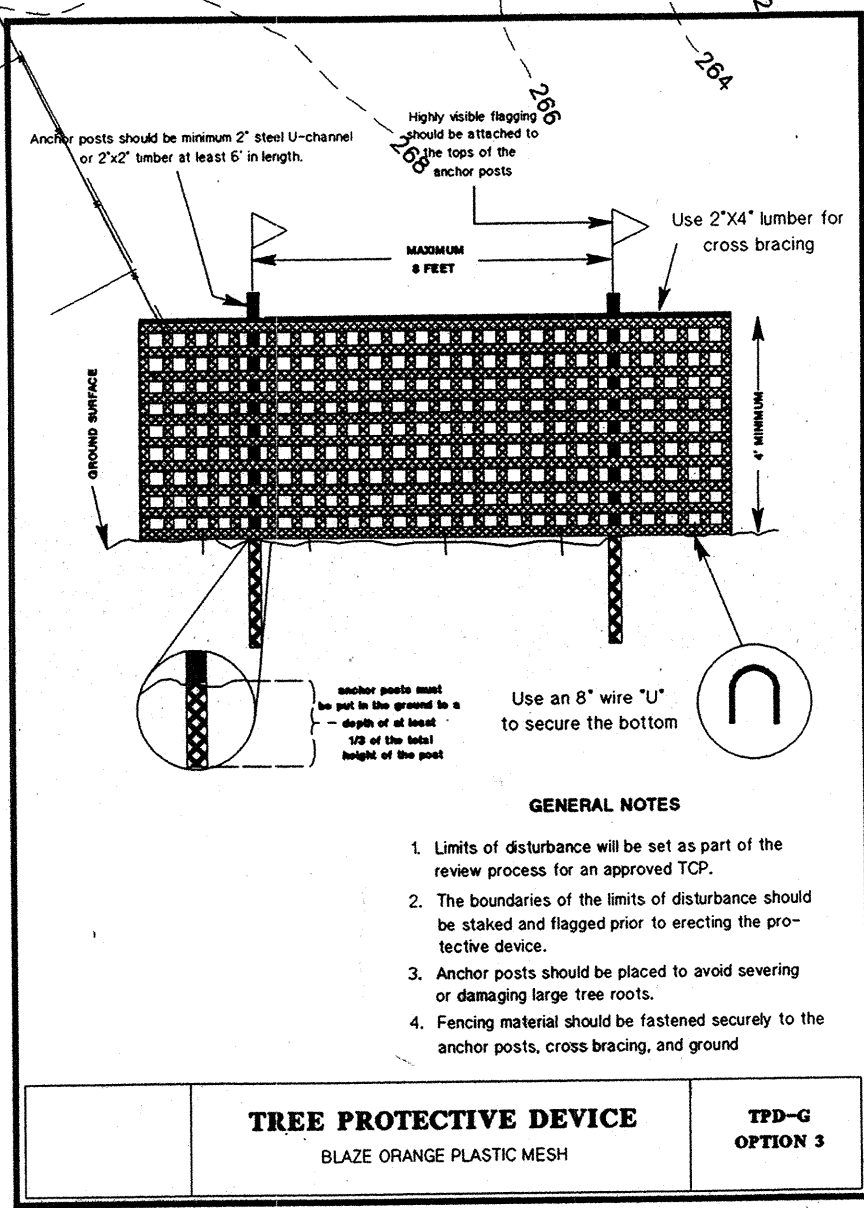

**TYPICAL ON-SITE PAVING SECTION No. P-3**  
SCALE: 1 1/2"=1'-0"

#### GENERAL PAVING NOTES

- All roadway construction shall be in accordance with the General Specifications for Highway and Street Construction, the Howard County Code and the Howard County Road Ordinance.
- Information concerning underground utilities was obtained from available records, but the contractor must determine the exact location and elevation of the mains by digging test pits by hand at utility crossings well in advance of trenching. If clearances to water and sewer lines are less than shown on this plan or twelve (12) inches, contact the Engineer before proceeding with construction.
- All elevations shown on these plans are referred to Maryland State and Howard County vertical datum.
- All roadway fillet radii shall be 25 feet, unless otherwise noted.
- All unpaved areas within the property or right-of-way shall be sodded.
- All curb and gutter shall be in accordance with Howard County Standard No. R-3.01.
- All sidewalks shall be in accordance with Howard County Standard No. R-3.05, unless otherwise noted.
- Provide Standard No. R-4.01 sidewalk ramps Type A at locations shown on the plans.
- The pavement subgrade is to be approved by the Howard County Inspector prior to installation of Base Course.
- Underdrain system shall be installed when warranted by field conditions or as required by the Howard County Inspector.

CURVE DATA				
No.	Radius	Delta	Arc	Chord
1	60.00'	105°39'13"	110.84'	79.12'

NOTE: FOR ADDITIONAL PARKING LOT AND SIDEWALK GRADING INFORMATION REFER TO SHEET "SDP-3".



#### LEGEND

DESCRIPTION	EXISTING	PROPOSED
PROPERTY LINE	---	---
TREELINE	---	---
CONTOUR LINE	---	---
SPOT ELEVATION	---	+
STORMDRAIN PIPE	---	---
LIMIT OF DISTURBANCE	---	---
SILT FENCE	---	---
HANDICAPPED SPACE	---	---
FIRE HYDRANT	---	---
CURB & GUTTER	---	---
WHEELCHAIR RAMP	---	---
TOP OF WALL	---	---
BOTTOM OF WALL	---	---
WATER METER VAULT (3/4" METER & 1" WHC)	---	---
SITE LIGHTING FIXTURE MOUNTED ON BLDG.	---	---

**OWNER \ DEVELOPER**  
Joseph Nazario  
Nazario Development and Company  
8500 Ammendale Road  
Beltsville, Maryland 20705  
(301) 937-4664

**SDP-98-135**

SDP-98-135

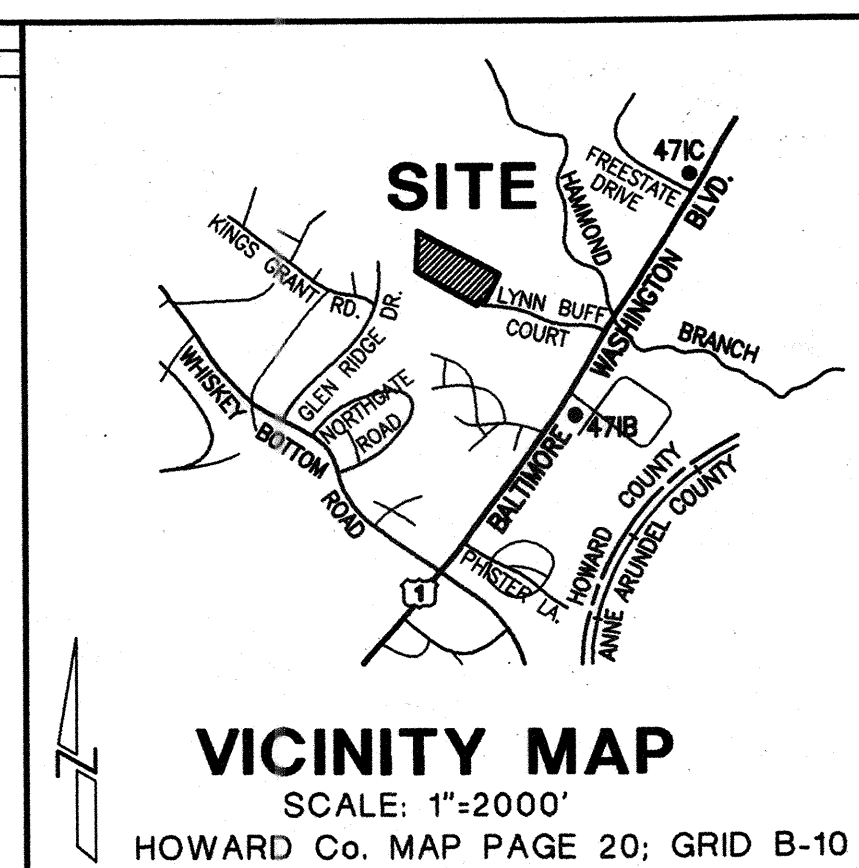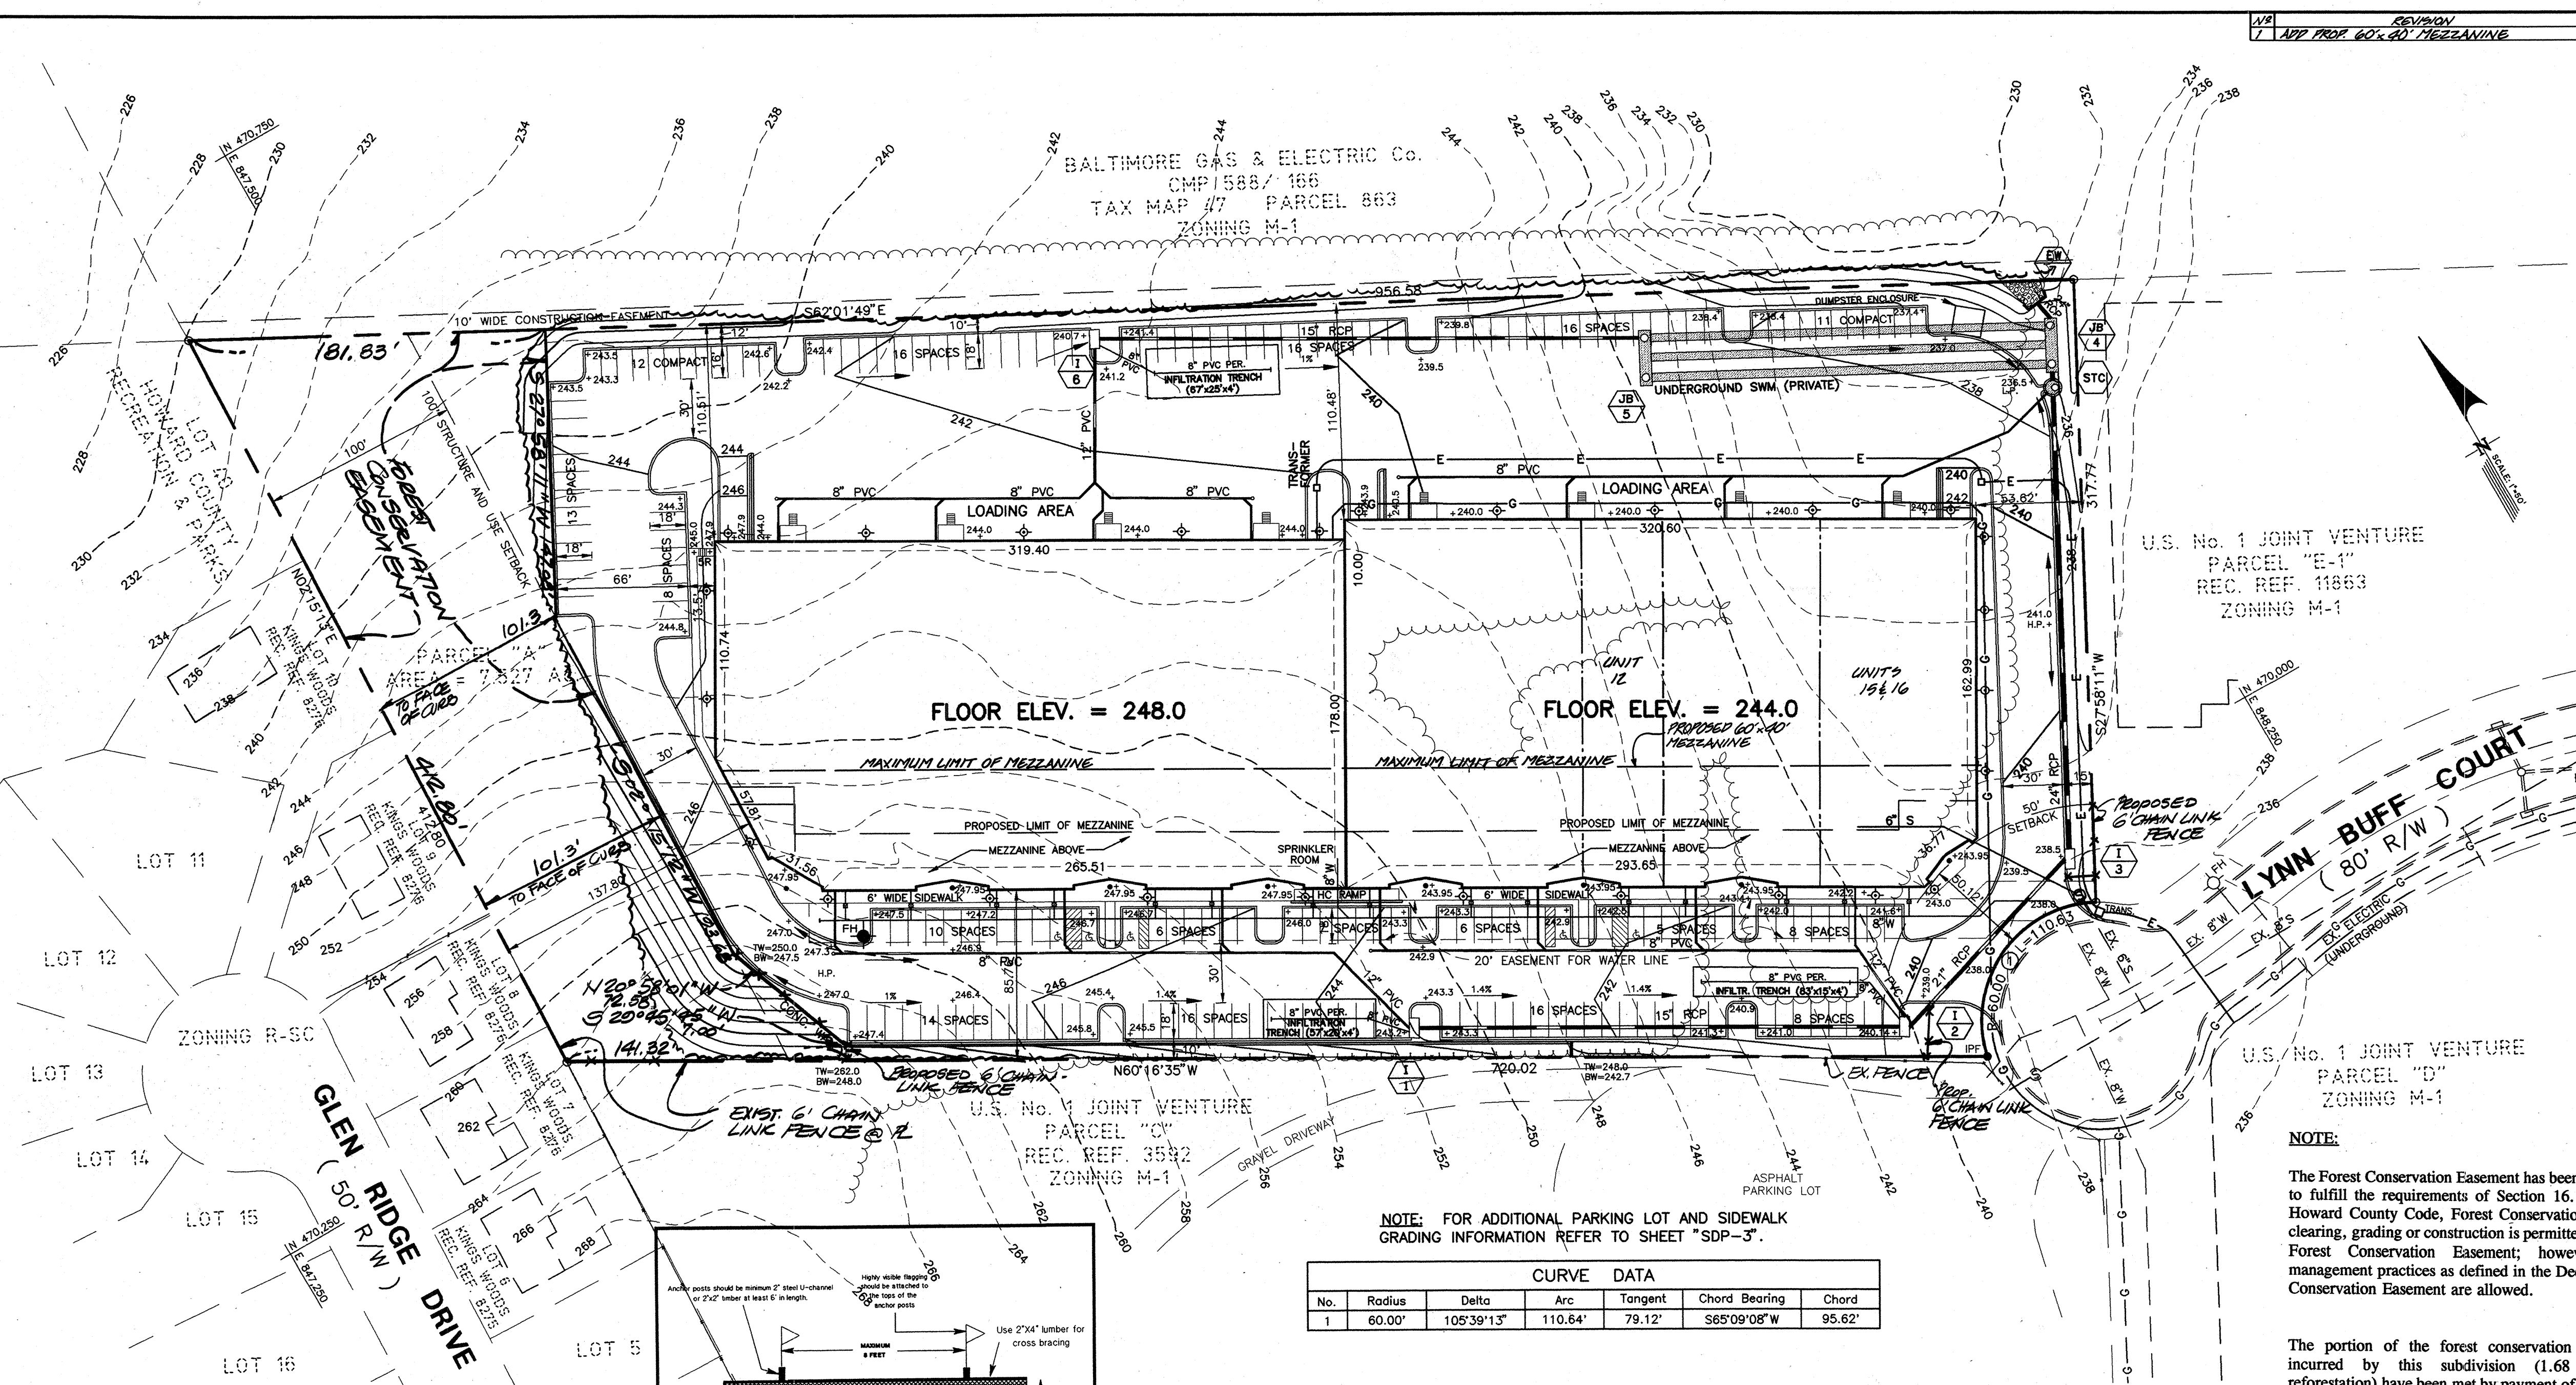

BY THE DEVELOPER:  
I/WE CERTIFY THAT ALL DEVELOPMENT AND/OR CONSTRUCTION WILL BE DONE IN ACCORDING TO THESE PLANS AND THAT ANY RESPONSIBLE PERSONNEL INVOLVED IN THE CONSTRUCTION PROJECT WILL HAVE A CERTIFICATE OF ATTENDANCE AT A DEPARTMENT OF THE ENVIRONMENT APPROVED TRAINING PROGRAM FOR THE CONTROL OF SEDIMENT AND EROSION BEFORE BEGINNING THE PROJECT. I/WE WILL PROVIDE THE HOWARD SOIL CONSERVATION DISTRICT WITH AN AS-BUILT PLAN OF THE PROJECT WITHIN 90 DAYS OF COMPLETION. I/WE ALSO AUTHORIZE PERIODIC ON-SITE INSPECTIONS BY THE HOWARD SOIL CONSERVATION DISTRICT.

JOSEPH NAZARIO, OWNER  
NAZARIO DEVELOPMENT AND COMPANY  
5-1-98  
DATE

BY THE ENGINEER:  
I/WE CERTIFY THAT THIS PLAN FOR FOND CONSTRUCTION, SOIL EROSION AND SEDIMENT CONTROL REPRESENTS A PRACTICAL AND WORKABLE PLAN BASED ON MY PERSONAL KNOWLEDGE OF THE SITE CONDITIONS. THIS PLAN WAS PREPARED IN ACCORDANCE WITH THE REQUIREMENTS OF THE HOWARD SOIL CONSERVATION DISTRICT. I HAVE NOTICED THE DEVELOPER THAT HE MUST PROVIDE THE HOWARD SOIL CONSERVATION DISTRICT WITH AN AS-BUILT PLAN OF THE PROJECT WITHIN 90 DAYS OF COMPLETION.

FRED L. SKELTON - MD. REGISTRATION NO. 8070  
IPDS, LLC  
6/5/98  
DATE

THESE PLANS SOIL EROSION AND SEDIMENT CONTROL MEET THE REQUIREMENTS OF THE HOWARD SOIL CONSERVATION DISTRICT.

Clayton Simmons 9/30/98  
NATURAL RESOURCES CONSERVATION SERVICE  
DATE

THESE PLANS HAVE BEEN REVIEWED FOR THE HOWARD SOIL CONSERVATION DISTRICT AND MEET THE TECHNICAL REQUIREMENTS FOR SOIL EROSION AND SEDIMENT CONTROL.


John R. Plutson 9/30/98  
HOWARD SOIL CONSERVATION DISTRICT  
DATE

APPROVED: HOWARD COUNTY DEPARTMENT OF PLANNING AND ZONING

10/6/98  
DATE

10/5/98  
DATE

10/1/99  
DATE

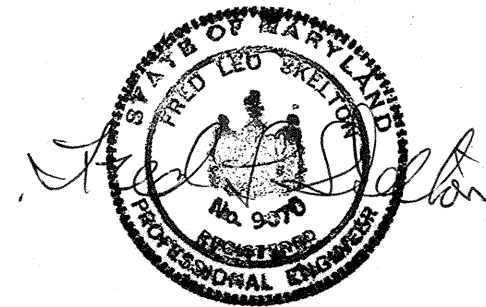

**IPDS**  
The Interprofessional  
PLANNING & DESIGN STUDIO, LLC  
Engineers • Architects • Surveyors  
Planners & Landscape Architects  
802 Silgo Avenue  
Silver Spring, Maryland, 20910  
(301) 585-5676

**SITE DEVELOPMENT PLAN**

**U.S. No. 1 JOINT VENTURE**  
PARCEL "A", PLAT CMP No. 3592, WAREHOUSE  
GUILFORD ELECTION DISTRICT No. 6  
HOWARD COUNTY, MARYLAND  
CENSUS TRACT 8069.02, TAX MAP 47, BLOCK 22/23  
WATER CODE C04, SEWER CODE 7220000

1"=50'

07-13-98  
06-18-98

12-18-97

JOB NUMBER:

**SDP-1**

SHEET 2 OF 13